

PASCO COUNTY, FLORIDA
UTILITIES DEPARTMENT
PLANS OF PROPOSED
MADISON STREET RECLAIMED
WATERMAIN EXTENSION
RECORD DRAWING
PASCO COUNTY UTILITIES NO. 19-005.00



THIS CONTRACT PLAN SET INCLUDES:
RECLAIMED WATERMAIN UTILITY PLANS


INDEX OF PLANS

SHEET NO.	SHEET DESCRIPTION
1	COVER SHEET
2	GENERAL NOTES
3	KEY SHEET INDEX & LEGEND
4-5	DEMOLITION & RESTORATION PLANS
6-14	PLAN AND PROFILES
15-16	DETAILS

ATTENTION IS DIRECTED TO THE FACT THAT THESE PLANS MAY HAVE BEEN REDUCED IN SIZE BY REPRODUCTION. THIS MUST BE CONSIDERED WHEN OBTAINING SCALED DATA.

PASCO COUNTY BOARD OF COUNTY COMMISSIONERS


CHAIRMAN OF THE BOARD :MIKE MOORE
DISTRICT 1 : RON OAKLEY
DISTRICT 2 : MIKE MOORE
DISTRICT 3 : KATHRYN STARKEY
DISTRICT 4 : MIKE WELLS
DISTRICT 5 : JACK MARIANO
COUNTY ADMINISTRATOR : DAN BILES

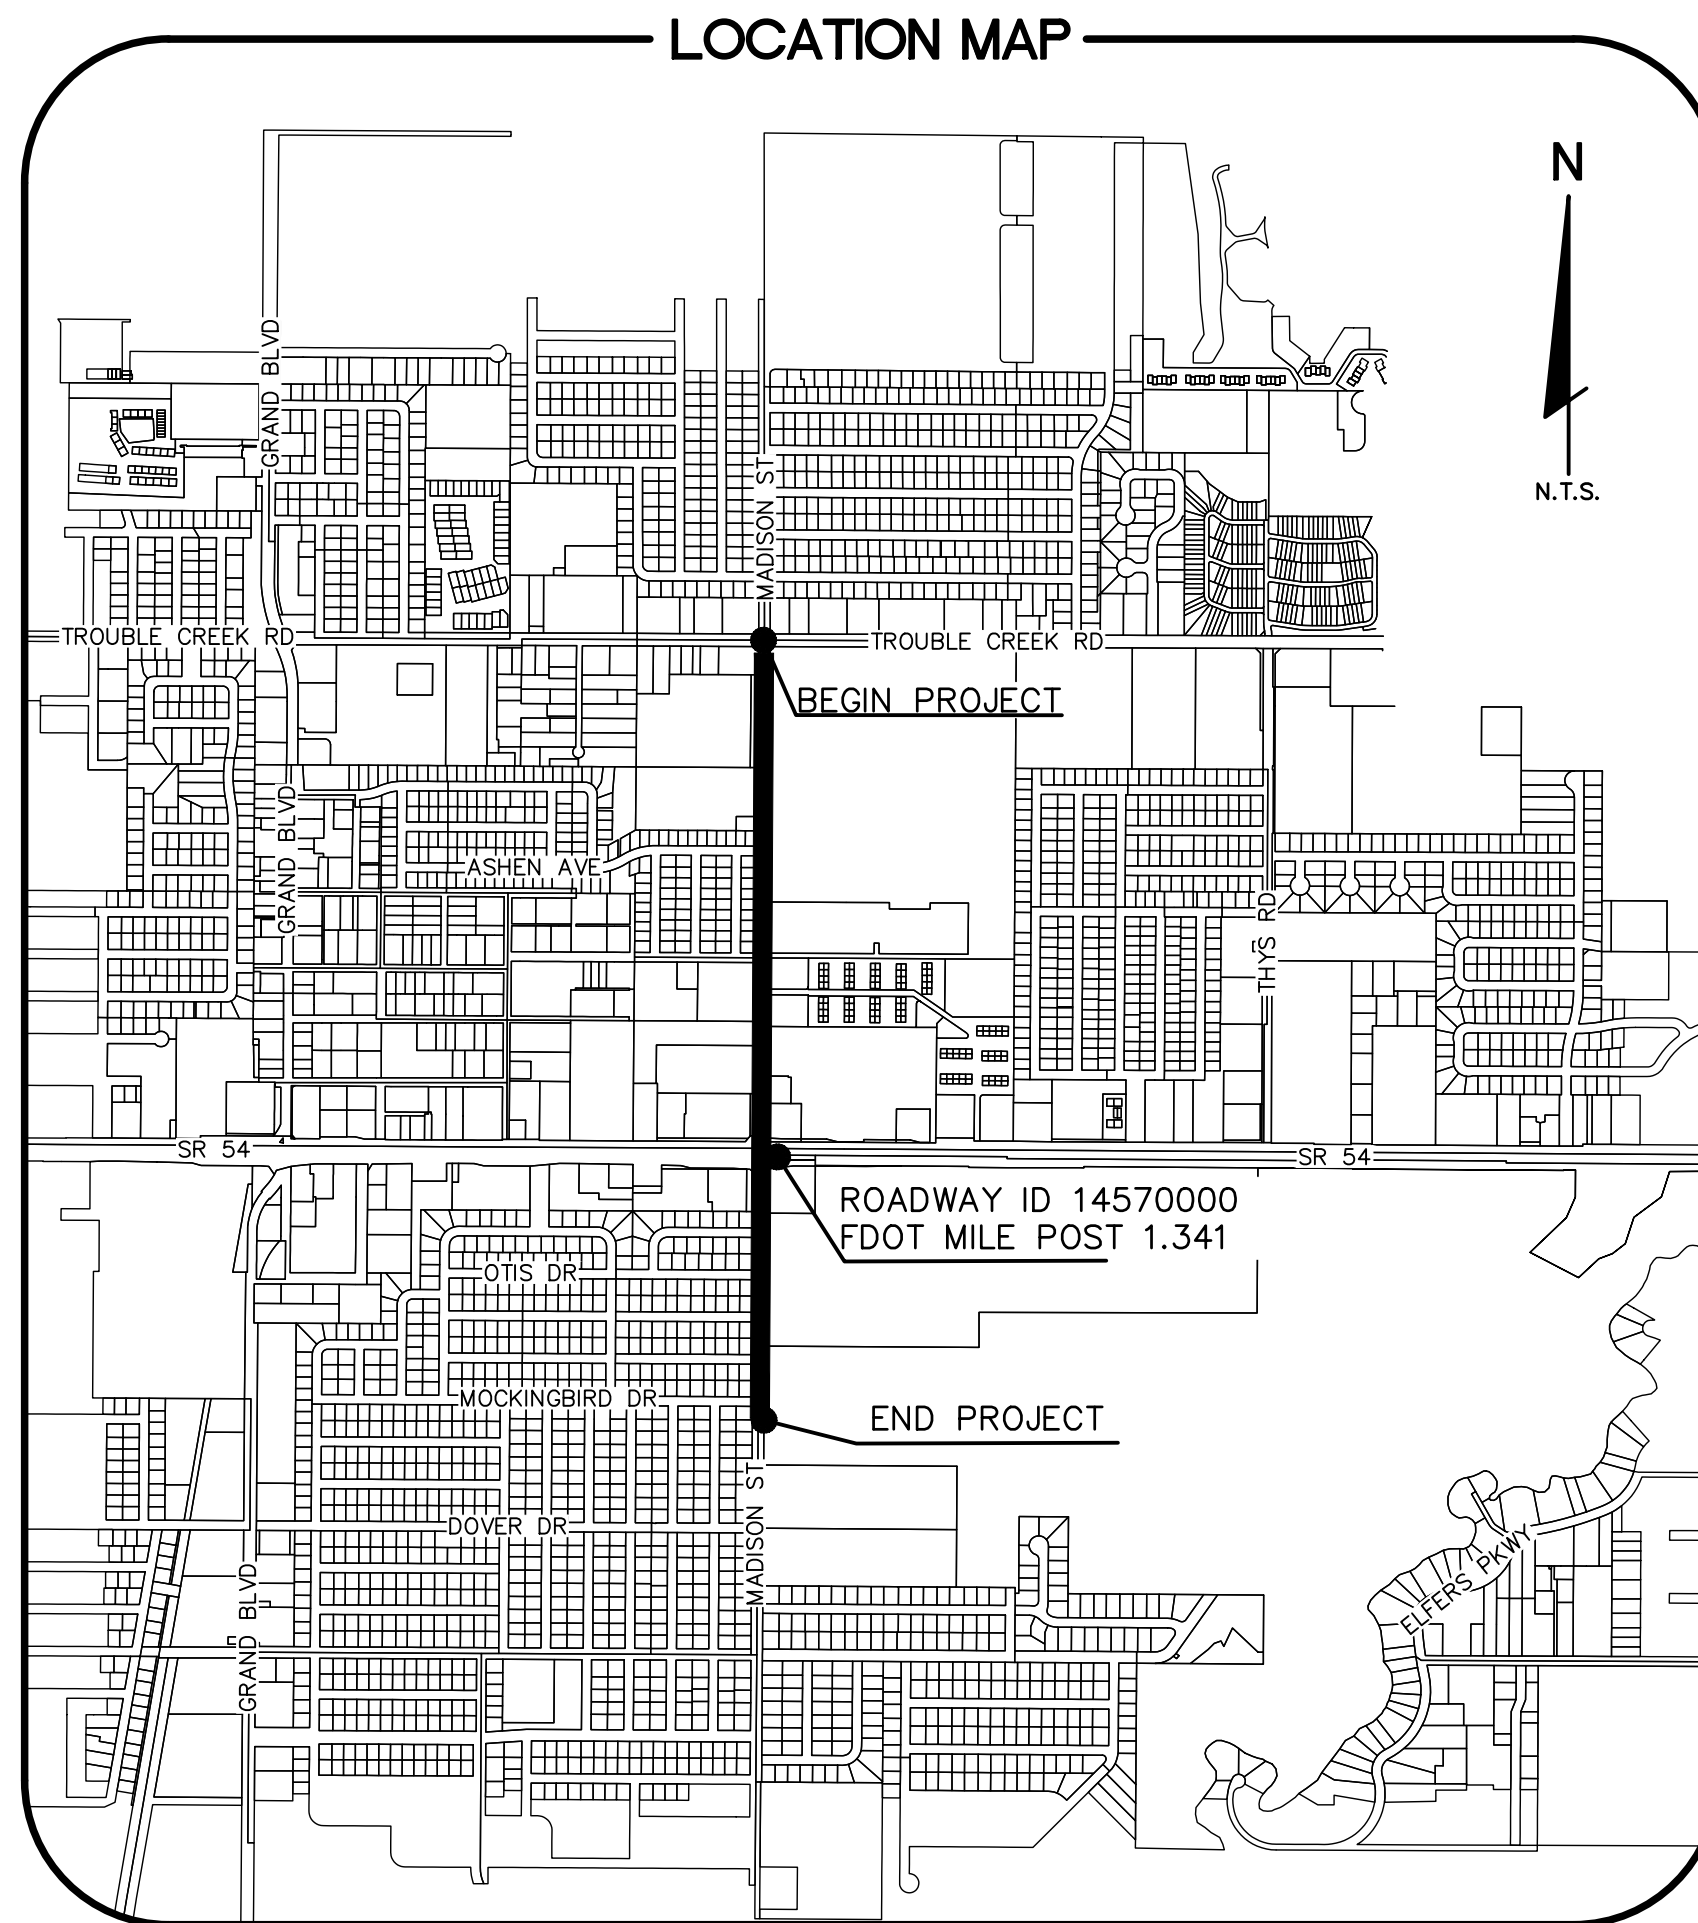

PASCO COUNTY, FLORIDA
UTILITIES DEPARTMENT
19420 CENTRAL BLVD.
LAND O' LAKES, FL 34637
PHONE: (813) 235-6189 FAX: (813) 929-1067

James P Choncholas
Digitally signed by James P Choncholas
Date: 2021.07.19 10:27:31 -04'00'

MAP OF PASCO COUNTY, FLORIDA

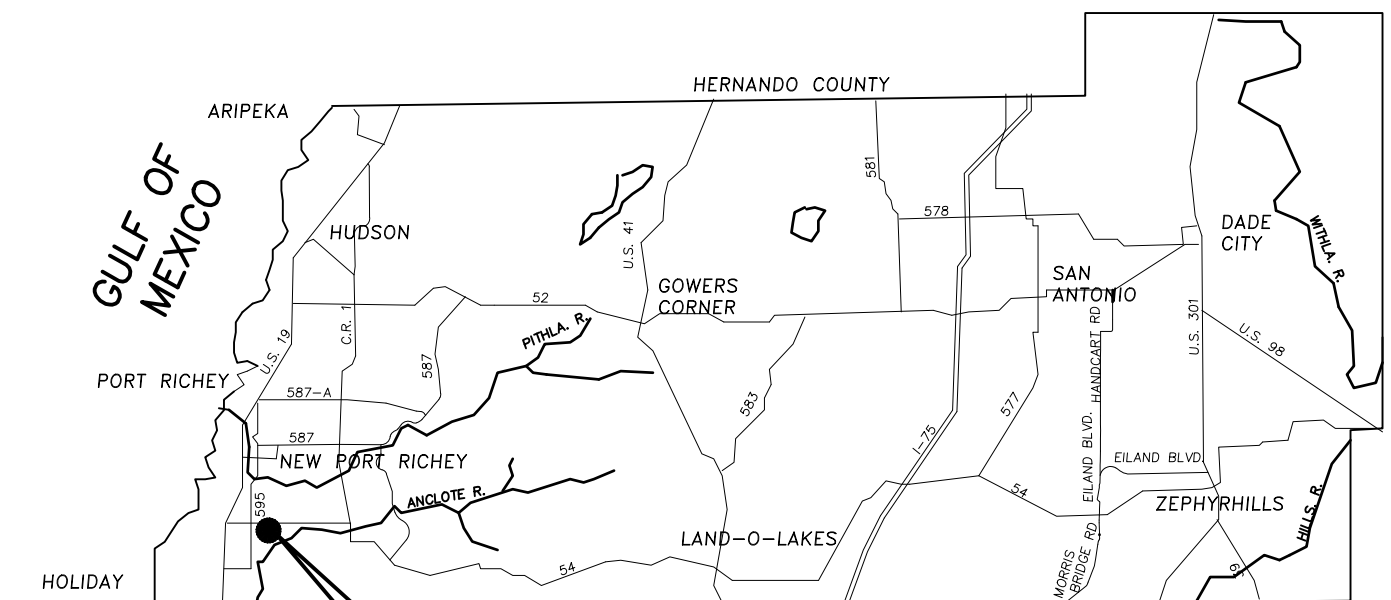

LOCATION OF PROJECT

SET REVISIONS

NO.	DATE	BY	DESCRIPTION

PASCO COUNTY PROJECT COORDINATOR: IVAN MARTINEZ. P.E.



Know what's below.
Call before you dig.
FLA. STATUTE 553.851 (1979) REQUIRES A MIN. OF 2 DAYS
AND A MAX. OF 5 DAYS NOTICE BEFORE YOU EXCAVATE.

RECORD DATA LEGEND

DATA = RECORD DATA ADDED TO CONSTRUCTION PLANS
RECORD DESIGN = RECORD DATA DIFFERS FROM DESIGN DATA
✓ = RECORD DATA MATCHES DESIGN DATA
XXX = NOT CONSTRUCTED

Record Drawing Note:
These Record Drawings have been compiled utilizing selected field determined elevations, as noted on the plans, along with Contractor furnished data noting deviations made during the Construction Phase.

RECORD DRAWING

100% PLANS
APRIL 20, 2020

JAMES PAUL CHONCHOLAS, STATE OF FLORIDA PROFESSIONAL ENGINEER, LICENSE NO. 45175
THIS ITEM HAS BEEN DIGITALLY SIGNED AND SEALED BY JAMES PAUL CHONCHOLAS, P.E. ON THE DATE INDICATED HERE.
DIGITAL SIGNATURE (SHA1) THUMBPRINT F3 78 3F 27 83 CE B8 A0 F7 79 C9 30 F0 9F A6 48 86 54 53 43
PRINTED COPIES OF THIS DOCUMENT ARE NOT CONSIDERED SIGNED AND SEALED AND THE DIGITAL SIGNATURE MUST BE VERIFIED ON ANY ELECTRONIC COPIES.

DATE	BY	DATE	BY	DATE	BY
02-01-19	902	12-04-2019	JMD	JPC	JPC

NO.	DATE	DESCRIPTION


PASCO COUNTY, FLORIDA
19420 CENTRAL BLVD.
LAND O' LAKES, FLORIDA 34637
PHONE: (813) 235-6189 FAX: (813) 929-1067

PROJECT NAME
MADISON STREET
RECLAIMED WATERMAIN EXTENSION


SHEET NAME
COVER SHEET

FLORIDA DESIGN CONSULTANTS, INC.
THINK IT. ACHIEVE IT.
20525 AMBERFIELD DRIVE, SUITE 201, LAND O' LAKES, FLORIDA 34638
PHONE: (727) 849-7588 FAX: (727) 848-3648 WWW.FLDESIGN.COM C.A. NO. 7421

PLAN SET DATE	SHEET OF
July 19, 2021	1 OF 16

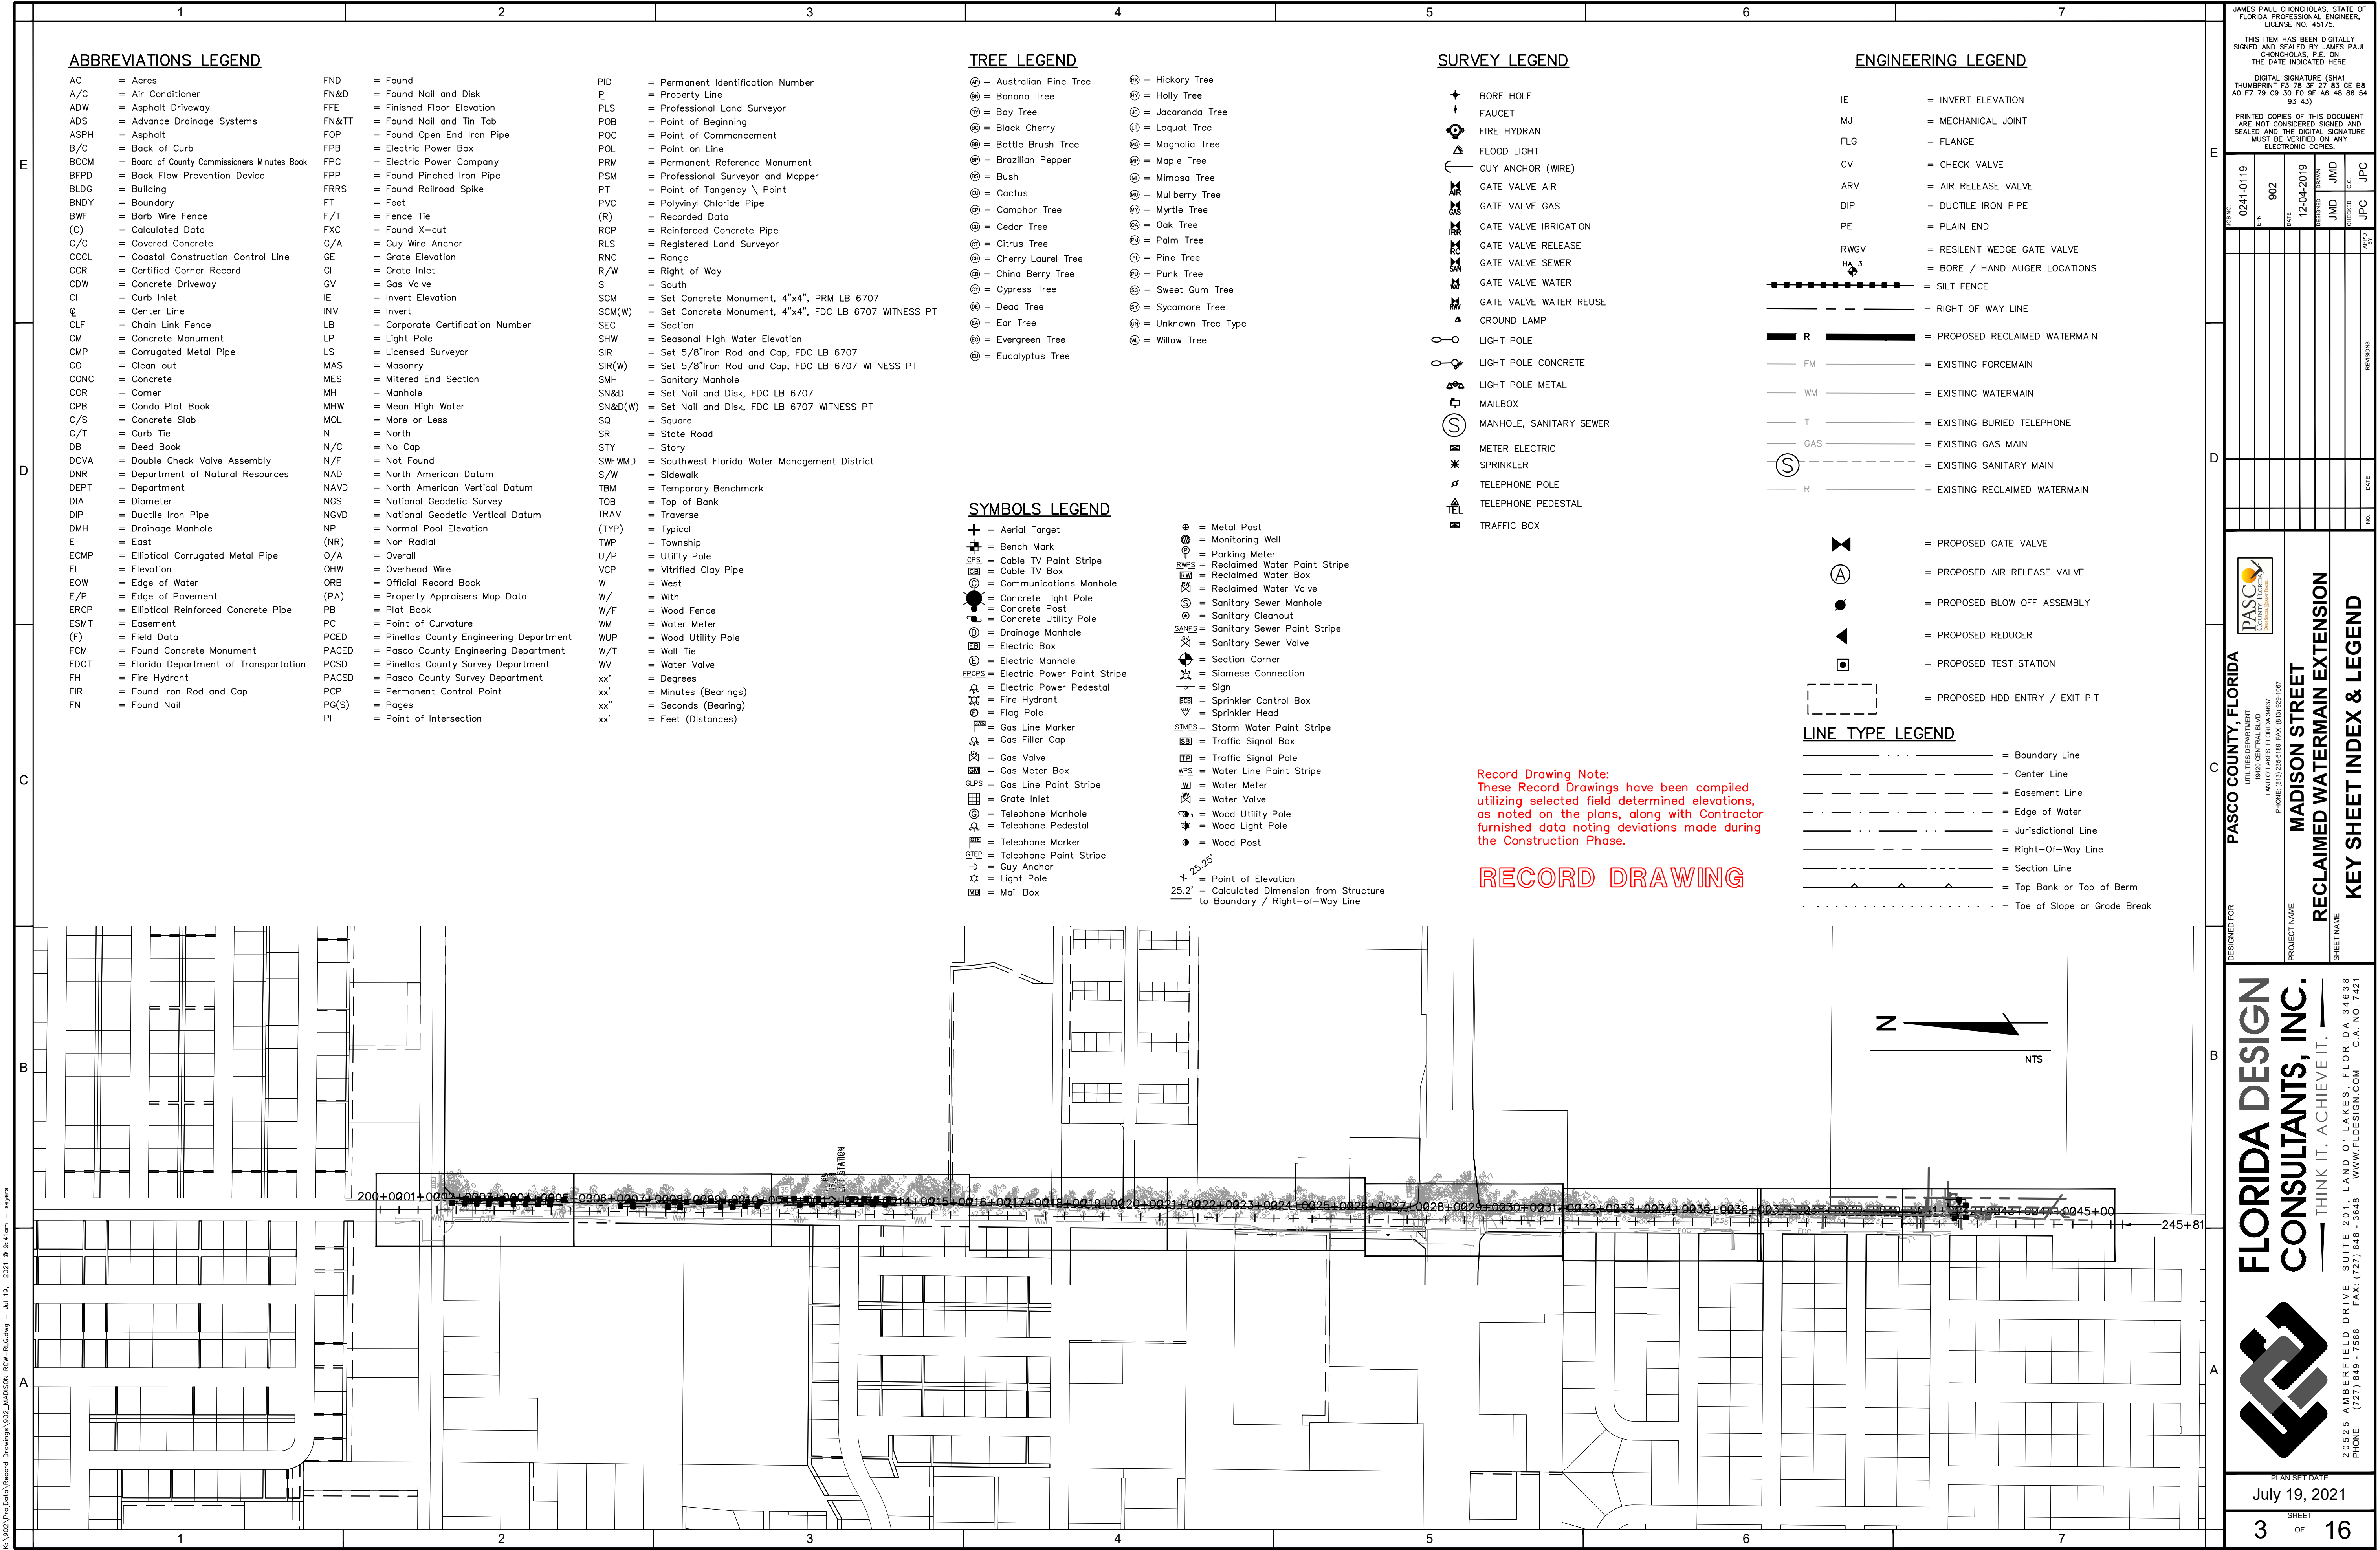

K:\9802\ProjData\Record Drawings\9802_MADISON ROW-RPP1.dwg - Jul 19, 2021 @ 9:43am - seyers

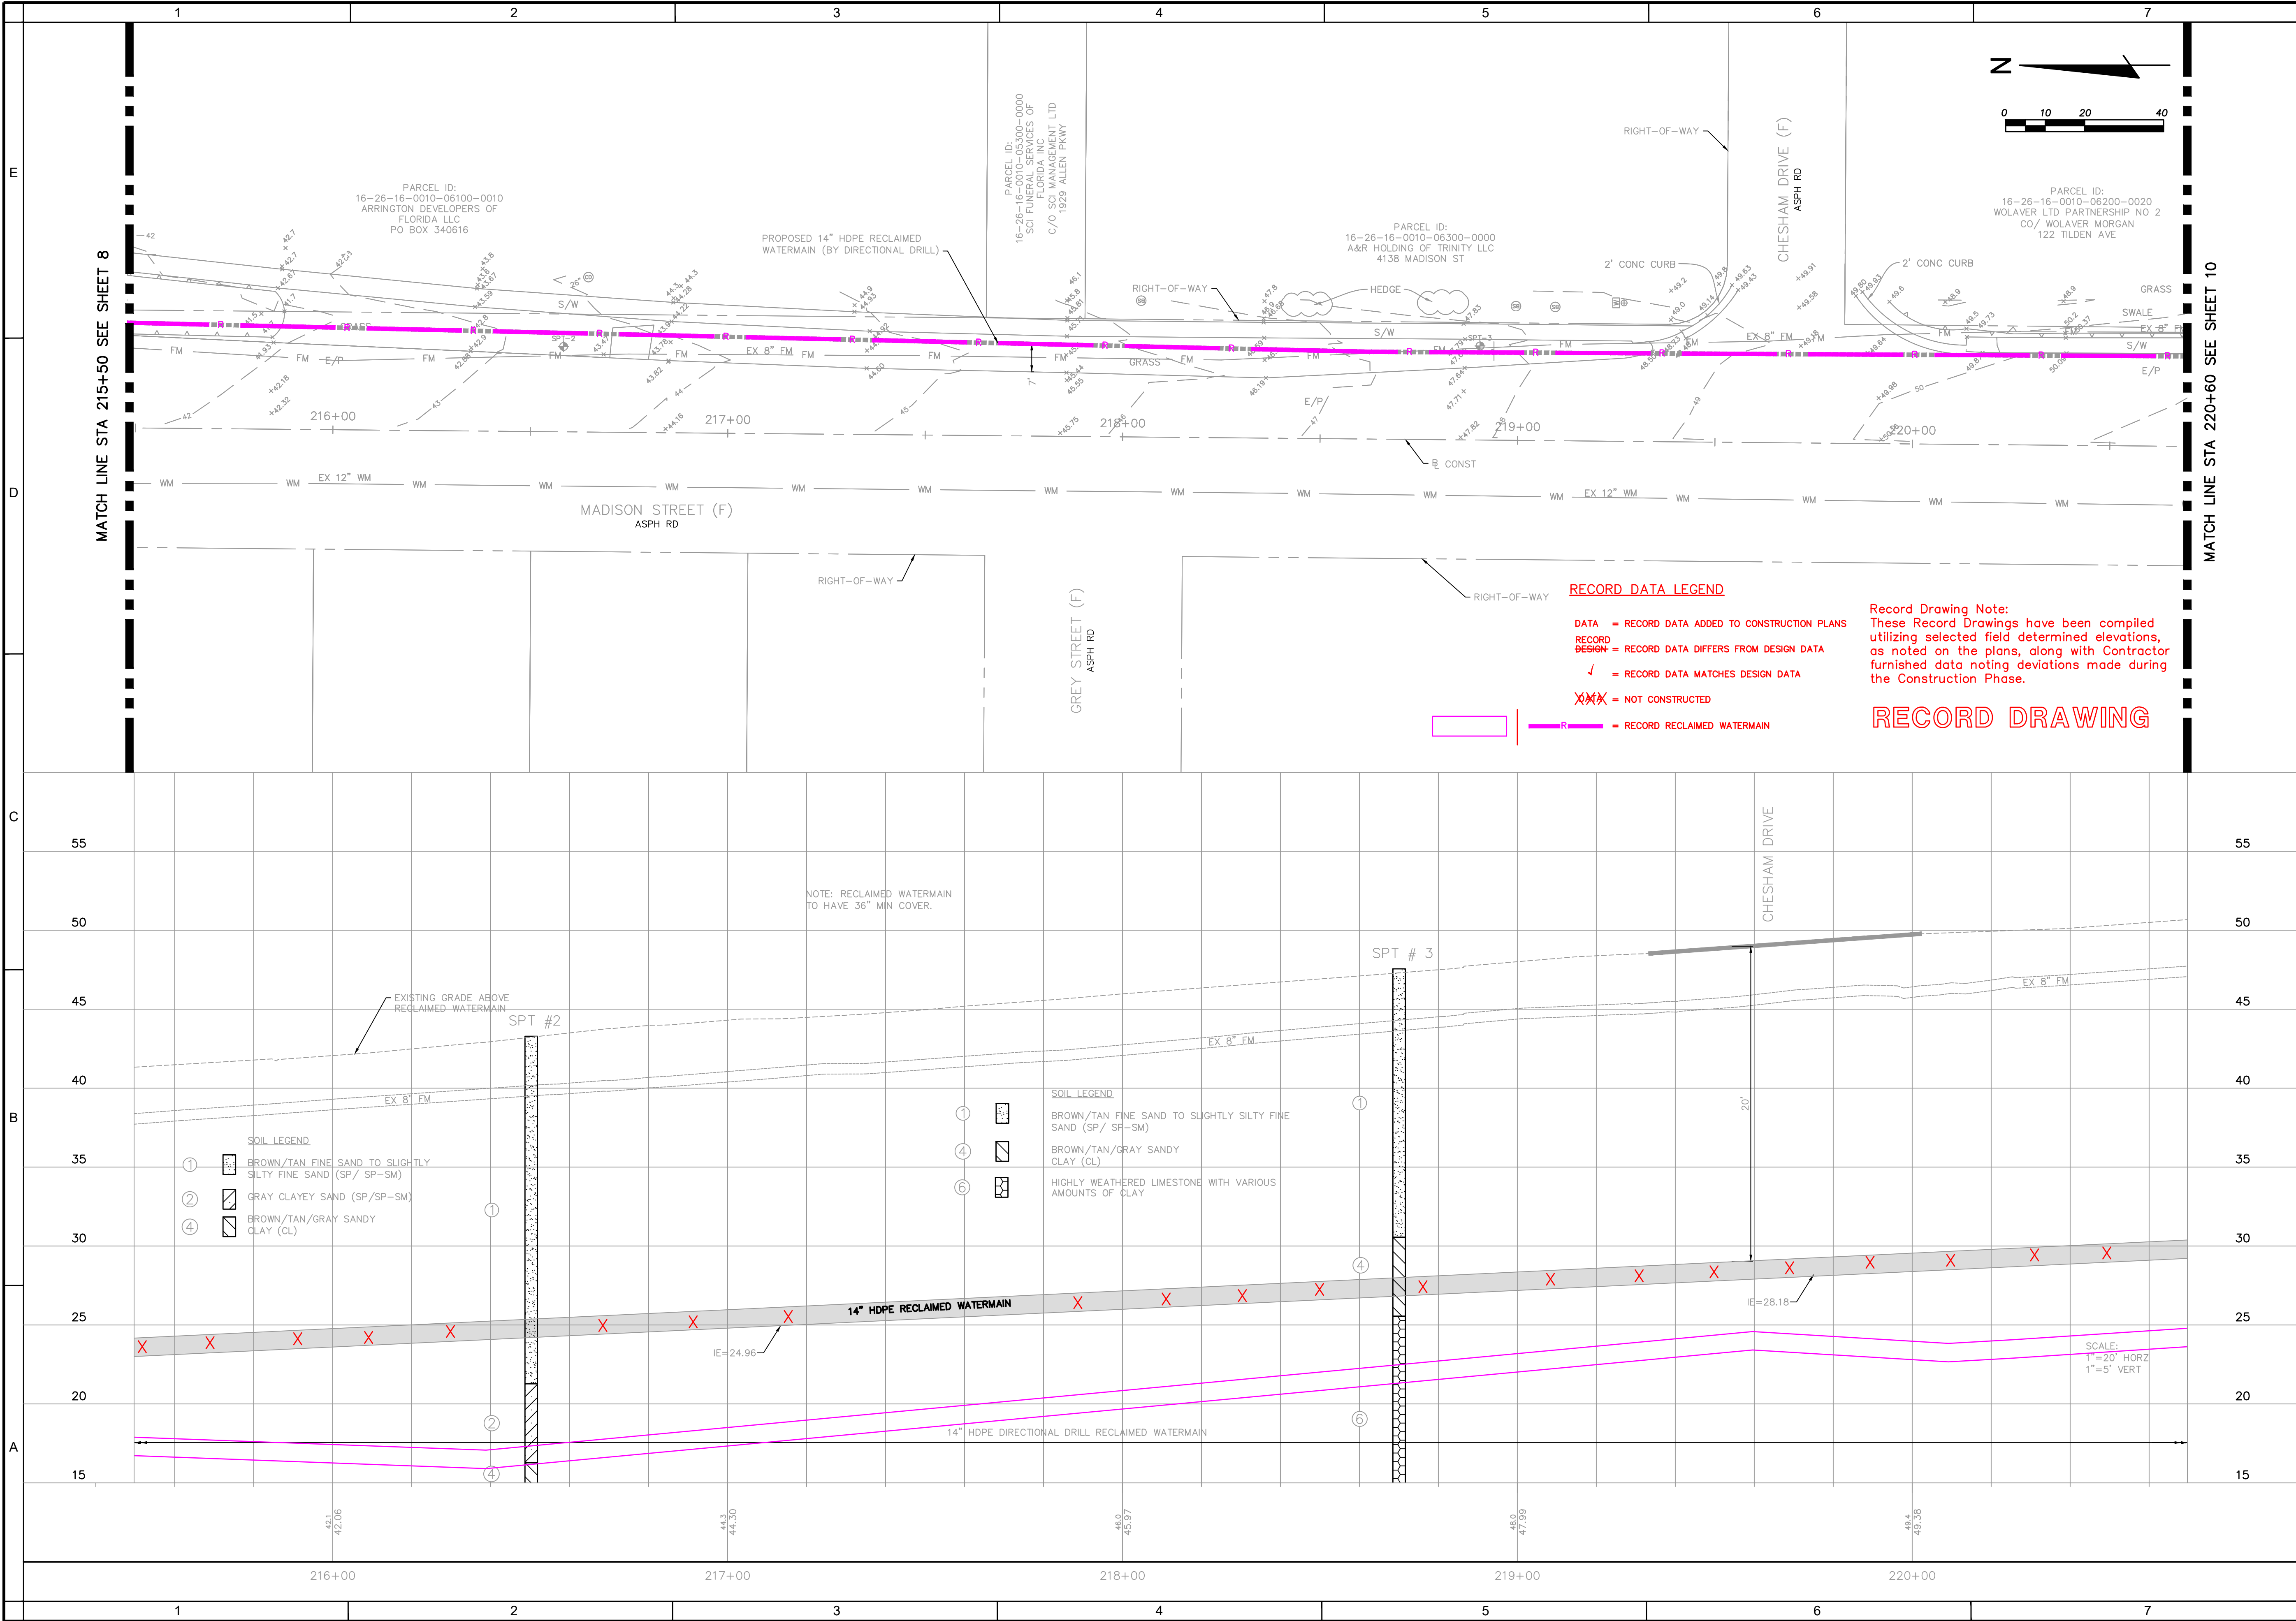

FLORIDA DESIGN CONSULTANTS, INC.
THINK IT. ACHIEVE IT.
20525 AMBERFIELD DRIVE, SUITE 201, LAND O' LAKES, FLORIDA 34638
PHONE: (727) 849-7588 FAX: (727) 848-3648 WWW.FLDESIGN.COM C.A. NO. 7421


PASCO COUNTY, FLORIDA
DESIGNED FOR: PASCO COUNTY, FLORIDA
PROJECT NAME: MADISON STREET
SHEET NAME: RECLAIMED WATERMAIN EXTENSION
PLAN AND PROFILE (4)

JAMES PAUL CHONCHOLAS, STATE OF FLORIDA PROFESSIONAL ENGINEER, LICENSE NO. 45175
THIS ITEM HAS BEEN DIGITALLY SIGNED AND SEALED BY JAMES PAUL CHONCHOLAS, P.E. ON THE DATE INDICATED HERE.
DIGITAL SIGNATURE (SHA1) THUMBPRINT F3 78 3F 27 83 CE B8 A0 F7 79 C9 30 FD 9F A6 48 86 54 53 43
PRINTED COPIES OF THIS DOCUMENT ARE NOT CONSIDERED SIGNED AND SEALED AND THE DIGITAL SIGNATURE MUST BE VERIFIED ON ANY ELECTRONIC COPIES.

DATE	0241-0119	DATE	12-04-2019
BY	902	BY	JMD
DATE	12-04-2019	DATE	JPC
BY	JMD	DATE	JPC
BY	JPC	DATE	JPC

© Copyright, 2021 Florida Design Consultants, Inc. Drawings and concepts may not be used or reproduced without written permission.

K:\9824\ProjData\Record Drawings\9824_MADISON ROW-RPP2.dwg - Jul 19, 2021 @ 9:44am - sgers

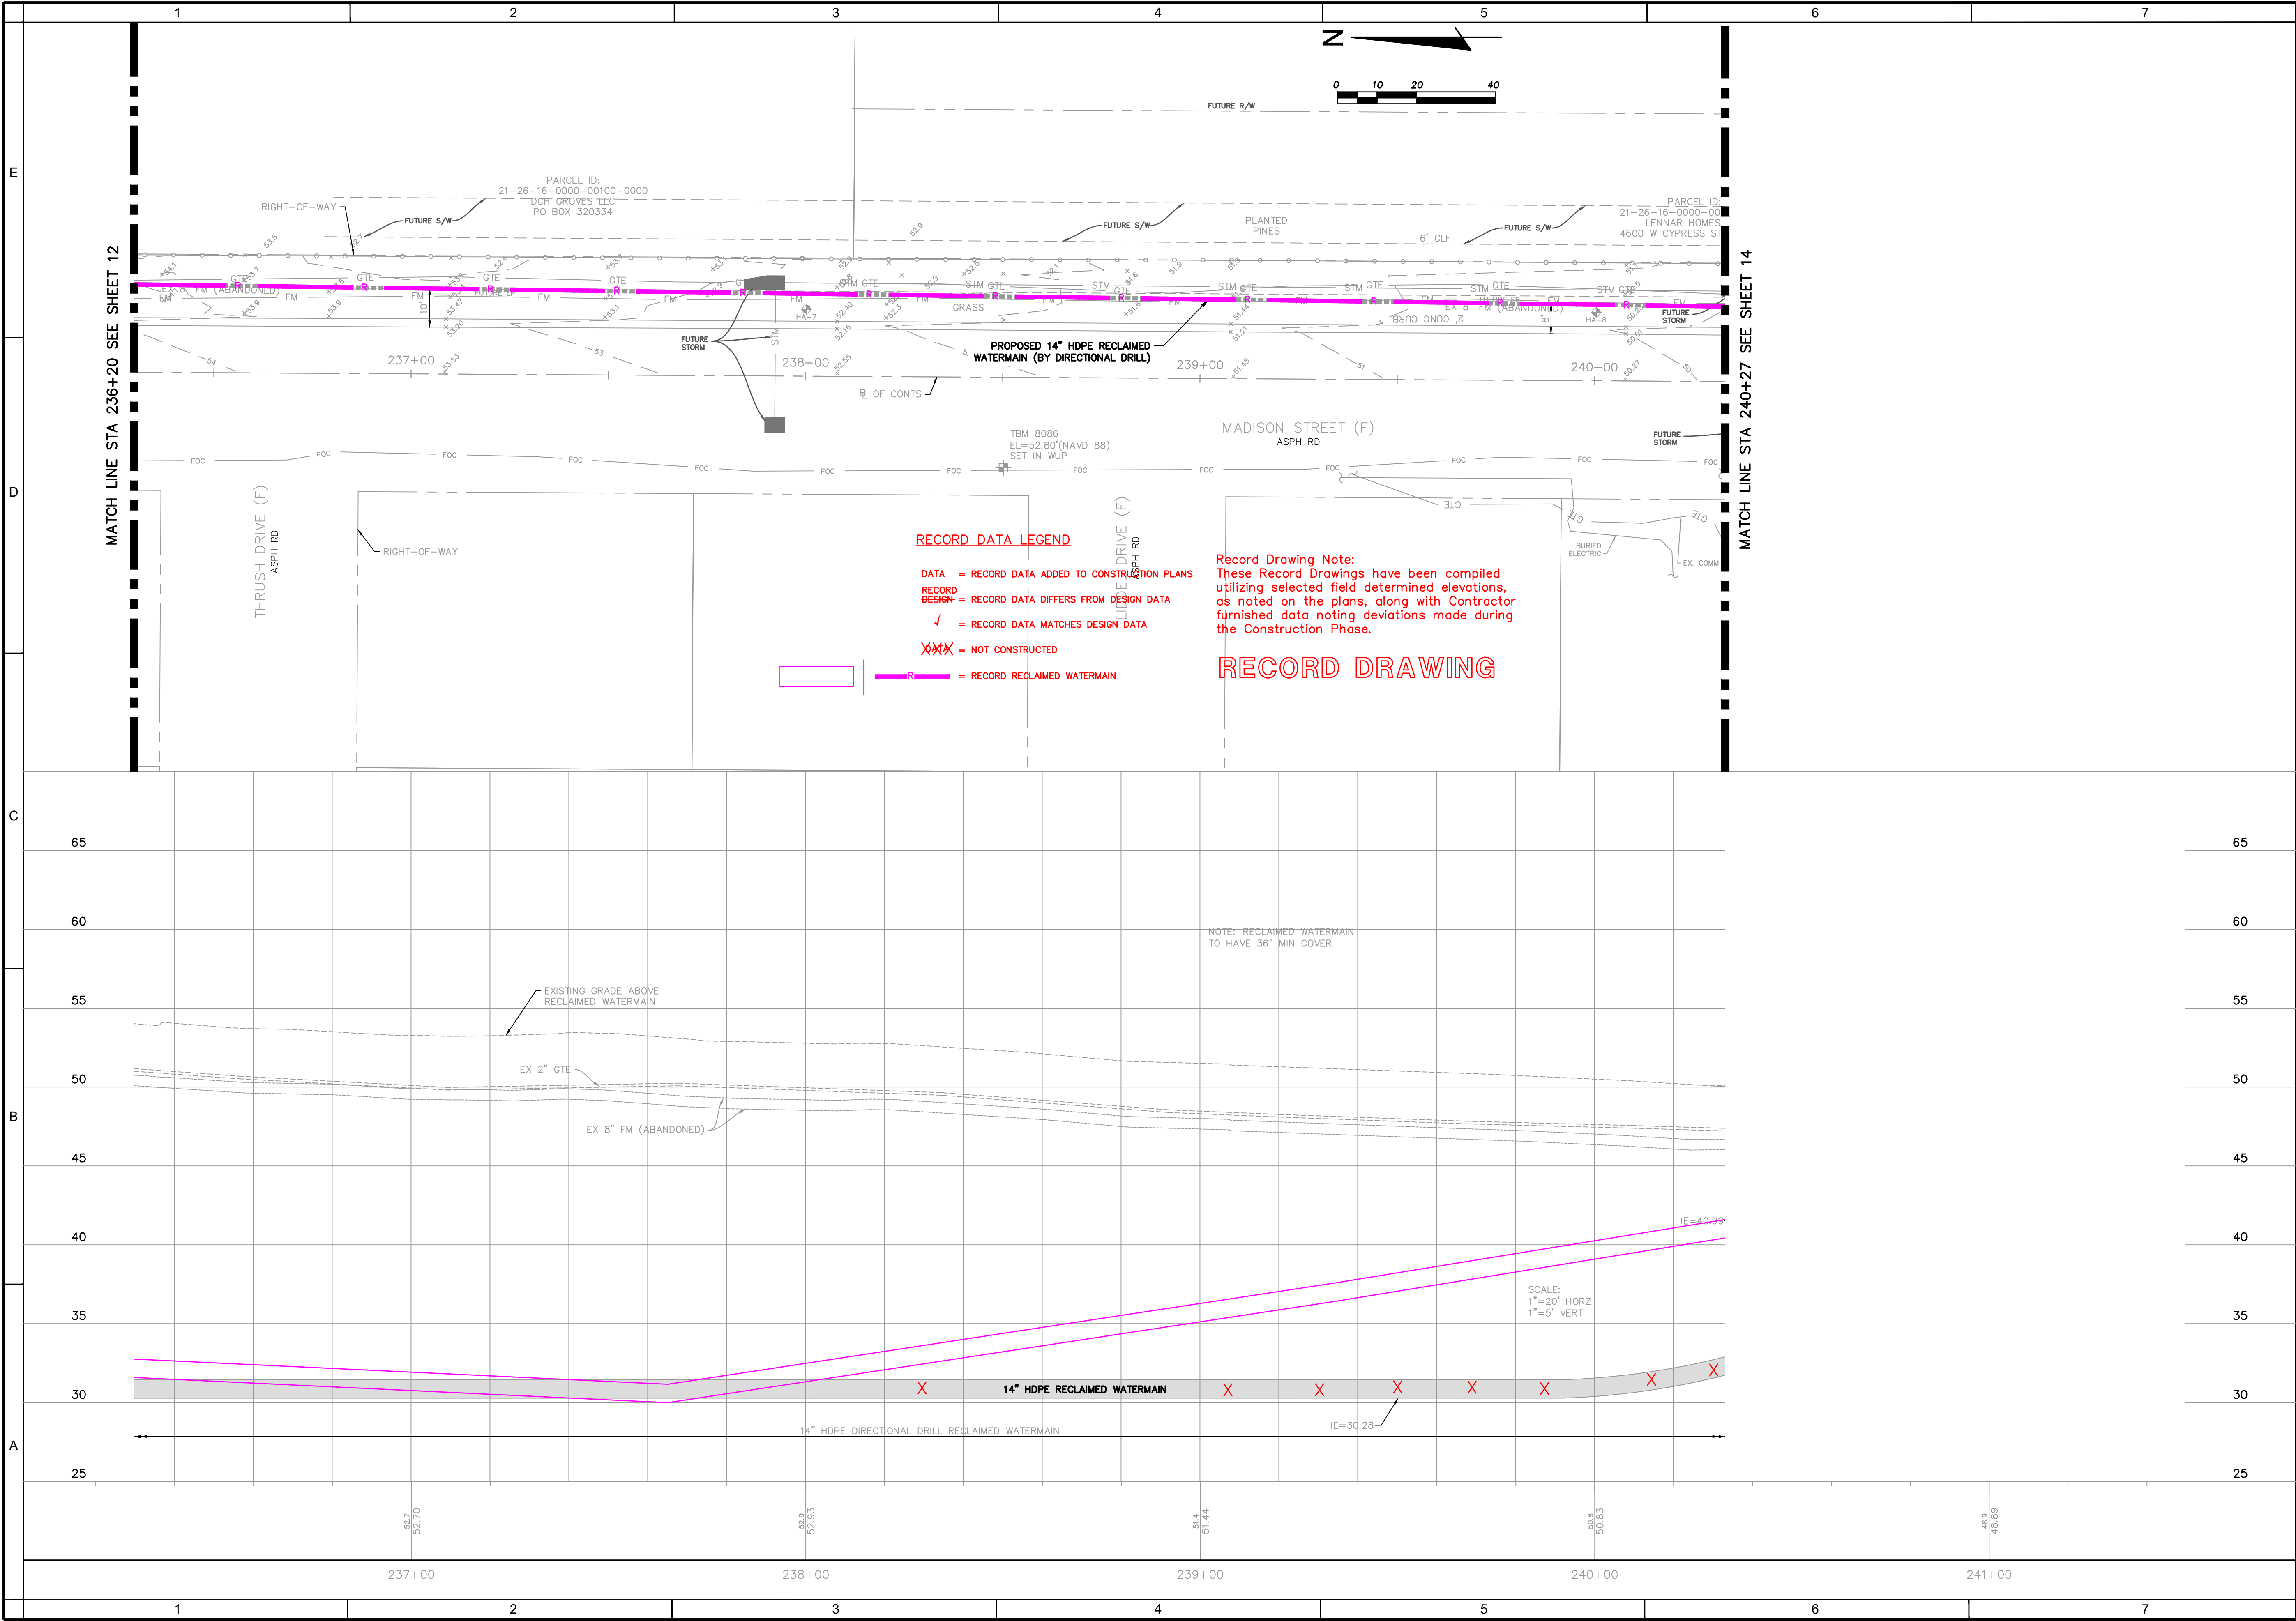

JAMES PAUL CHONCHOLAS, STATE OF FLORIDA PROFESSIONAL ENGINEER, LICENSE NO. 45175	
THIS ITEM HAS BEEN DIGITALLY SIGNED AND SEALED BY JAMES PAUL CHONCHOLAS, P.E. ON THE DATE INDICATED HERE.	
DIGITAL SIGNATURE (SHA1) THUMBPRINT F3 78 3F 27 83 CE B8 A0 F7 79 C9 30 F0 9F A6 48 86 54 53 43	
PRINTED COPIES OF THIS DOCUMENT ARE NOT CONSIDERED SIGNED AND SEALED AND THE DIGITAL SIGNATURE MUST BE VERIFIED ON ANY ELECTRONIC COPIES.	
DESIGNED FOR	DATE
PASCO COUNTY, FLORIDA	02-04-2019
PROJECT NAME	DESIGNED BY
MADISON STREET	JMD
RECLAIMED WATERMAIN EXTENSION	JPC
PLAN AND PROFILE (8)	JPC
SHEET 13 OF 16	

FLORIDA DESIGN CONSULTANTS, INC.
THINK IT. ACHIEVE IT.
20525 AMBERFIELD DRIVE, SUITE 201, LAND O' LAKES, FLORIDA 34638
PHONE: (727) 849-7588 FAX: (727) 848-3648 WWW.FLDESIGN.COM C.A. NO. 7421
© Copyright 2021 Florida Design Consultants, Inc. Drawings and concepts may not be used or reproduced without written permission.

