


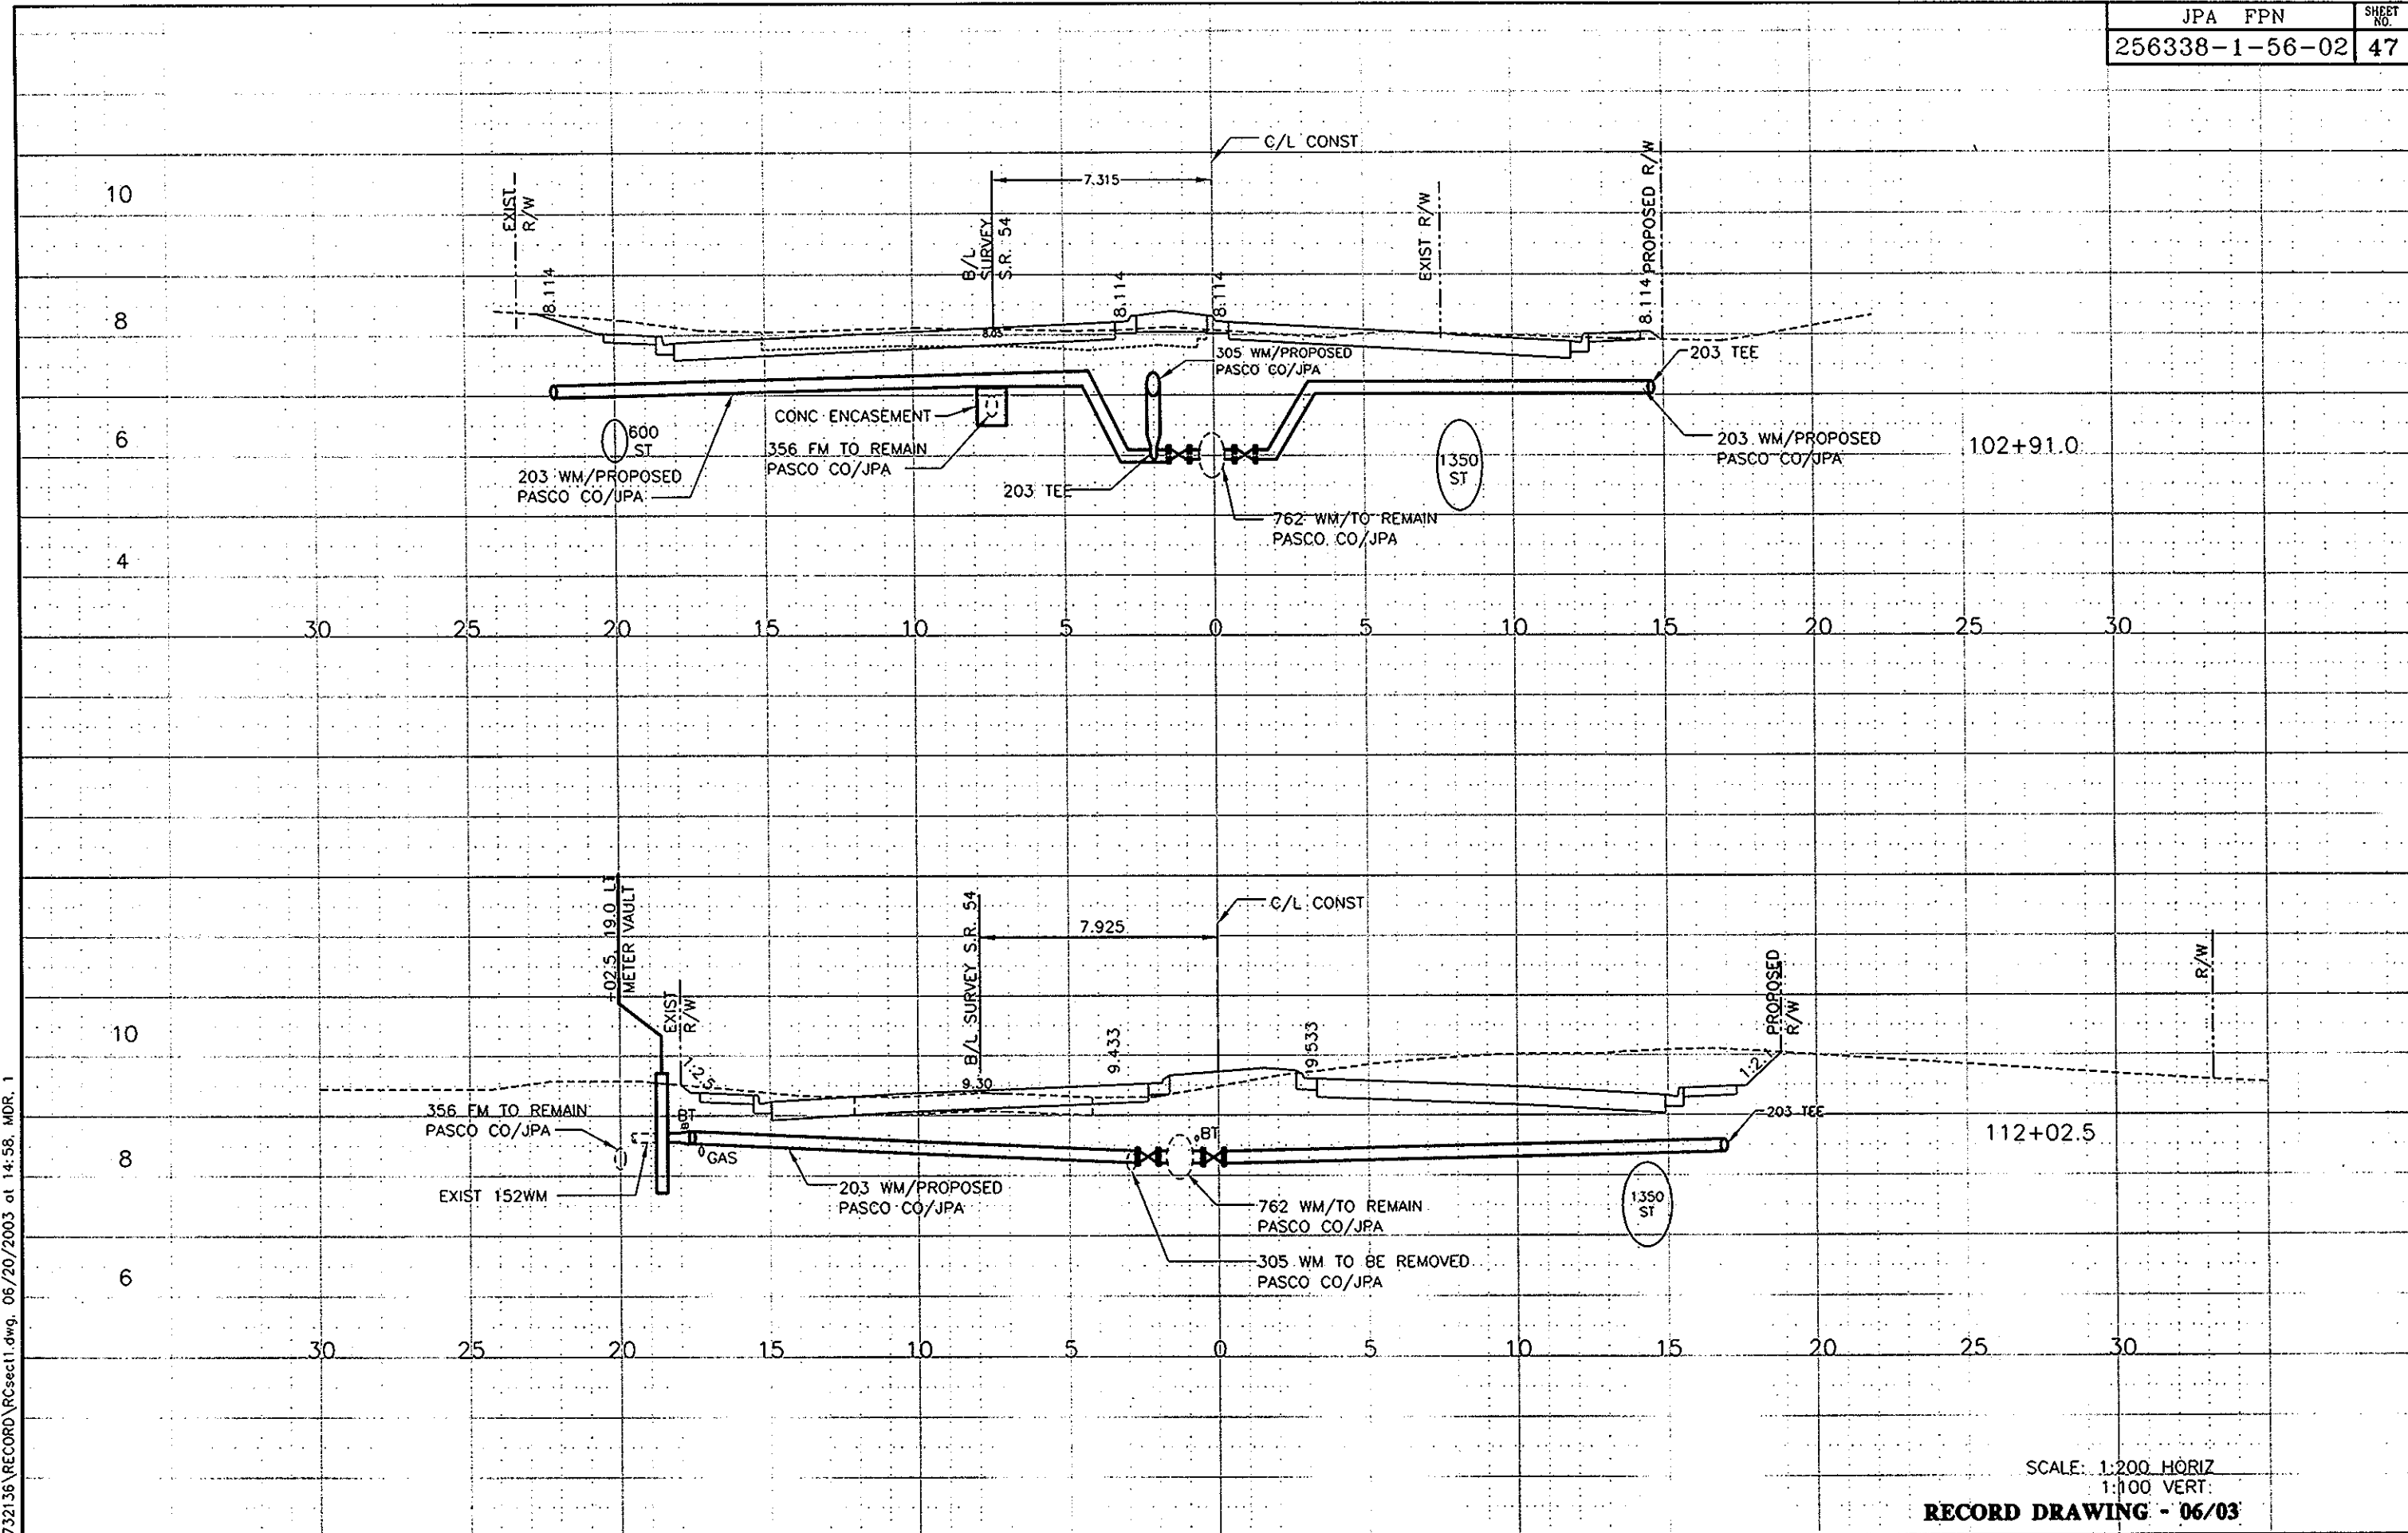

SCALE: 1:200 HORIZ
1:100 VERT



RECORD DRAWING - 06/03

REVISIONS				REVISIONS				REVISIONS			
DATE	BY	DESCRIPTION	DATE	BY	DESCRIPTION	DATE	BY	DESCRIPTION	DATE	BY	DESCRIPTION
06/03	JSL	RECORD DRAWING (SEE NOTES ON TITLE SHEET)									
11/00	JSL	RELEASED FOR BIDDING/CONSTRUCTION									

DESIGNED BY J.BURBY 2/98	CHECKED BY J.LOWE 11/00	DATE 2/98	DATE 11/00	NAME D.BURNHAM 2/98	NAME F.DeSANTO 11/00	Issue Certification APPROVED BY: JEFFERY S. LOWE, P.E. REG No.: 52017
--------------------------------	-------------------------------	--------------	---------------	---------------------------	----------------------------	---


PARSONS ENGINEERING SCIENCE, INC. Tampa, Florida (813) 933-4650	PASCO COUNTY UTILITIES CONSTRUCTION 7530 LITTLE ROAD NEW PORT RICHEY, FLORIDA 34654
--	---

STATE ROAD NO. 54 - US 19 TO MADISON WATER & FORCE MAIN UTILITY ADJUSTMENTS CROSS SECTIONS	SHEET NO. CS-1
--	-------------------

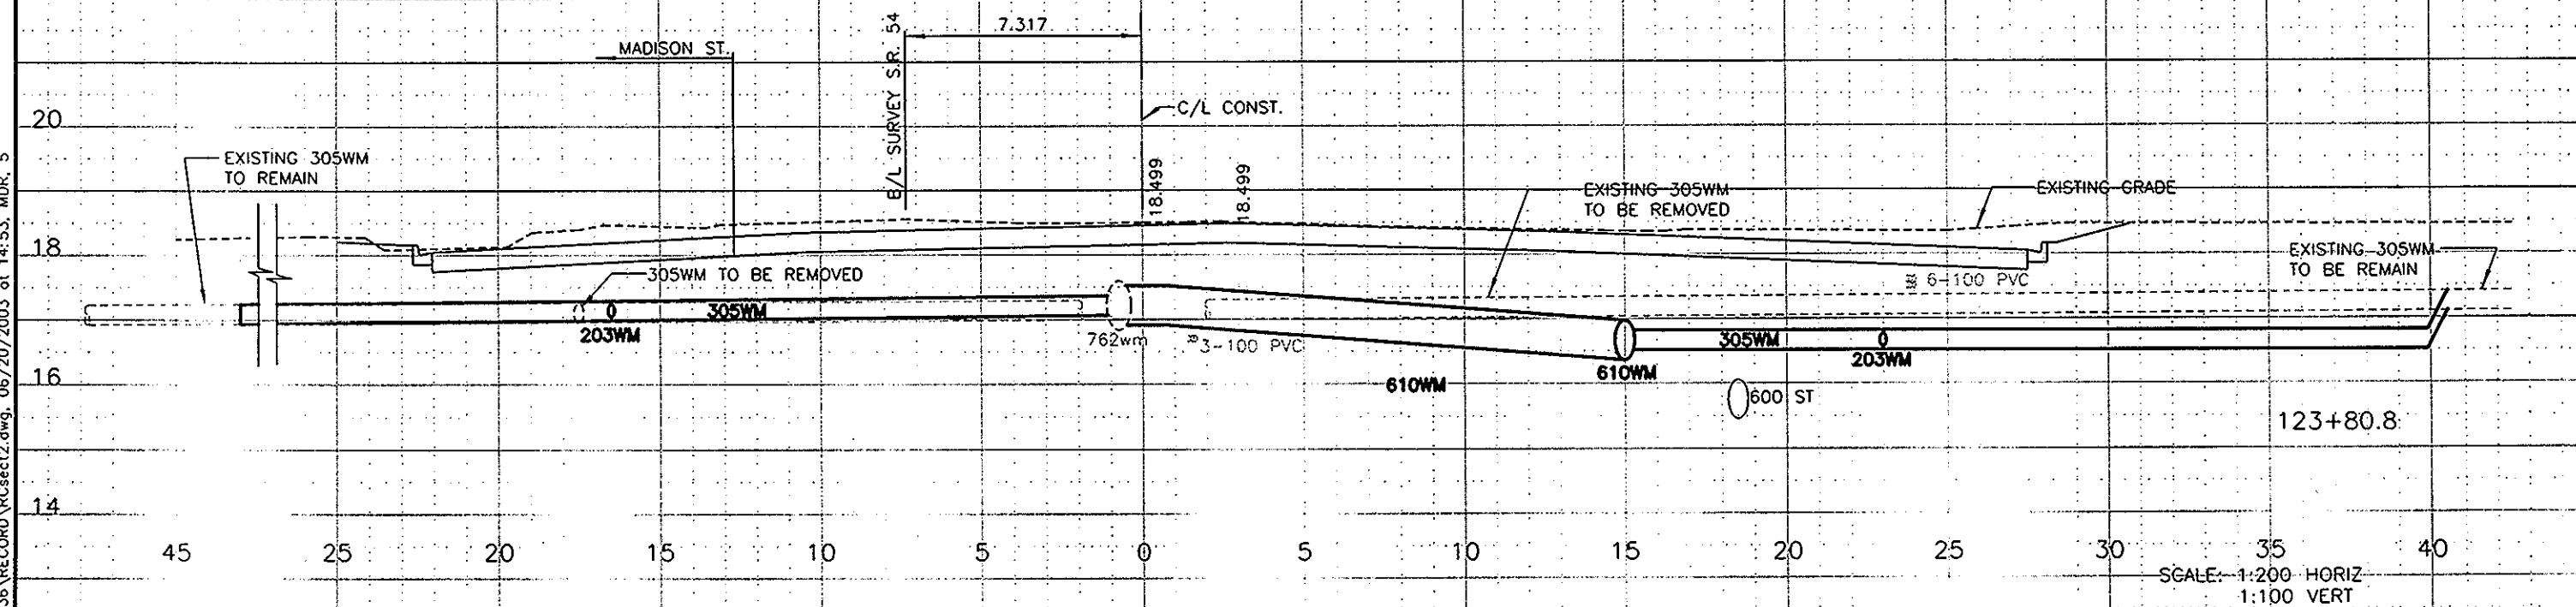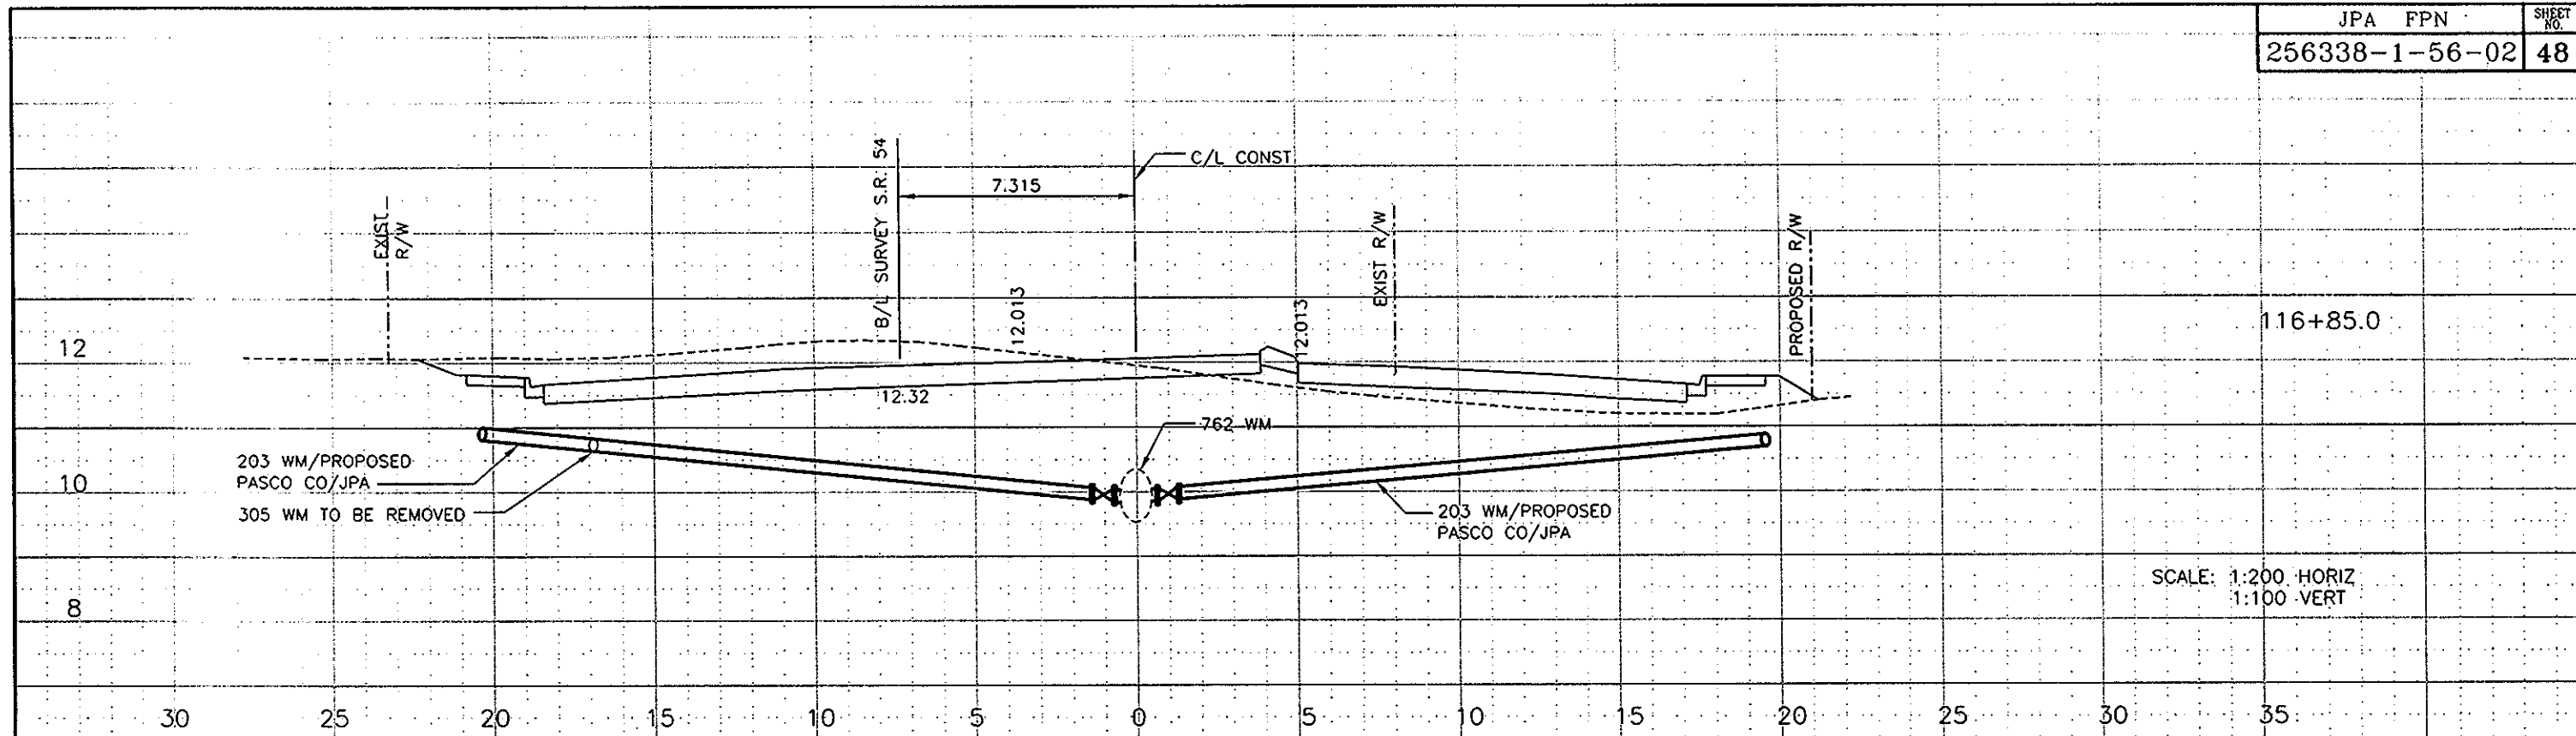


NO. 5666
JPA CAD 7/21/16 RECORD RCsect12.dwg, 06/20/2003 at 14:53, MDR, 5

REVISIONS			REVISIONS			REVISIONS			REVISIONS		
DATE	BY	DESCRIPTION	DATE	BY	DESCRIPTION	DATE	BY	DESCRIPTION	DATE	BY	DESCRIPTION
06/03	JSL	RECORD DRAWING (SEE NOTES ON TITLE SHEET)	11/00	JSL	RELEASED FOR BIDDING/CONSTRUCTION						
DESIGNED J.BURNHAM 2/98			DRAWN D.BURNHAM 2/98			CHECKED BY F.DeSANTO 11/00			APPROVED BY: JEFFERY S. LOWE, P.E. KDC No. 52017		
PARSONS ENGINEERING SCIENCE, INC.			PASCO COUNTY UTILITIES CONSTRUCTION 7530 LITTLE ROAD NEW PORT RICHEY, FLORIDA 34654			STATE ROAD NO. 54 - US 19 TO MADISON WATER & FORCE MAIN UTILITY ADJUSTMENTS CROSS SECTIONS			SHEET NO. CS-2		

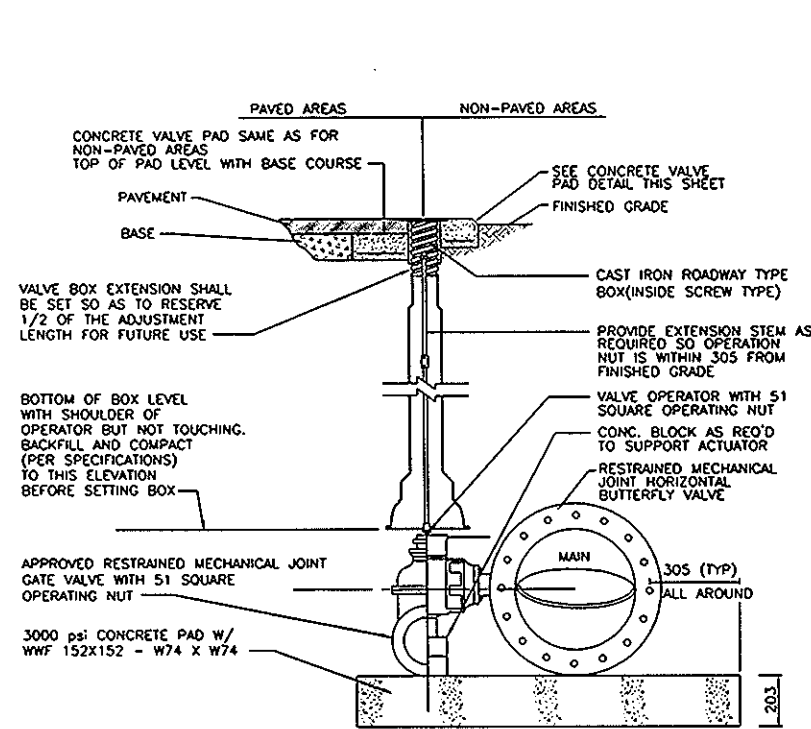


1 VALVE AND BOX DETAIL
NOT TO SCALE

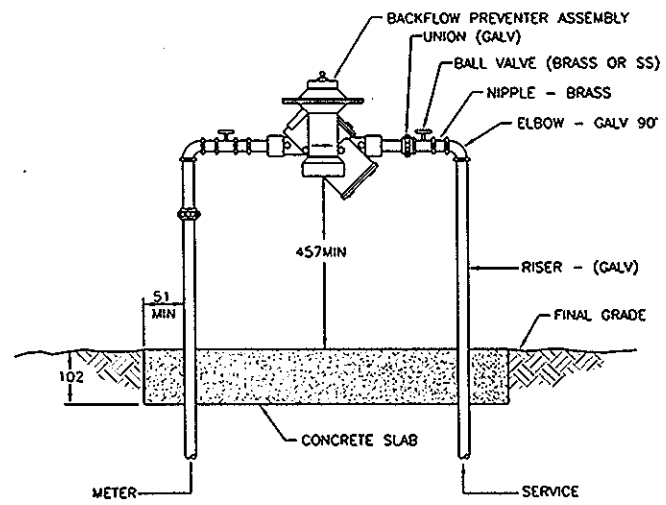


- NOTE:
1. MIN CLEARANCE OF 102 TO BE MAINTAINED AROUND DEVICE FOR TESTING
 2. ENTIRE ASSEMBLY TO BE PAINTED ARMA BLUE
 3. CONCRETE TO EXTEND 51 MIN AROUND ENTIRE DEVICE
 4. DEVICE MUST BE LISTED WITH THE UNIVERSITY OF SOUTHERN CALIFORNIA FOUNDATION FOR CROSS CONNECTION CONTROL AND HYDRAULIC RESEARCH

2 RELOCATED DOUBLE CHECK OR BACKFLOW PREVENTER
19mm - 51mm SERVICES
NOT TO SCALE

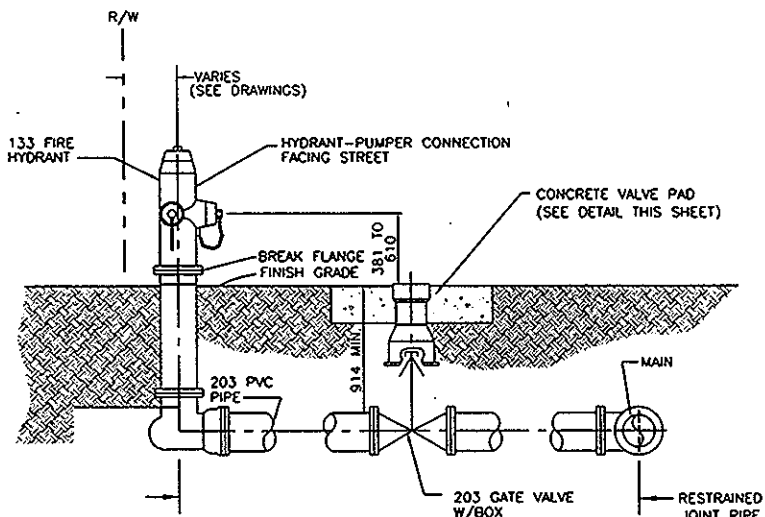


- NOTES
1. FIRE HYDRANT ASSEMBLY SHALL INCLUDE RESTRAINED JOINT BENDS IF NECESSARY
 2. ANCHOR TEE ON MAIN LINE, RESTRAINED JOINTS (MEGALUG) ON SPOOL PIECE.


3 STANDARD FIRE HYDRANT ASSEMBLY
NOT TO SCALE

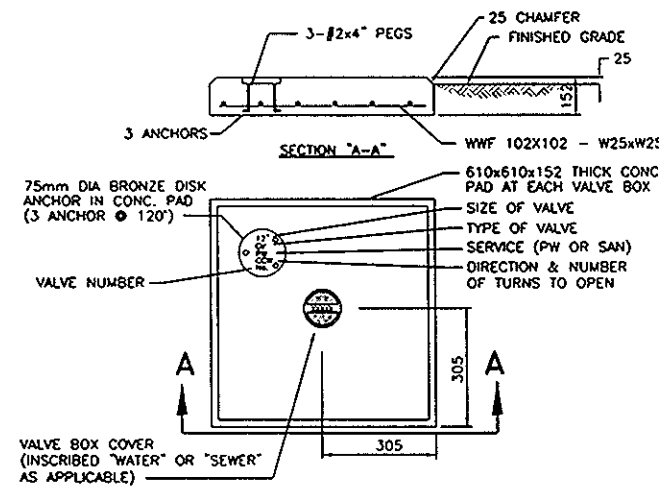

4 VALVE PAD DETAIL
NOT TO SCALE

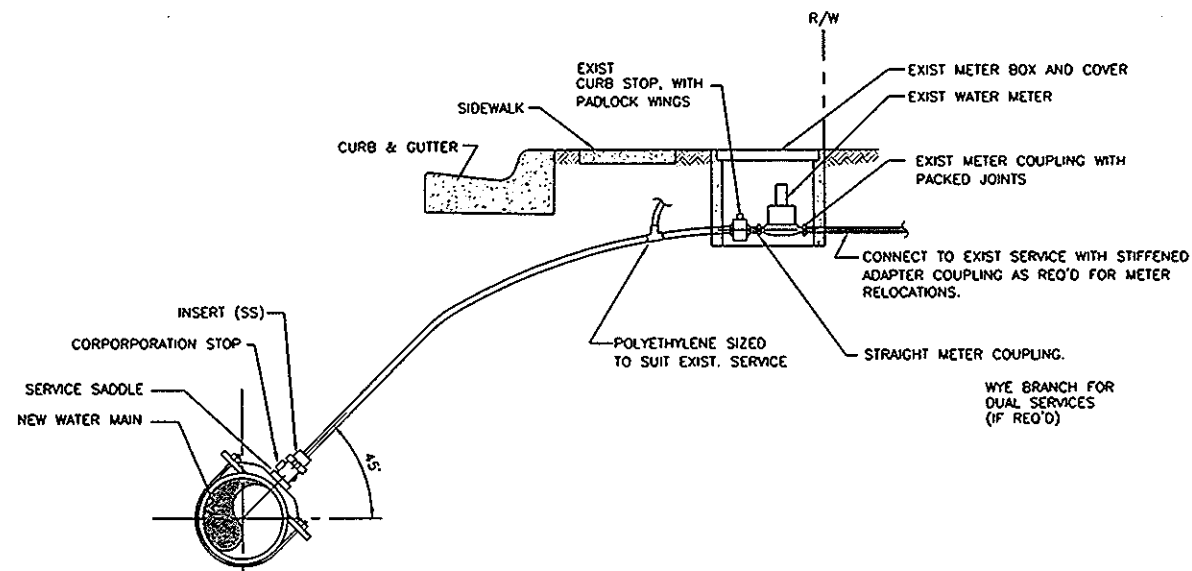

5 TYPICAL 19mm - 51mm METER SERVICE
NOT TO SCALE

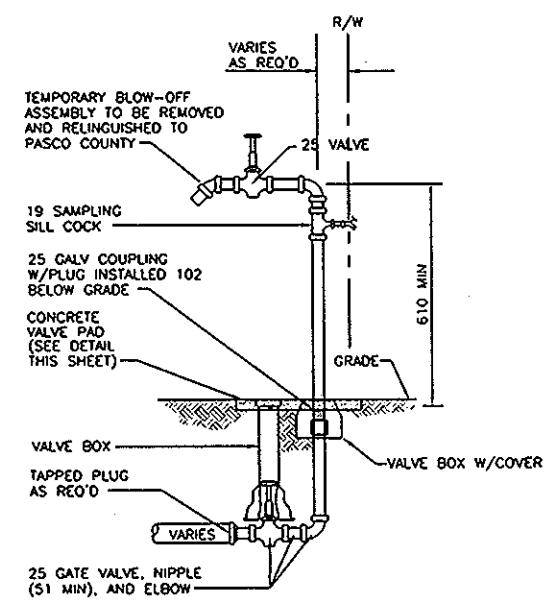


6 TEMPORARY FLUSHING & SAMPLING AND BLOWOFF DETAIL
NOT TO SCALE


RECORD DRAWING - 06/03

No. XREFS 132136 RECORD V2135DET1.dwg, 06/20/2003, at 14:08, WDR, 1

REVISIONS															Issue Certification				PASCO COUNTY UTILITIES CONSTRUCTION 7550 LITTLE ROAD NEW PORT RICHEY, FLORIDA 34654 (813) 933-4650	STATE ROAD NO. 54 - US 19 TO MADISON WATER & FORCE MAIN UTILITY ADJUSTMENTS	SHEET NO. D-1
DATE	BY	DESCRIPTION	DATE	BY	DESCRIPTION	DATE	BY	DESCRIPTION	DESIGNED BY	NAME	DATE	DRAWN BY	NAME	DATE							
6/03	JSL	RECORD DRAWING (SEE NOTES ON TITLE SHEET)		J.BURBY	2/98				DESIGNED BY	J.BURBY	2/98		DRAWN BY	D.BURNHAM	2/98						
11/00	JSL	RELEASE FOR BIDDING/CONSTRUCTION		J.LOWE	11/00				REVIEWED BY	J.LOWE	11/00		CHECKED BY	F.DE SANTO	11/00						
APPROVED BY: JEFFERY S. LOWE, P.E.										REG. NO.: 52017											

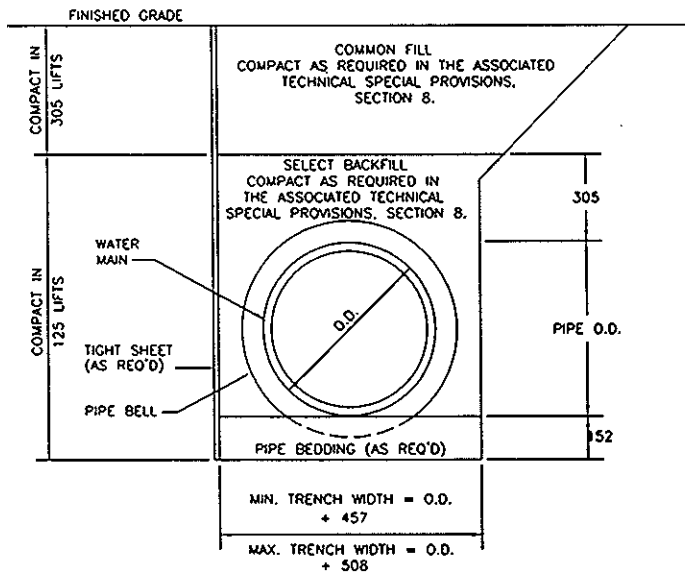


1 BACKFILL DETAIL
NOT TO SCALE

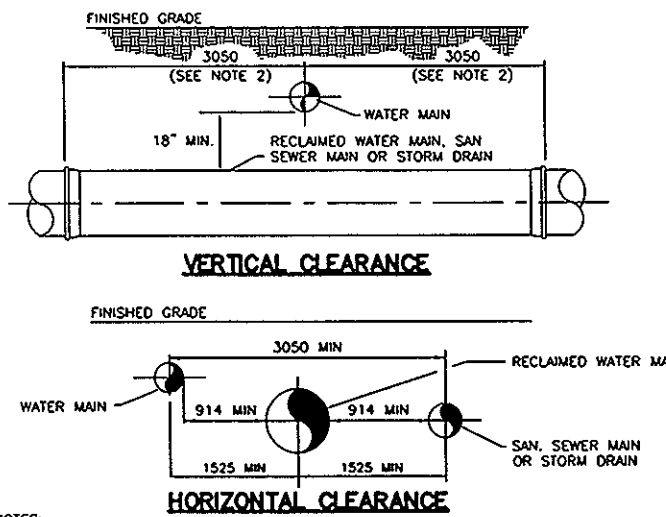


2 HORIZONTAL CLEARANCE

- NOTES:
1. THE GREATER HORIZONTAL CLEARANCE DIMENSION SHALL GOVERN.
 2. WHEN THE VERTICAL CLEARANCE BETWEEN WATER MAINS AND OTHER UTILITIES IS 457 OR LESS, D.I.P. JOINTS SHALL BE A MIN. OF 3050 EACH WAY FROM CENTERLINE OF WATER MAIN, UNLESS OTHERWISE SHOWN ON THE CONTRACT DRAWINGS.
 3. WHEN THE VERTICAL CLEARANCE BETWEEN WATER MAINS AND OTHER UTILITIES IS 457 OR LESS, VCP AND/OR PVC PIPE SHALL BE REPLACED FOR A MIN. OF 3050 EACH WAY FROM CENTERLINE OF WATER MAIN, UNLESS OTHERWISE SHOWN ON THE CONTRACT DRAWINGS.
 4. CONCRETE ENCASMENT IS NOT PERMITTED UNLESS OTHERWISE SHOWN ON THE CONTRACT DRAWINGS OR APPROVED BY THE ENGINEER OF RECORD OR PASCO COUNTY FOR EACH SPECIFIC CASE.
 5. ALL WATER MAINS SHALL HAVE A MINIMUM COVER OF (914) BELOW FINAL GRADE OR AS SHOWN ON THE PLANS. WATER MAINS THAT CROSS UNDER EXISTING DITCHES SHALL HAVE A MINIMUM COVER OF (762) TO FINAL GRADE.

2 WATER MAIN CLEARANCES
NOT TO SCALE

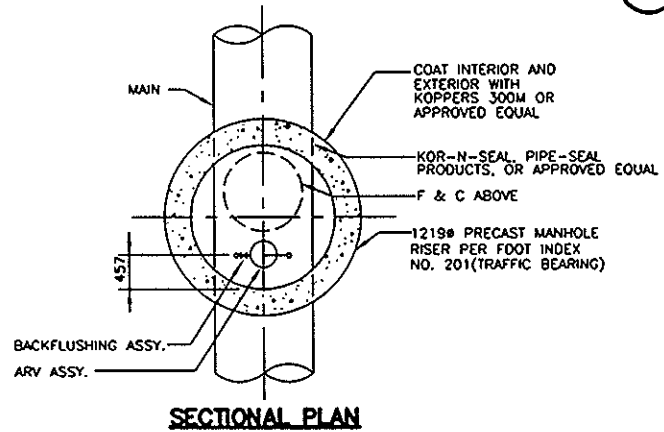


SECTIONAL PLAN

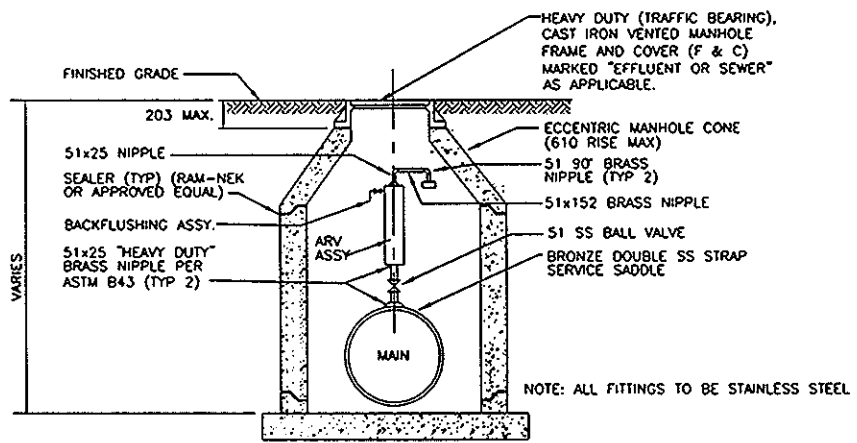


SECTIONAL ELEVATION


4 AIR RELIEF VALVE DETAIL
NOT TO SCALE

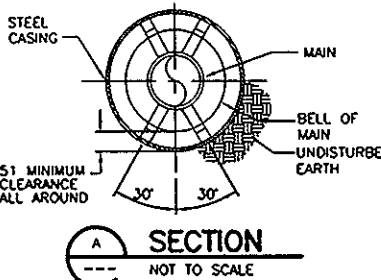

SECTION
NOT TO SCALE

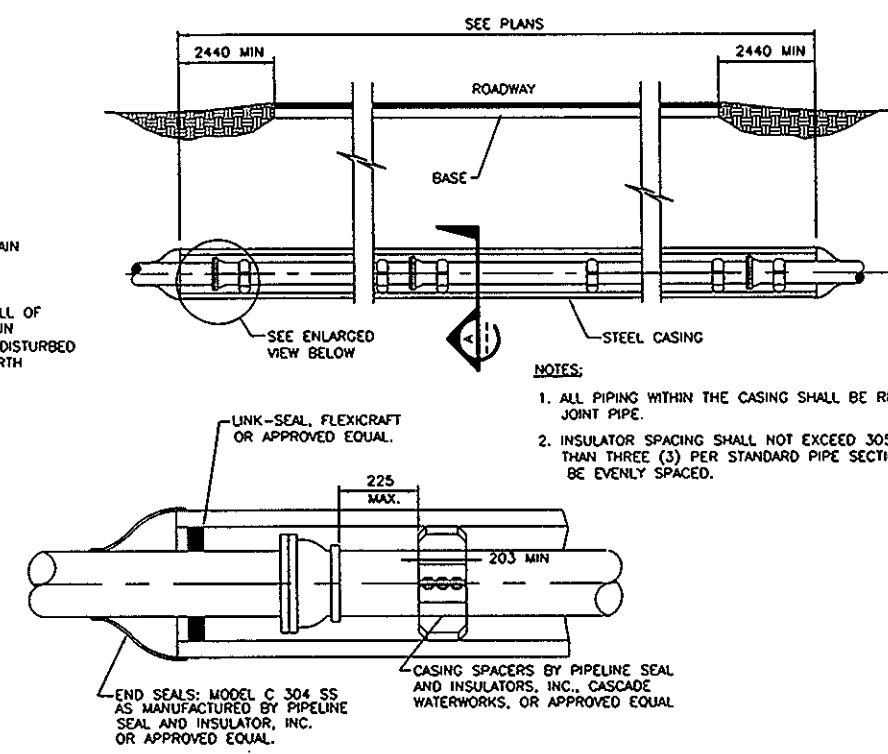

3 STEEL CASING DETAIL
NOT TO SCALE

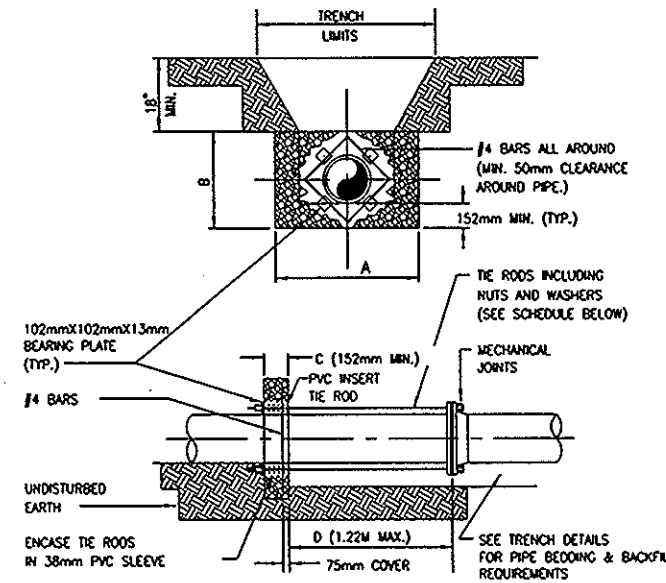


NOTES:


1. ADDITIONAL REINFORCEMENTS SHALL BE AS SPECIFIED BY THE ENGINEER.
2. MINIMUM COMPRESSIVE STRENGTH FOR CONCRETE SHALL BE 17,340 PSI.
3. BEDDING, BACKFILL, AND COMPACTION SHALL BE AS SPECIFIED ELSEWHERE IN THE STANDARD DRAWINGS.
4. ALL FORM BOARDS SHALL BE REMOVED PRIOR TO BACKFILL.
5. NO ALLOWANCE SHALL BE MADE FOR FRICTION BETWEEN THE PIPE WALL AND THE THRUST COLLAR.
6. TEST PRESSURE: 1034 kPa.

NOTE: THRUST BLOCK AREA TO BE COMPUTED ON BASIS OF 7324 KG FOR 50. METER 50M RESTRAINT (SEE NOTE 5) BEARING.

5 THRUST COLLAR DETAIL
NOT TO SCALE

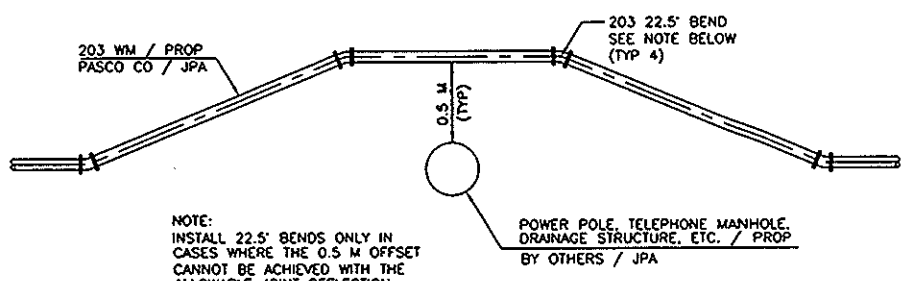

6 TYPICAL OFFSET FROM UTILITIES
NOT TO SCALE

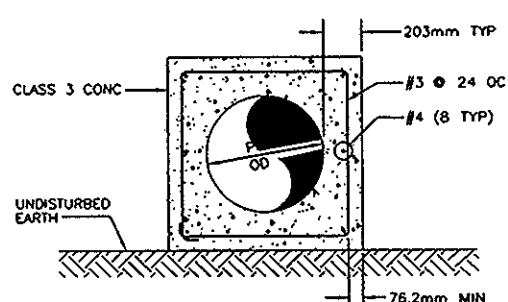

7 CONCRETE ENCASMEN DETAIL
NOT TO SCALE

SCHEDULE OF DIMENSIONS AND MATERIALS

PIPE SIZE (mm)	DIMENSIONS (M)				TIE RODS REQ'D	
	A	B	C	D	DA (mm)	QUANT.
203	0.840	0.840	0.305	0.305	19.1	2
305	1.37	1.22	0.305	0.610	22.2	4
610	2.13	2.13	0.457	1.22	25.4	6

RECORD DRAWING - 06/03

A map of the state of Florida with major cities and highways labeled. An arrow points to St. Petersburg, which is labeled as the project location. Other cities shown include Pensacola, Fort Walton Beach, Panama City, Tallahassee, Lake City, Gainesville, Ocala, Deland, Daytona Beach, Orlando, Melbourne-Cocoa, Ft. Pierce, West Palm Beach, Ft. Lauderdale, Miami, Key West, Naples, Ft. Myers, Sarasota, Bradenton, and New Port Richey. Highways 1, 9, 10, 17, 28, 30, 39, 40, 41, 42, 44, 45, 49, 50, 52, 54, 58, 60, 66, 70, 74, 76, 78, 82, 84, 86, 998, 1000.

INDEX OF UTILITY PLANS


SHEET NO.	SHEET DESCRIPTION
G-1	COVER SHEET
G-2	SUMMARY OF QUANTITIES/GENERAL NOTES
P-1 - P-19A	SR 54 - PLAN AND PROFILE
P-20 - P-22	CR 595 - PLAN AND PROFILE
P-23 - P-24	MADISON STREET - PLAN AND PROFILE
P-25	US 19 OUTFALL - PLAN AND PROFILE
CS-1	CROSS SECTIONS
CS-2	CROSS SECTIONS
D-1	MISCELLANEOUS DETAILS
D-2	MISCELLANEOUS DETAILS

1. THESE RECORD DRAWINGS HAVE BEEN PREPARED USING INFORMATION COMPILED BY OTHERS DURING CONSTRUCTION OF THESE FACILITIES. CONSTRUCTION OF THESE FACILITIES WAS NOT UNDER THE ENGINEER'S RESPONSIBLE SUPERVISION, DIRECTION, OR CONTROL. THESE RECORD DRAWINGS DO NOT NECESSARILY REPRESENT, IN DETAIL, EXACT LOCATIONS, AND MANNER OF CONSTRUCTION. THE ENGINEER WILL NOT BE RESPONSIBLE FOR ANY ERRORS OR OMISSIONS THAT HAVE BEEN INCORPORATED INTO THESE RECORD DRAWINGS.

A) THE ENGINEER WAS IN RESPONSIBLE CHARGE OF INSPECTING THE CONSTRUCTION OF THE PROJECT.

C) TO THE BEST OF THE ENGINEER'S KNOWLEDGE AND BELIEF, ANY DEVIATIONS FROM THE CONSTRUCTION PERMIT AND APPROVED PLANS AND SPECIFICATIONS WILL NOT PREVENT THE PROJECT FROM FUNCTIONING IN ACCORDANCE WITH FAC 62-550 AND FAC 62-604.

GOVERNING STANDARDS AND SPECIFICATIONS: STATE OF FLORIDA DEPARTMENT OF TRANSPORTATION, ROADWAY & TRAFFIC DESIGN STANDARD, DATED JANUARY 2000, AND STANDARD SPECIFICATIONS FOR ROAD AND BRIDGE CONSTRUCTION DATED 2000, AS AMENDED BY CONTRACT DOCUMENTS.

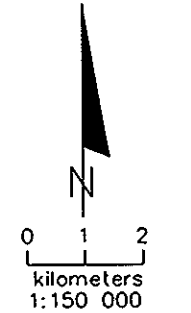

REVISONS		
DATE	BY	DESCRIPTION
12/00	JSL	RELEASED FOR BIDDING/CONSTRUCTION
06/03	<i>[Signature]</i>	RECORD DRAWINGS

 **PARSONS ENGINEERING SCIENCE, INC.**
3450 BUSCHWOOD PARK DR., SUITE 345
TAMPA, FLORIDA 33618
PH: (813) 933-4650 FAX: (813) 930-7332

JEFFREY S. LOWE, P.E.
FL LICENSE NO. 52017

1. THESE PLANS ONLY REFLECT PROPOSED UTILITY CONSTRUCTION FOR 256338-1-56-02 (PASCO COUNTY UTILITIES). REFER TO STATE PROJECT 14570-3519 FOR INFORMATION ON ROAD AND DRAINAGE DESIGN.
2. THIS UTILITY CONTRACT PLAN SET TO BE LET IN THE SAME CONTRACT WITH STATE PROJECT NO. 14570-3519
3. WORK IDENTIFIED IN THIS UTILITY CONTRACT PLAN SET IS INCLUDED IN THE ENVIRONMENTAL RESOURCE PERMIT FOR STATE PROJECT NO. 14570-3519
4. ATTENTION IS DIRECTED TO THE FACT THAT THESE PLANS MAY HAVE BEEN REDUCED IN SIZE BY REPRODUCTION. THIS MUST BE CONSIDERED WHEN OBTAINING SCALED DATA.

NOTE:
THIS IS A METRIC UNIT PROJECT.

SUMMARY OF QUANTITIES				
ITEM NO.	ALT	DESCRIPTION	UNIT	QUANTITY
ALTERNATIVE AB				
2425-2-71	AB	MANHOLE, J-7 BOT<3M, STANDARD INDEX 201	EA	2
2425-2-72	AB	MANHOLE, J-7 BOT>3M, STANDARD INDEX 201	EA	3
2730-76-108	AB	STEEL CASING, FURNISH & INSTALL, 356mm	M1	124
2730-76-110	AB	STEEL CASING, FURNISH & INSTALL, 457mm	M1	46
3020-1	AB	PIPE REMOVAL, 457mm OR LESS	M1	3997
3020-2	AB	PIPE REMOVAL, 508mm OR MORE	M1	323
3637-111-100	AB	VALVE BOX, TAP CROSS & VALVE TAP SLEEVE & VALVE FURNISH & INSTALL, SCREW TYPE-2 PCS, W/ SLEEVE & VALVE, DIP, 762mmX203mm, 203mm VALVE	EA	1
3637-111-100	AB	VALVE BOX, TAP CROSS & VALVE TAP SLEEVE & VALVE FURNISH & INSTALL, SCREW TYPE-2 PCS, W/ SLEEVE & VALVE, DIP, 762mmX203mm, 203mm VALVE	EA	6
3070-111-205	AB	VALVE ASSY, FURNISH & INSTALL, CI, GV W/ BOX, 1724KPA, 51mm	EA	4
3070-111-206	AB	VALVE ASSY, FURNISH & INSTALL, CI, GV W/ BOX, 1724KPA, 76mm	EA	1
3070-111-207	AB	VALVE ASSY, FURNISH & INSTALL, CI, GV W/ BOX, 1724KPA, 102mm	EA	4
3070-111-208	AB	VALVE ASSY, FURNISH & INSTALL, CI, GV W/ BOX, 1724KPA, 152mm	EA	5
3070-111-209	AB	VALVE ASSY, FURNISH & INSTALL, CI, GV W/ BOX, 1724KPA, 203mm	EA	30
3070-111-210	AB	VALVE ASSY, FURNISH & INSTALL, CI, GV W/ BOX, 1724KPA, 254mm	EA	1
3070-111-211	AB	VALVE ASSY, FURNISH & INSTALL, CI, GV W/ BOX, 1724KPA, 305mm	EA	3
3070-111-216	AB	VALVE ASSY, FURNISH & INSTALL, CI, GV W/ BOX, 1724KPA, 610mm	EA	2
3070-115-116	AB	VALVE ASSY, FURNISH & INSTALL, CI, BFW W/ BOX, 1034KPA, 610mm	EA	1
3070-118-110	AB	VALVE ASSY, FURNISH & INSTALL, CI, AIR RELEASE ASSY, 1034KPA, 254mm	EA	1
3070-515-117	AB	VALVE ASSY, ADJ. & MOD., CI, BFW, 1034KPA, 762 mm	EA	1
3090-133-07	AB	PIPE (PVC), FURNISH & INSTALL, PUSH-ON, CLASS 150, 102mm	M1	58
3090-133-09	AB	PIPE (PVC), FURNISH & INSTALL, PUSH-ON, CLASS 150, 203mm	M1	3824
3090-133-10	AB	PIPE (PVC), FURNISH & INSTALL, PUSH-ON, CLASS 150, 254mm	M1	102
3090-133-11	AB	PIPE (PVC), FURNISH & INSTALL, PUSH-ON, CLASS 150, 305mm	M1	30
3100-111-816	AB	PIPE (D/CI), FURNISH & INSTALL, PUSH-ON, CEMENT, 1724KPA, 610mm	M1	226
3090-153-07	AB	PIPE (PVC), FURNISH & INSTALL, MFD RESTR., CLASS 150, 102mm	M1	18
3090-153-09	AB	PIPE (PVC), FURNISH & INSTALL, MFD RESTR., CLASS 150, 203mm	M1	800
3090-153-10	AB	PIPE (PVC), FURNISH & INSTALL, MFD RESTR., CLASS 150, 254mm	M1	36
3090-153-11	AB	PIPE (PVC), FURNISH & INSTALL, MFD RESTR., CLASS 150, 305mm	M1	93
3100-141-816	AB	PIPE (D/CI), FURNISH & INSTALL, MFD RESTR., CEMENT, 1724KPA, 610mm	M1	176
3510-120	AB	SANITARY SEWER FITTINGS, FURNISH & INSTALL, DI	MT	1
3610-140	AB	WATER FITTINGS, FURNISH & INSTALL, DI	MT	15
3698-190-305	AB	SERVICE-WATER, FURNISH & INSTALL, POLYETH, CL150, LINEAR, 51mm	EA	3
3698-130-309	AB	SERVICE-WATER, FURNISH & INSTALL, PVC., LINEAR, CL150, 203mm	EA	3
3698-790-305	AB	SERVICE-WATER, ADJ. & MOD., POLYETH, LINEAR, CL150, 51mm	EA	1
3698-830-308	AB	SERVICE-WATER, RELOCATE, PVC., LINEAR, CL150, 152mm	EA	1
3644-113-01	AB	HYDRANT, FURNISH & INSTALL, STD., TWO HOSE ONE PUMPER, 135mm	EA	16
3644-413-01	AB	HYDRANT, SALVAGE & STORE, STD., TWO HOSE ONE PUMPER, 135mm	EA	10

NOTE:

1. ALTERNATIVE "AA" PROVIDES DIP FOR BOTH THE FORCE MAINS AND WATER MAINS.
2. ALTERNATIVE "AB" PROVIDES DIP FOR BOTH THE FORCE MAINS AND WATER MAINS GREATER THAN 305mm AND PVC FOR BOTH THE FORCE MAINS AND WATER MAINS 305mm AND LESS.
3. FIELD CONDITIONS MAY NECESSITATE SLIGHT ALIGNMENT AND GRADE DEVIATION OF THE PROPOSED UTILITIES TO AVOID OBSTACLES, AS ORDERED BY THE ENGINEER.
4. THE CONTRACTOR SHALL PROVIDE AT LEAST FORTY EIGHT (48) HOURS NOTICE TO THE VARIOUS UTILITY COMPANIES IN ORDER TO PERMIT THE EXISTING UNDERGROUND UTILITIES BY ADVANCE OF CONSTRUCTION.
5. THE CONTRACTOR SHALL NOTIFY THE ENGINEER IMMEDIATELY WHEN CONFLICTS BETWEEN DRAWINGS AND ACTUAL CONDITIONS ARE DISCOVERED.
6. ANY PERMANENT RELOCATION OF EXISTING UTILITIES NOT SHOWN ON THE DRAWINGS, SHALL BE APPROVED BY THE ENGINEER, AND/OR PASCO COUNTY PRIOR TO RELOCATION AND SHALL CONFORM TO APPLICABLE STANDARDS AND SPECIFICATIONS OF PASCO COUNTY AND FLORIDA DEPARTMENT OF TRANSPORTATION.
7. PORTIONS OF CONSTRUCTION OF THIS PROJECT, AUTHORIZED BY PERMIT OR LICENSE AGREEMENT, WILL BE SUBJECT TO RELOCATION AND/OR MODIFICATION IF NECESSARY BY THE PERMITTING AGENCY. THE CONTRACTOR SUPERVISORY PERSONNEL SHALL FURNISH INFORMATION TO AND COOPERATE WITH THESE AGENCIES.
8. ANY PUBLIC LAND CORNER WITHIN THE LIMITS OF CONSTRUCTION IS TO BE PROTECTED, IF A CORNER MONUMENT IS IN DANGER OF BEING DESTROYED AND HAS NOT BEEN PROPERLY REFERENCED, THE CONTRACTOR SHALL NOTIFY THE ENGINEER WITHOUT DELAY BY TELEPHONE.
9. ALL DIMENSIONS ARE FROM C/L CONSTRUCTION UNLESS OTHERWISE NOTED.
10. ABBREVIATIONS AND SYMBOLS ARE PER FDOT ROADWAY AND TRAFFIC STANDARDS DATED JANUARY 2000. ABBREVIATIONS AND SYMBOLS NOT IDENTIFIED IN THESE STANDARDS ARE INDICATED BELOW.
11. FOR EXACT PIPE SIZES REFER TO CONTRACT ITEM DESCRIPTIONS OF THE SPECIFICATIONS.

NAME		DATE		NAME		DATE		Issue Certification	PARSONS ENGINEERING SCIENCE, INC. Tampa, Florida (813) 933-4650	
DESIGNED BY	J. BURBY	2/98	DRAWN BY	D. BURNHAM	2/98					
REVIEWED BY	J. LOWE	11/00	CHECKED BY	F. DESANTO	11/00					
APPROVED BY				JEFFERY S. LOWE, P.E.		REG No.: 52017				

TO CONVERT	Multiply By	TO OBTAIN
centimeters	3.281×10^{-2}	feet
centimeters	0.3937	inches
centimeters	10^{-5}	kilometers
centimeters	0.01	meters
centimeters	6.214×10^{-6}	miles
centimeters	10.0	millimeters
cubic centimeters	3.531×10^{-5}	cu feet
cubic centimeters	0.06102	cu inches
cubic centimeters	10^{-6}	cu meters
cubic centimeters	1.308×10^{-6}	cu yards
cubic feet	1.728, 0	cu inches
cubic feet	0.02832	cu meters
cubic feet	0.03704	cu yards
cubic meters	35.31	cu feet
cubic meters	61,023.0	cu inches
cubic meters	1.308	cu yards
feet	30.48	centimeters
feet	3.048×10^{-4}	kilometers
feet	0.3048	meters
feet	1.645×10^{-4}	miles (naut)
feet	1.894×10^{-4}	miles (stat)
feet	304.8	millimeters
feet/sec	30.48	cm/sec
inches	25.4×10^3	μm
inches	2.540	centimeters
inches	2.540×10^{-2}	meters
inches	1.578×10^{-5}	miles
inches	25.4	millimeters
kilograms	0.001	metric ton
kilograms	2.205	pounds
kilograms/meter	0.6720	pounds/ft
kilograms/cu meter	6.24×10^{-2}	pounds/cu ft
kPa	0.145	psi
MPa	145	psi
meters	100.0	centimeters
meters	3.281	feet
meters	39.37	inches
meters	0.001	kilometers
meters	1.0000	millimeters
mils	0.001	inches
mils	25.4×10^{-3}	millimeters
pounds	0.4536	kilograms
pounds/cu ft	16.02	kgs/cu meter
pounds/sq in	703.1	kgs/sq meter
tons (metric)	1,000.0	kilograms
tons (metric)	2,205.0	pounds

Temperature Conversions: $^{\circ}\text{F} = 32 + \left(\frac{9}{5}\right)^{\circ}\text{C}$


$^{\circ}\text{C} = \frac{5}{9} (^{\circ}\text{F} - 32)$

RT.

RESTRAINED JOINT PIPE


RECORD DRAWING - 06/03

STATE ROAD NO. 54 - US 19 TO MADISON WATER & FORCE MAIN UTILITY ADJUSTMENTS	SHEET NO.
SUMMARY OF QUANTITIES/GENERAL NOTES	G-2

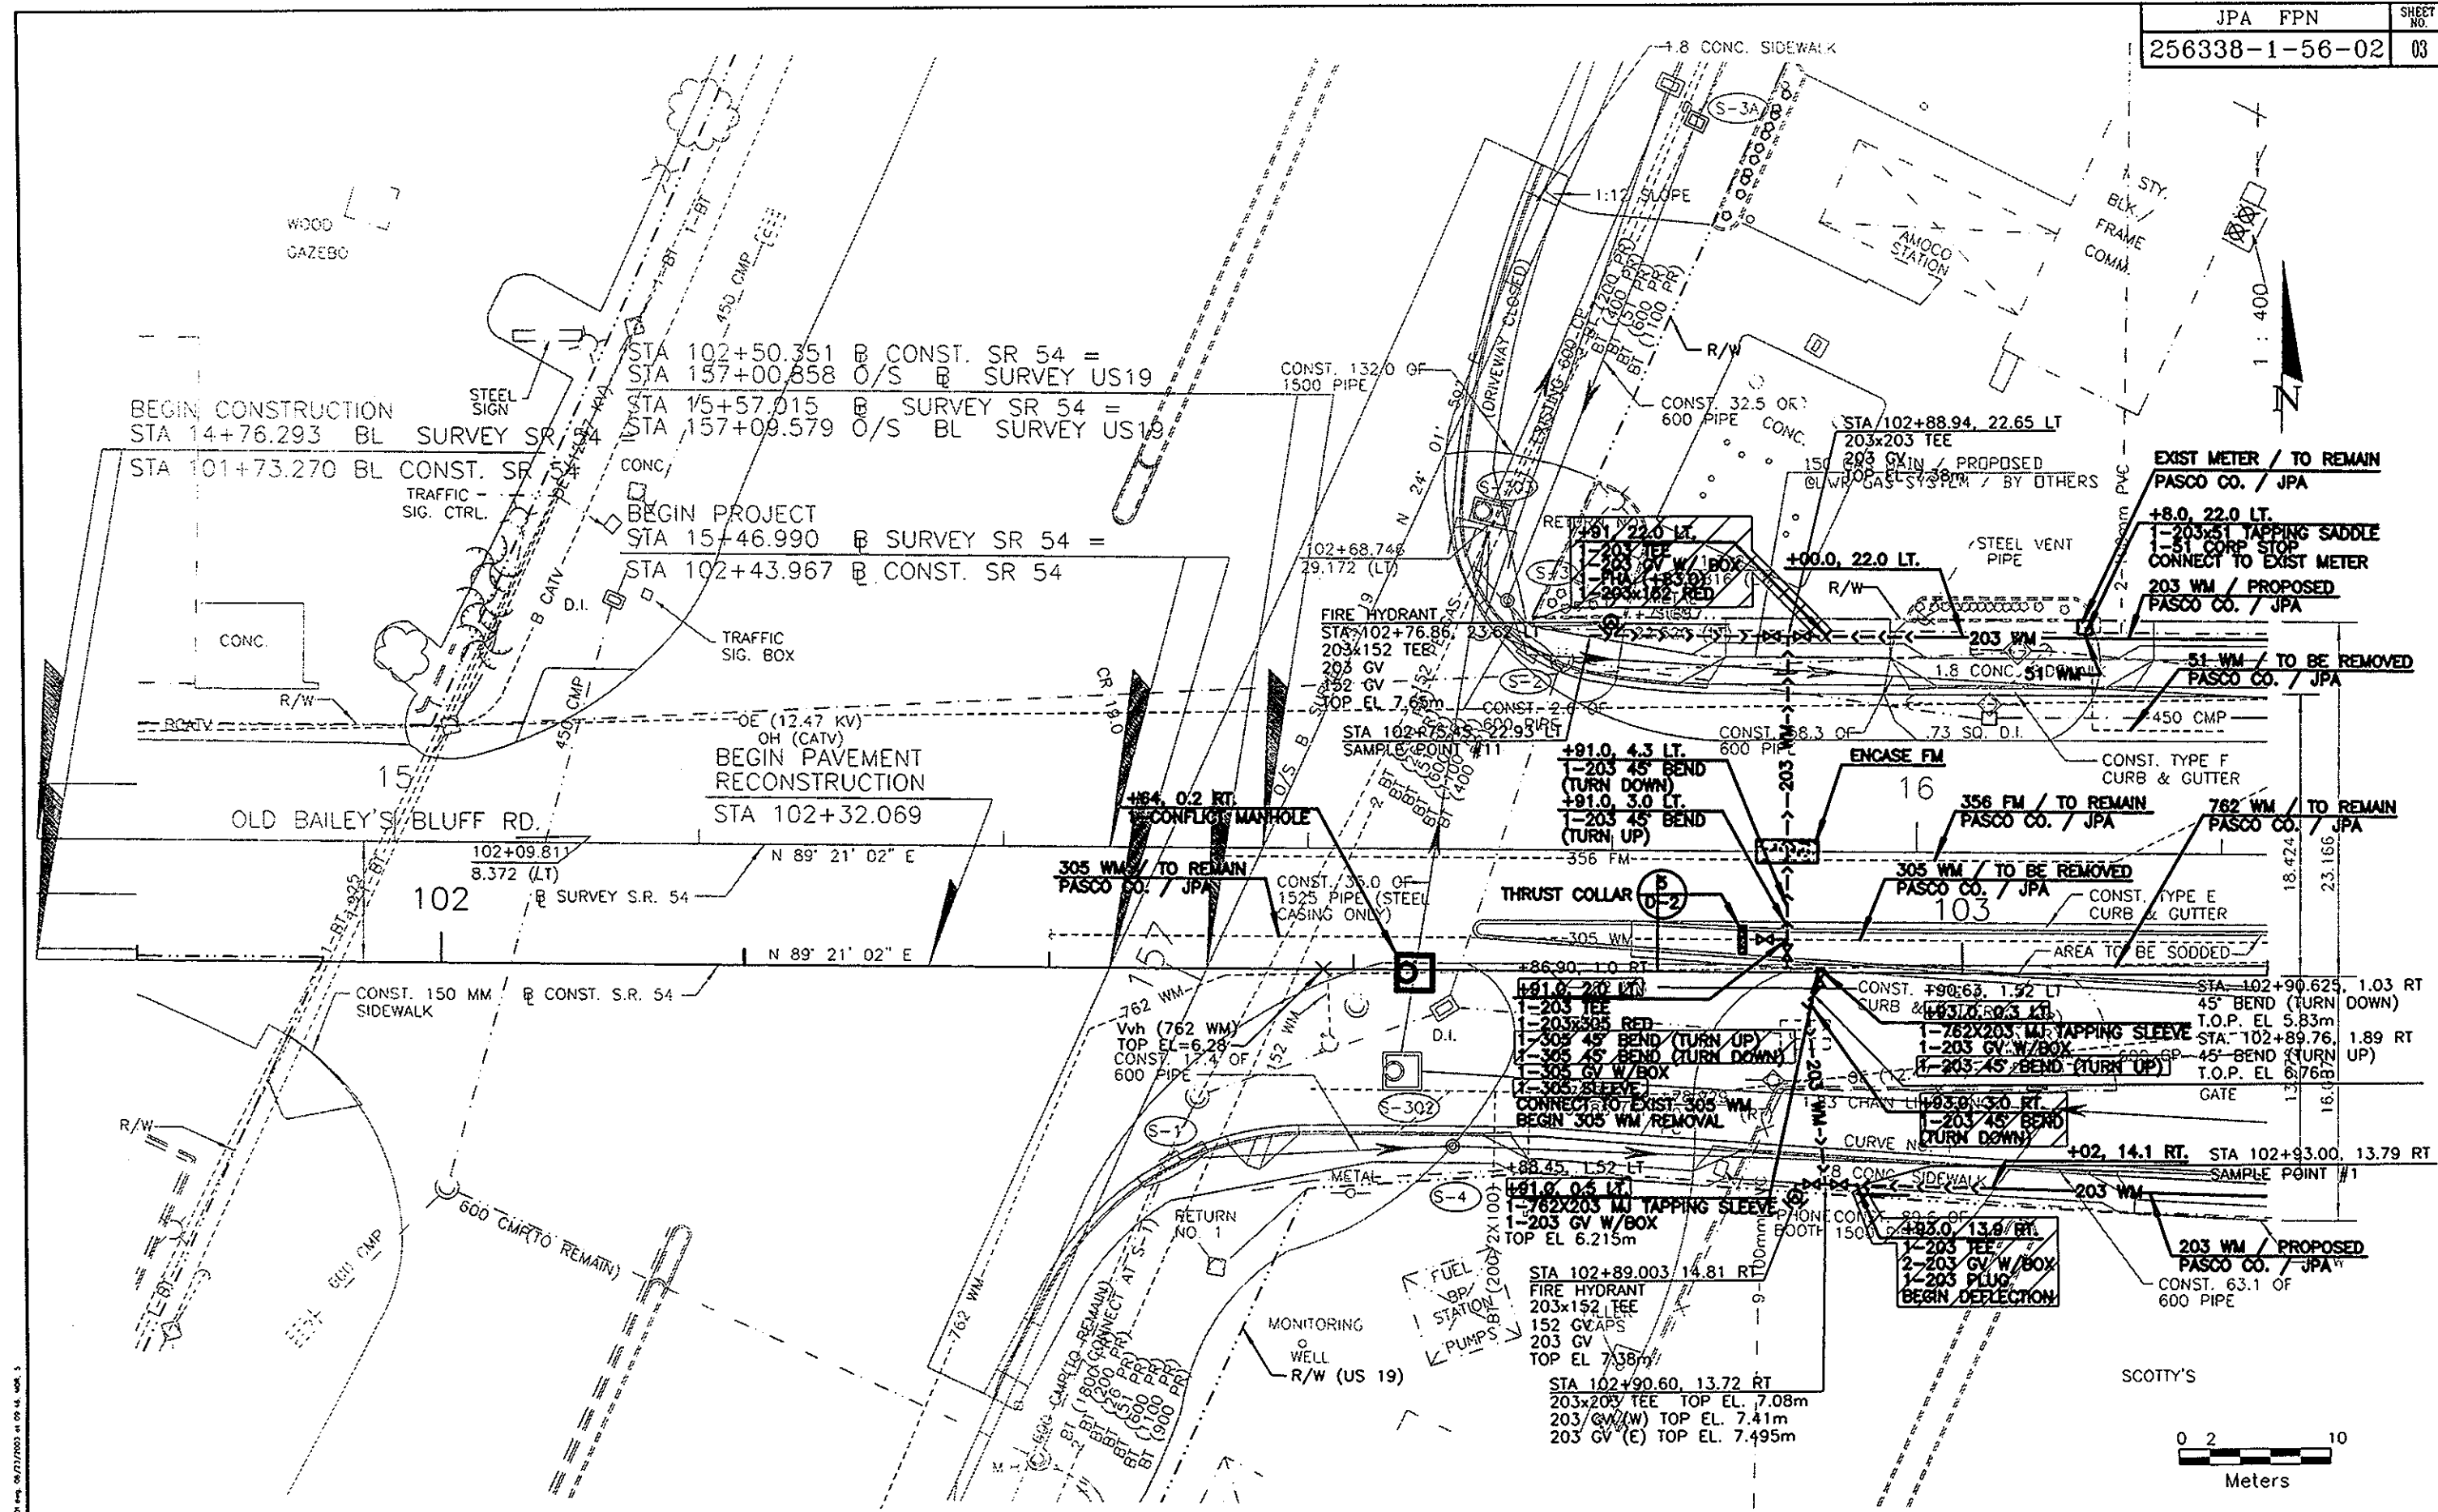

RECORD DRAWING - 06/03

REVISIONS												DESIGNED				CHECKED				APPROVED				Issue Certification		PARSONS ENGINEERING SCIENCE, INC.		 PASCO COUNTY UTILITIES CONSTRUCTION		STATE ROAD NO. 54 - US 19 TO MADISON		SHEET NO.																																																																																																																																																																																																																																																																																																																																																																																																																																																																																																																																																																																																																																																																																																																																																																																																									
DATE	BY	DESCRIPTION	DATE	BY	DESCRIPTION	DATE	BY	

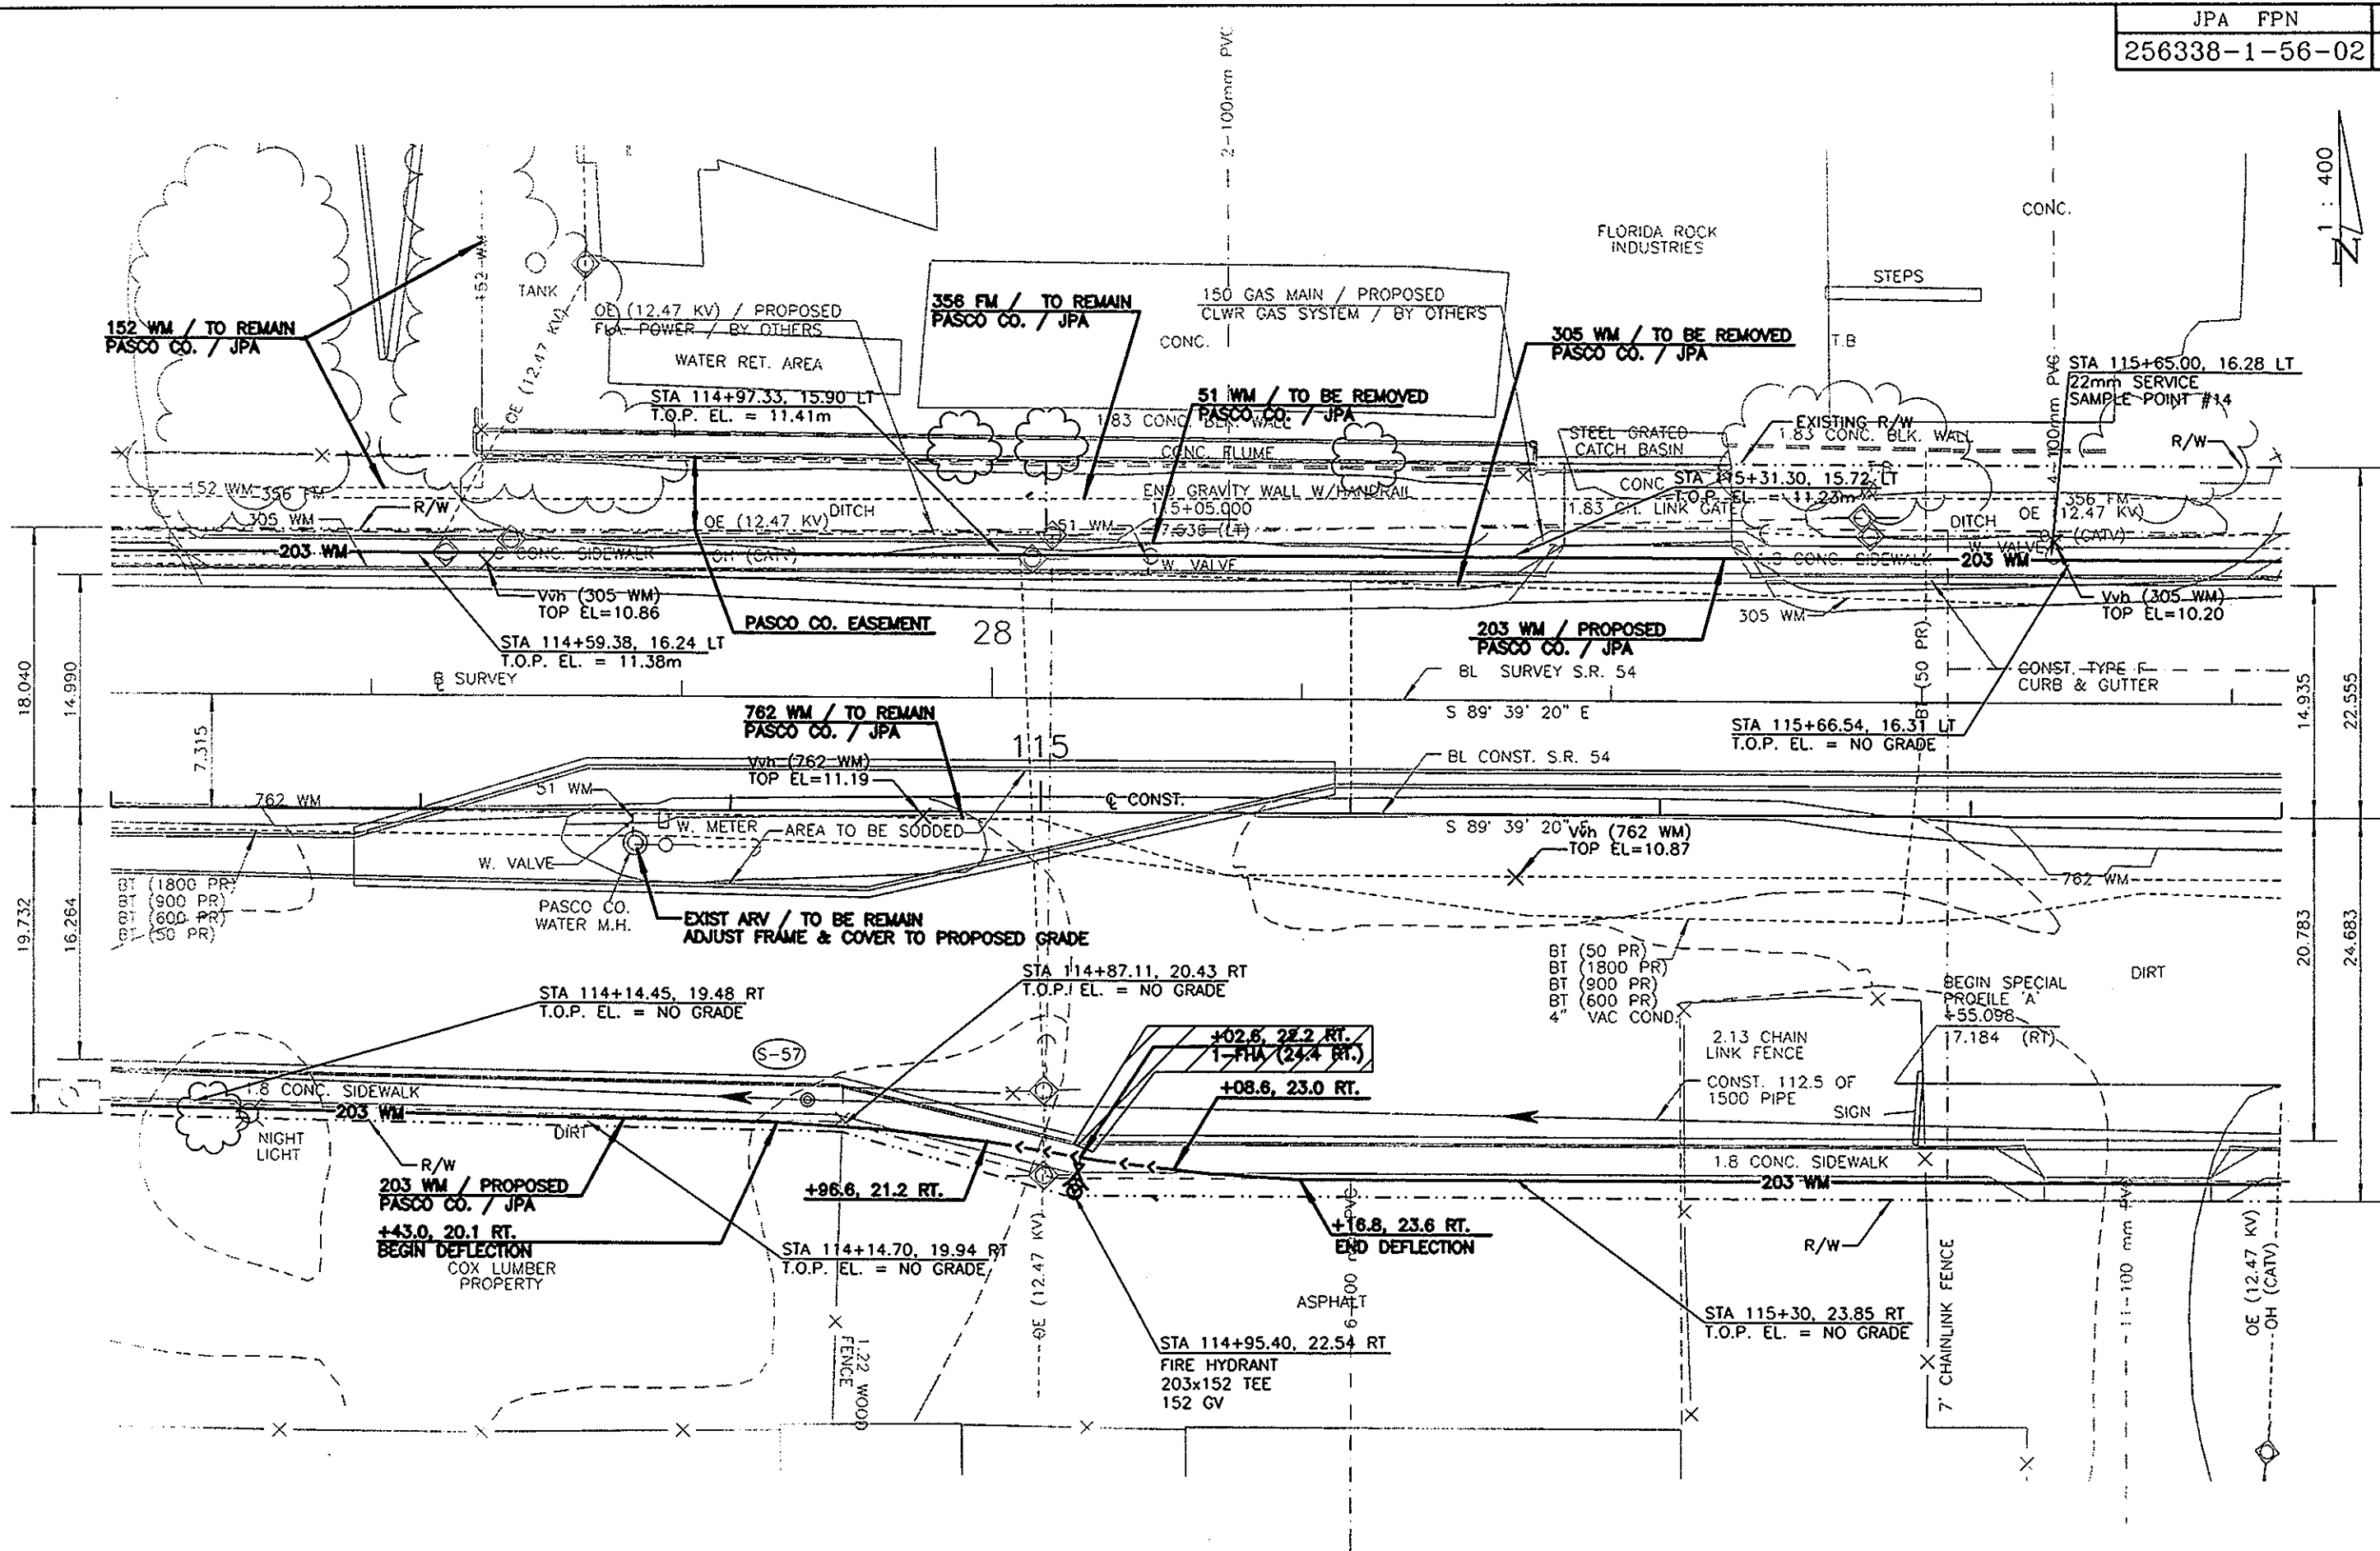


RECORD DRAWING - 06/03


NO. XREF'S
J:\CADD\732136\RECORD\213SP10.dwg, 06/23/2003 at 11:44, MDR, 10


REVISIONS						REVISIONS						REVISIONS					
DATE	BY	DESCRIPTION	DATE	BY	DESCRIPTION	DATE	BY	DESCRIPTION	DATE	BY	DESCRIPTION	DATE	BY	DESCRIPTION	DATE	BY	DESCRIPTION
06/03	JSL	RECORD DRAWING (SEE NOTES ON TITLE SHEET)															
11/00	JSL	RELEASED FOR BIDDING/CONSTRUCTION															


DESIGNED BY J. BURBY 2/98	CHECKED BY D. BURNHAM 2/98	ISSUE CERTIFICATION	PARSONS ENGINEERING SCIENCE, INC. Tampa, Florida (813) 933-4650
REVIEWED BY J. LOWE 11/00	DESIGNED BY F. DeSANTO 11/00	APPROVED BY JEFFERY S. LOWE, P.E. REG. NO. 52017	PASCO COUNTY UTILITIES CONSTRUCTION 2300 LITTLE ROAD NEW PORT RICHEY, FLORIDA 34654


STATE ROAD NO. 54 - US 19 TO MADISON WATER & FORCE MAIN UTILITY ADJUSTMENTS PLAN SHEET - STA 114+40 TO STA 115+80	SHEET NO. P-10
--	-------------------

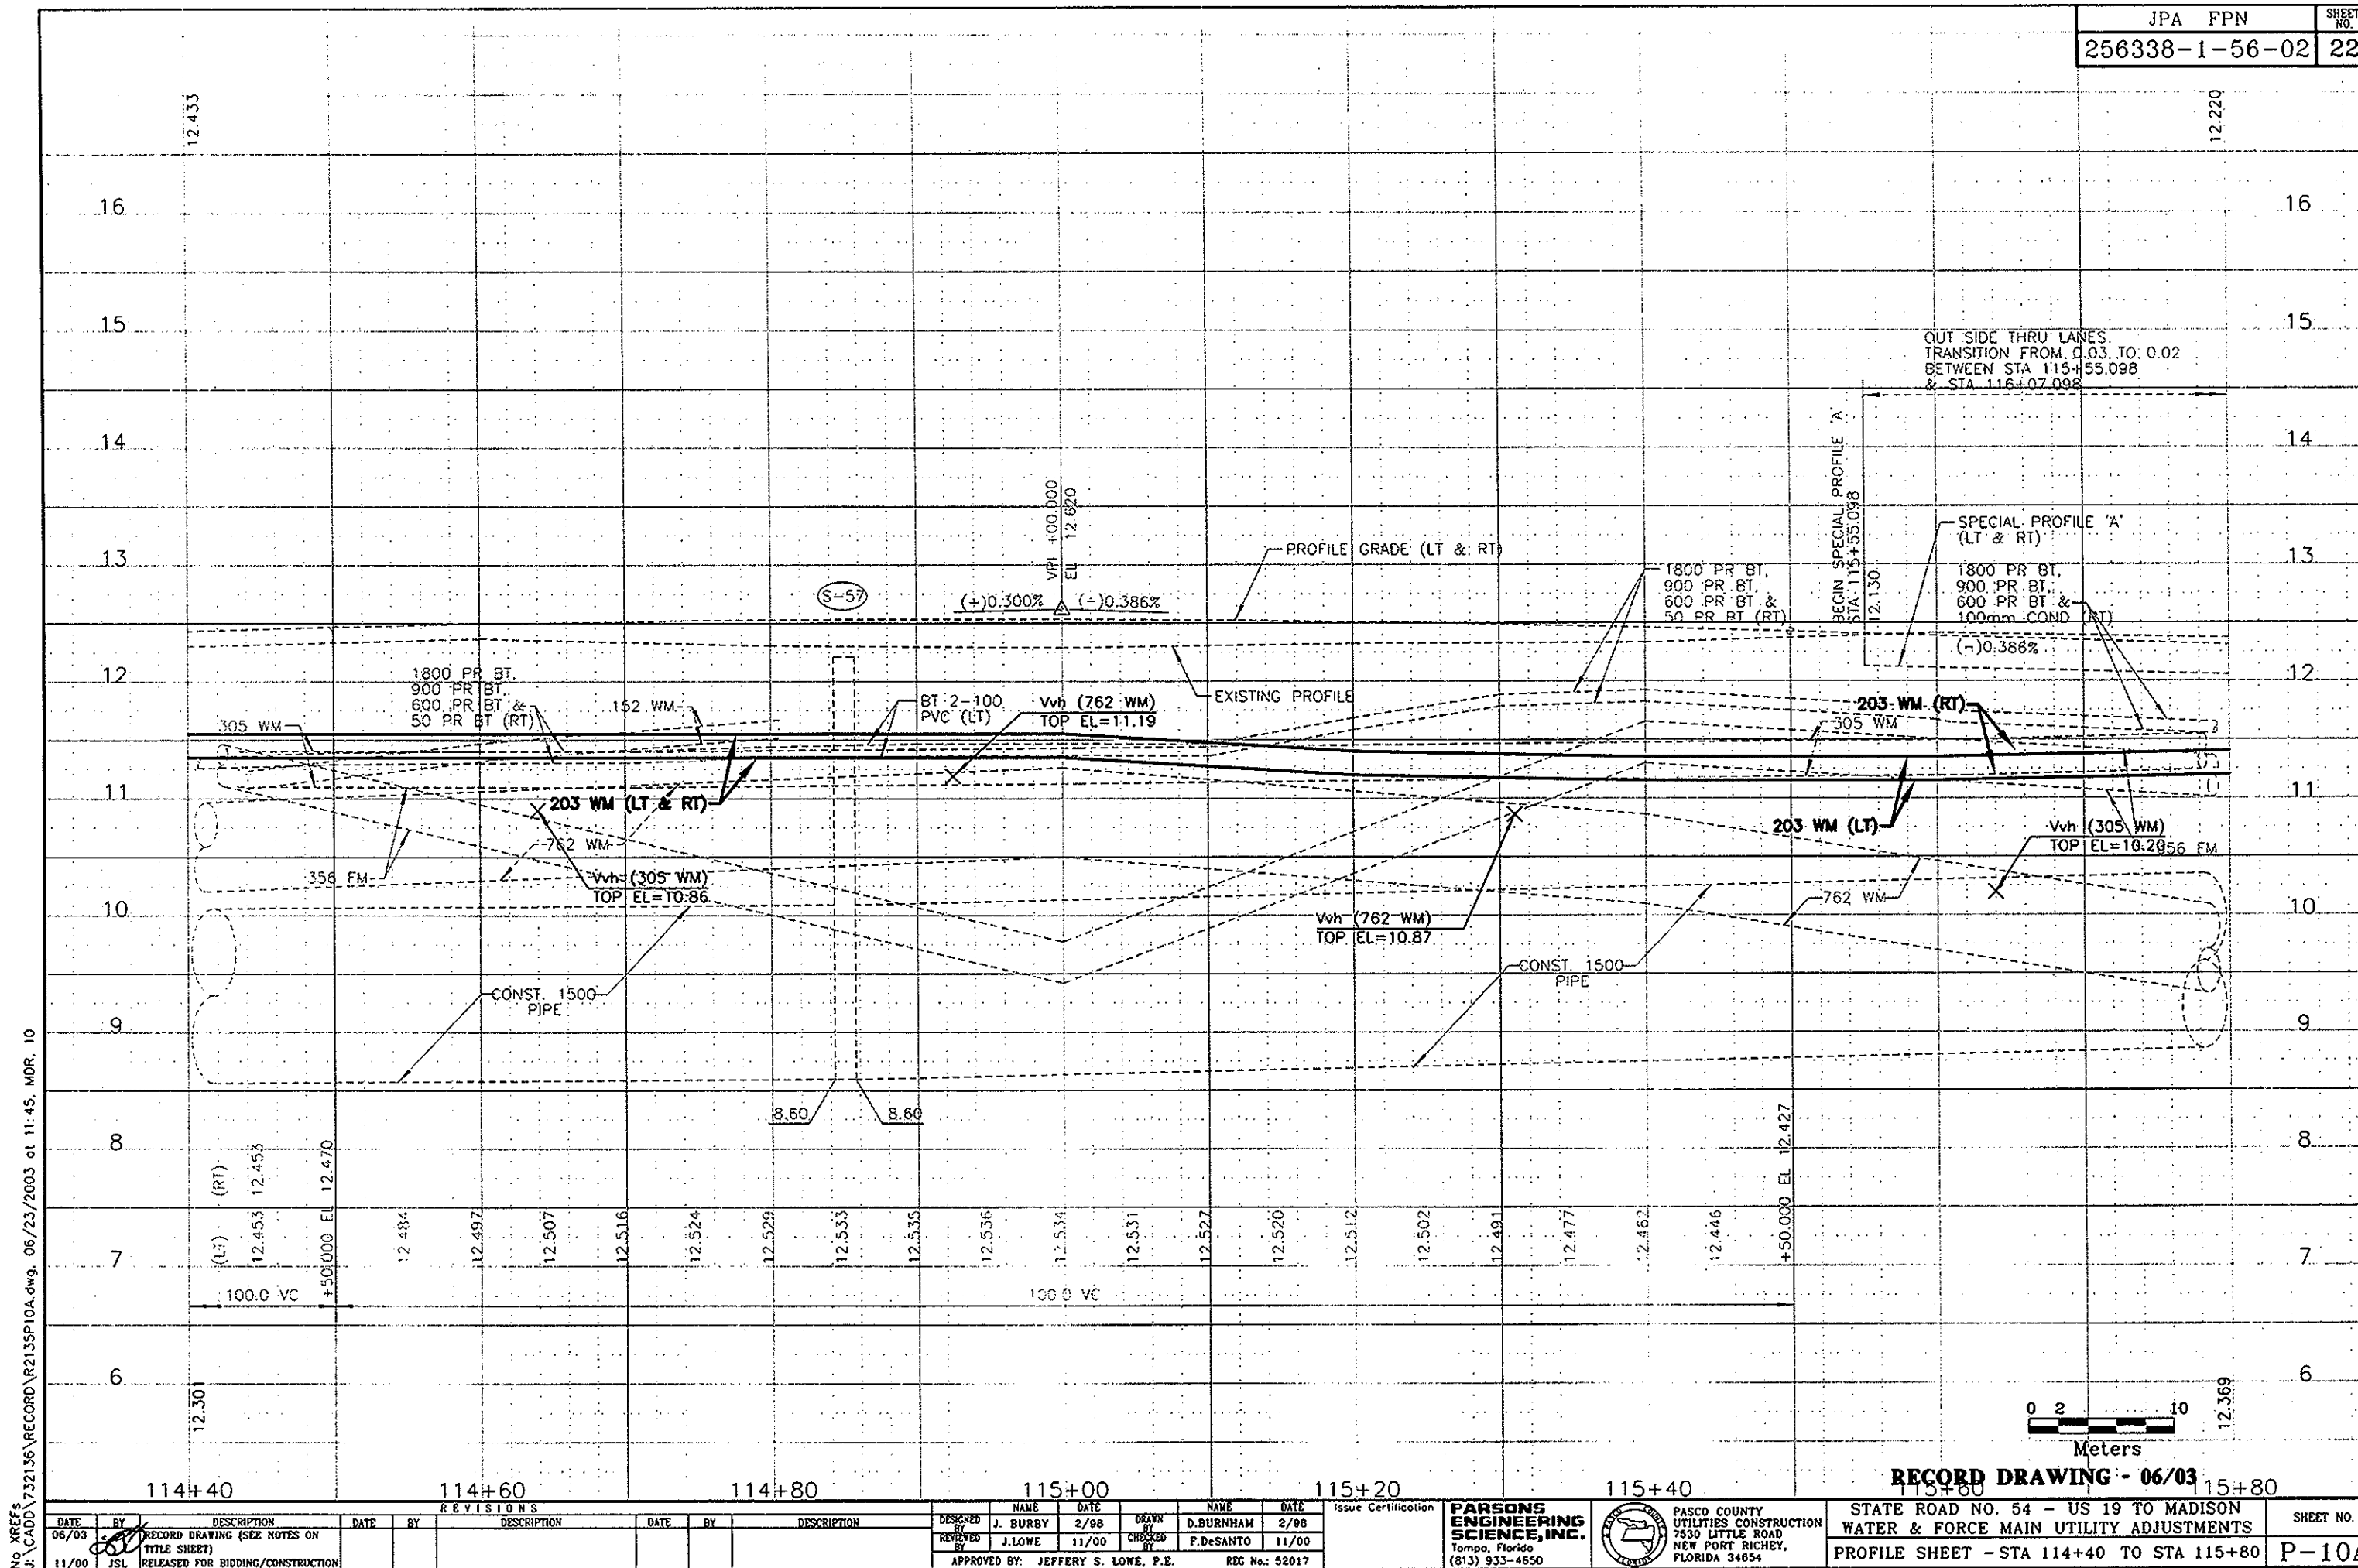

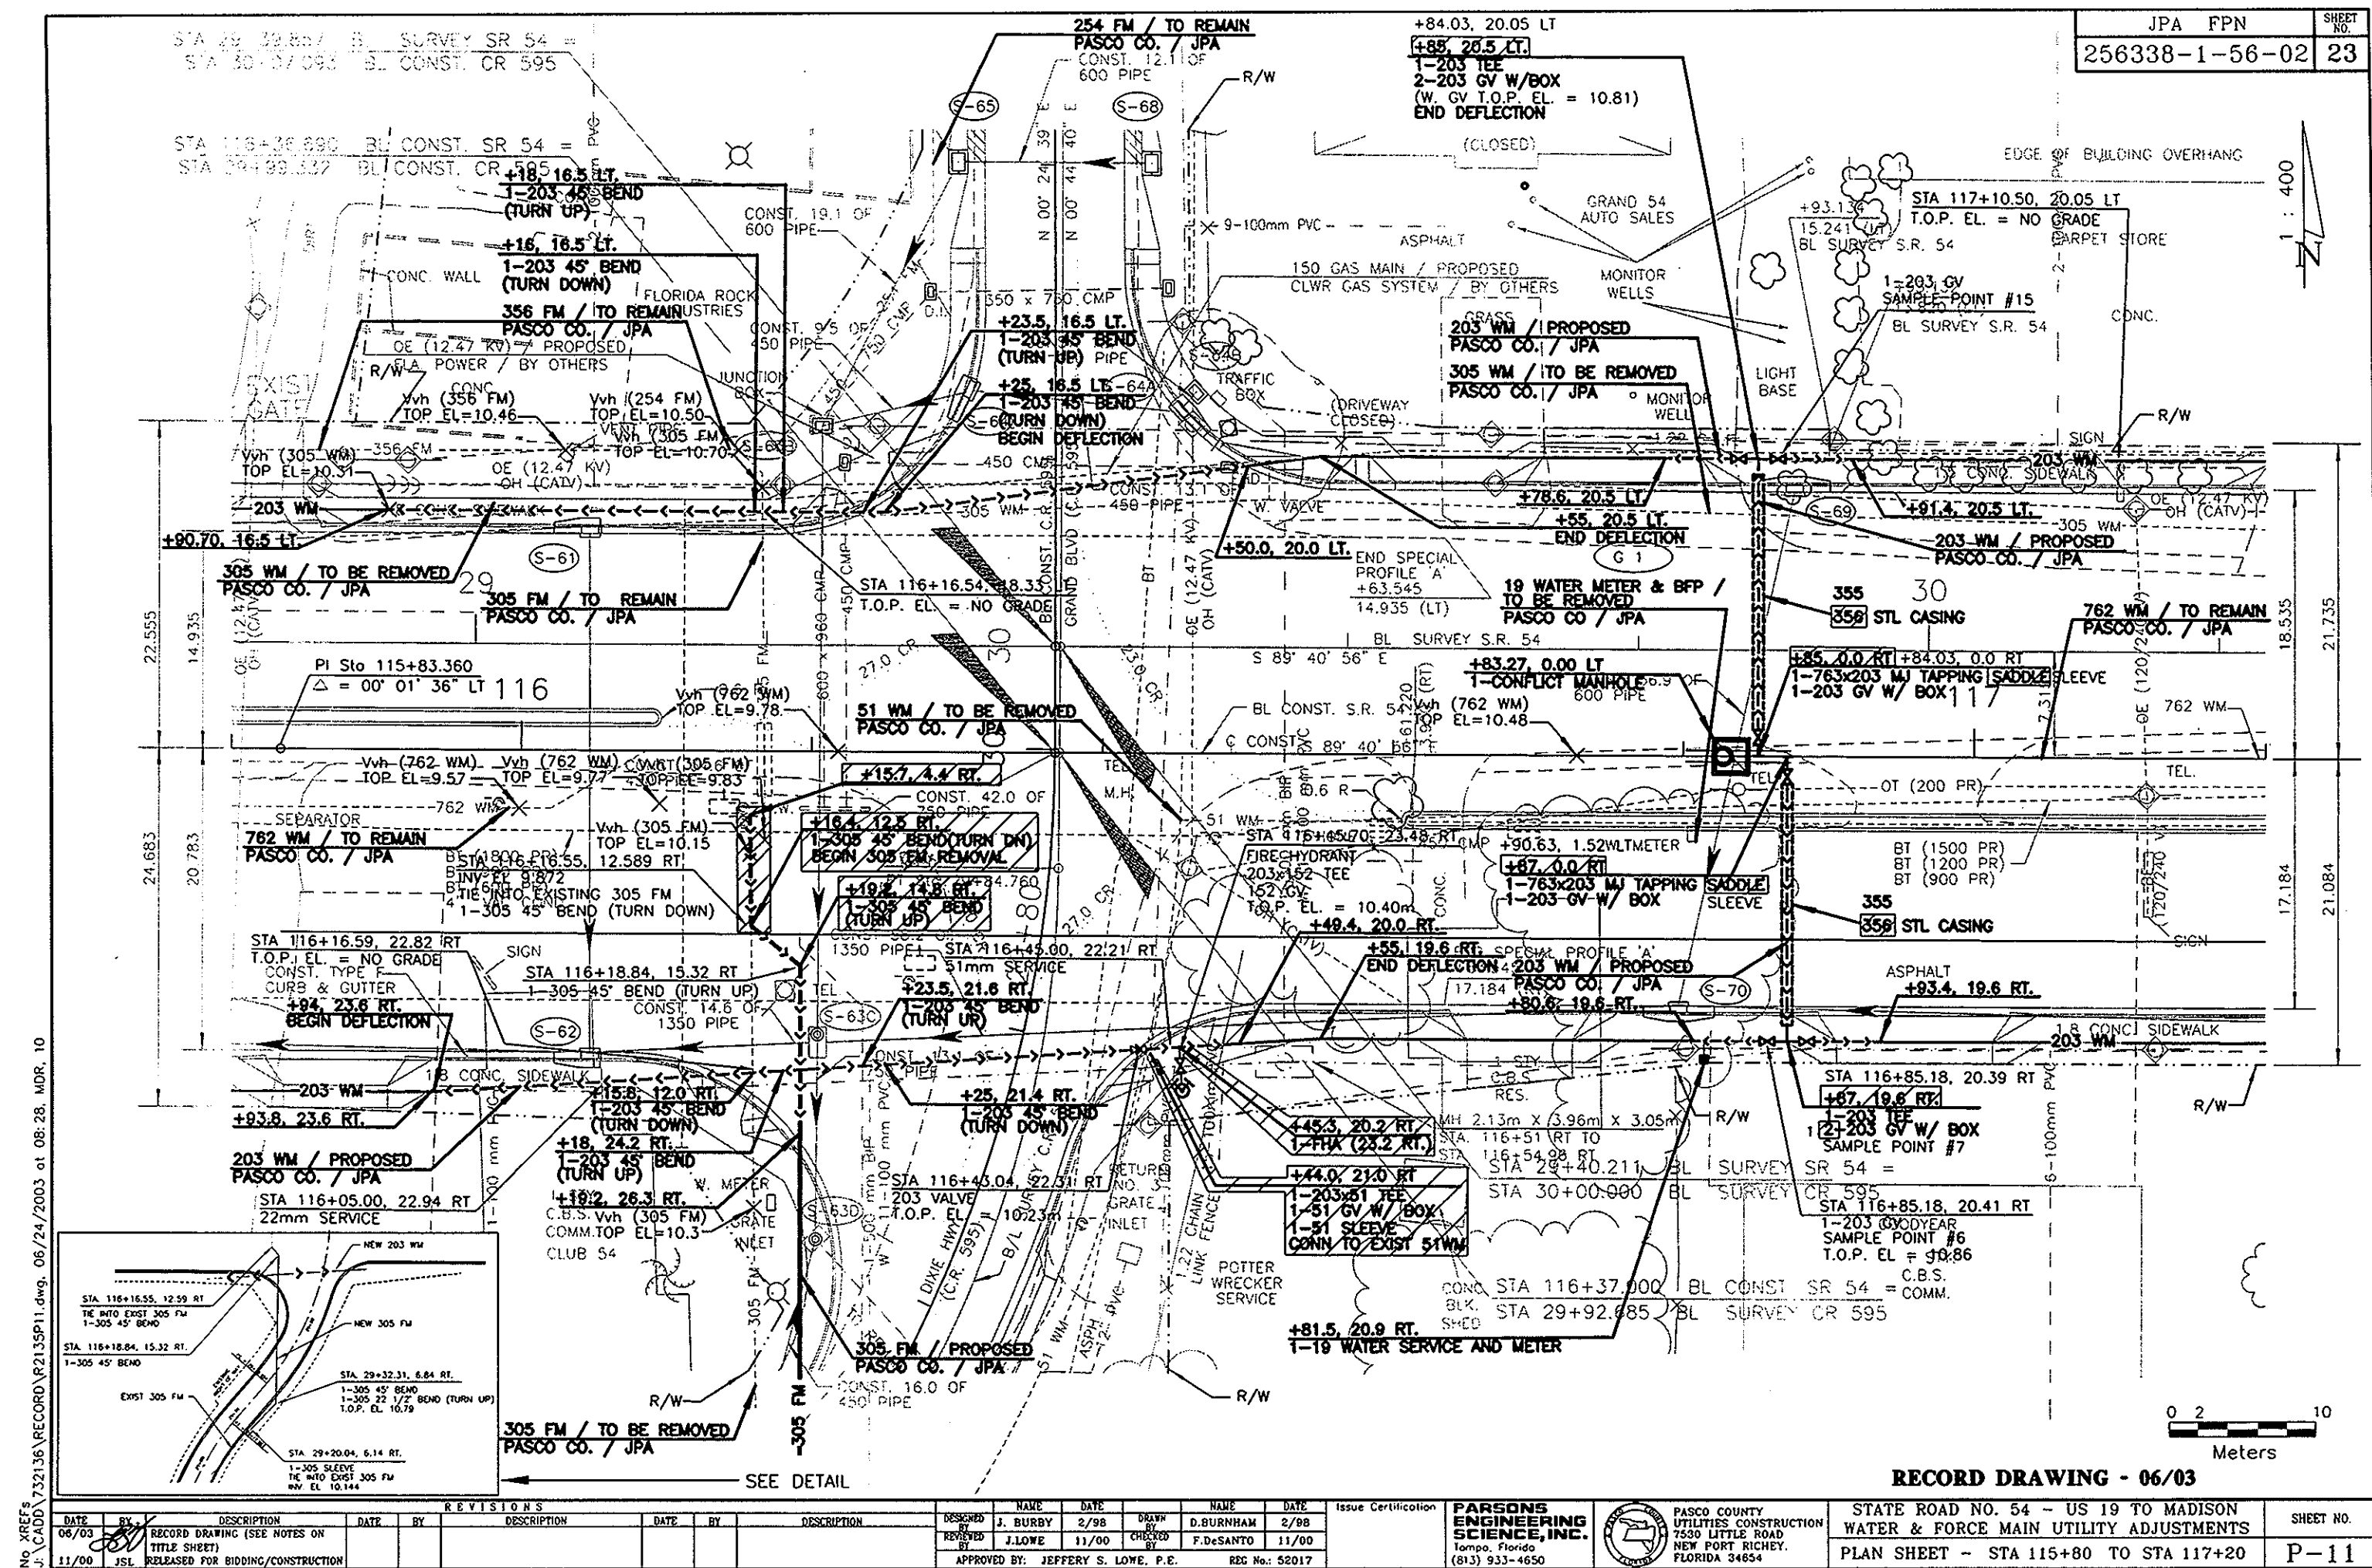

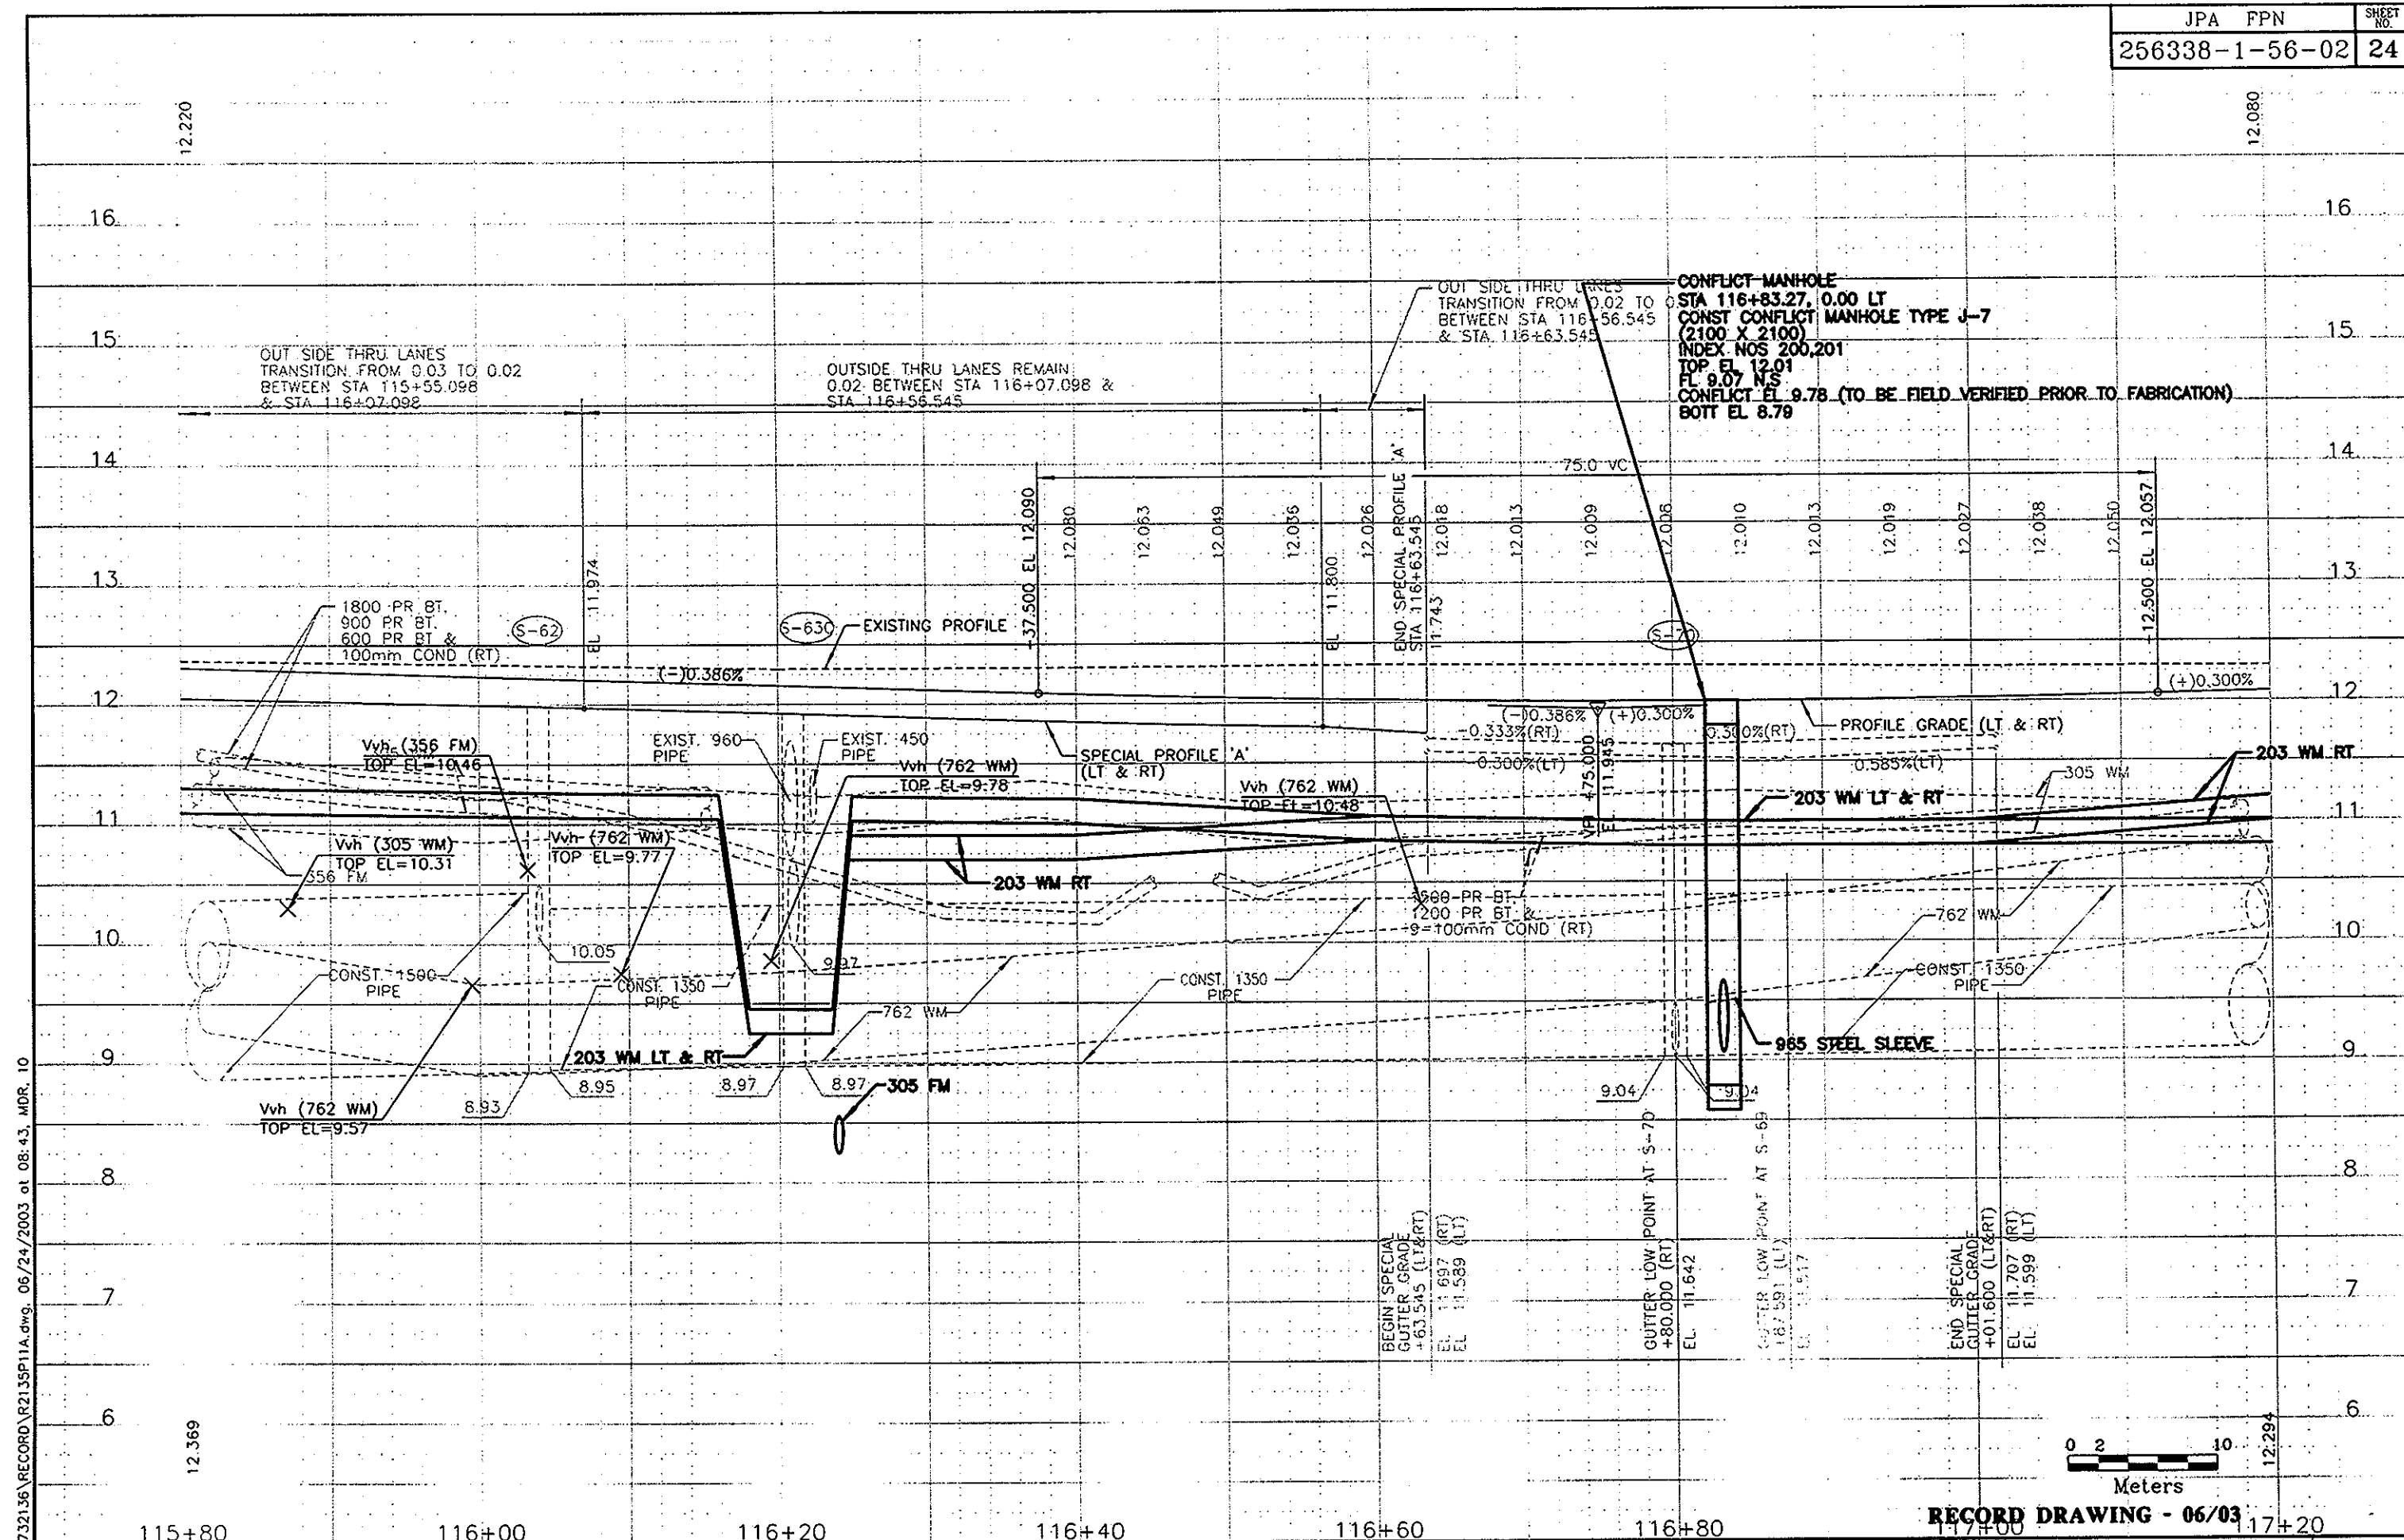

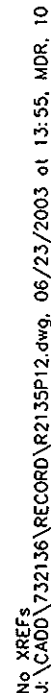


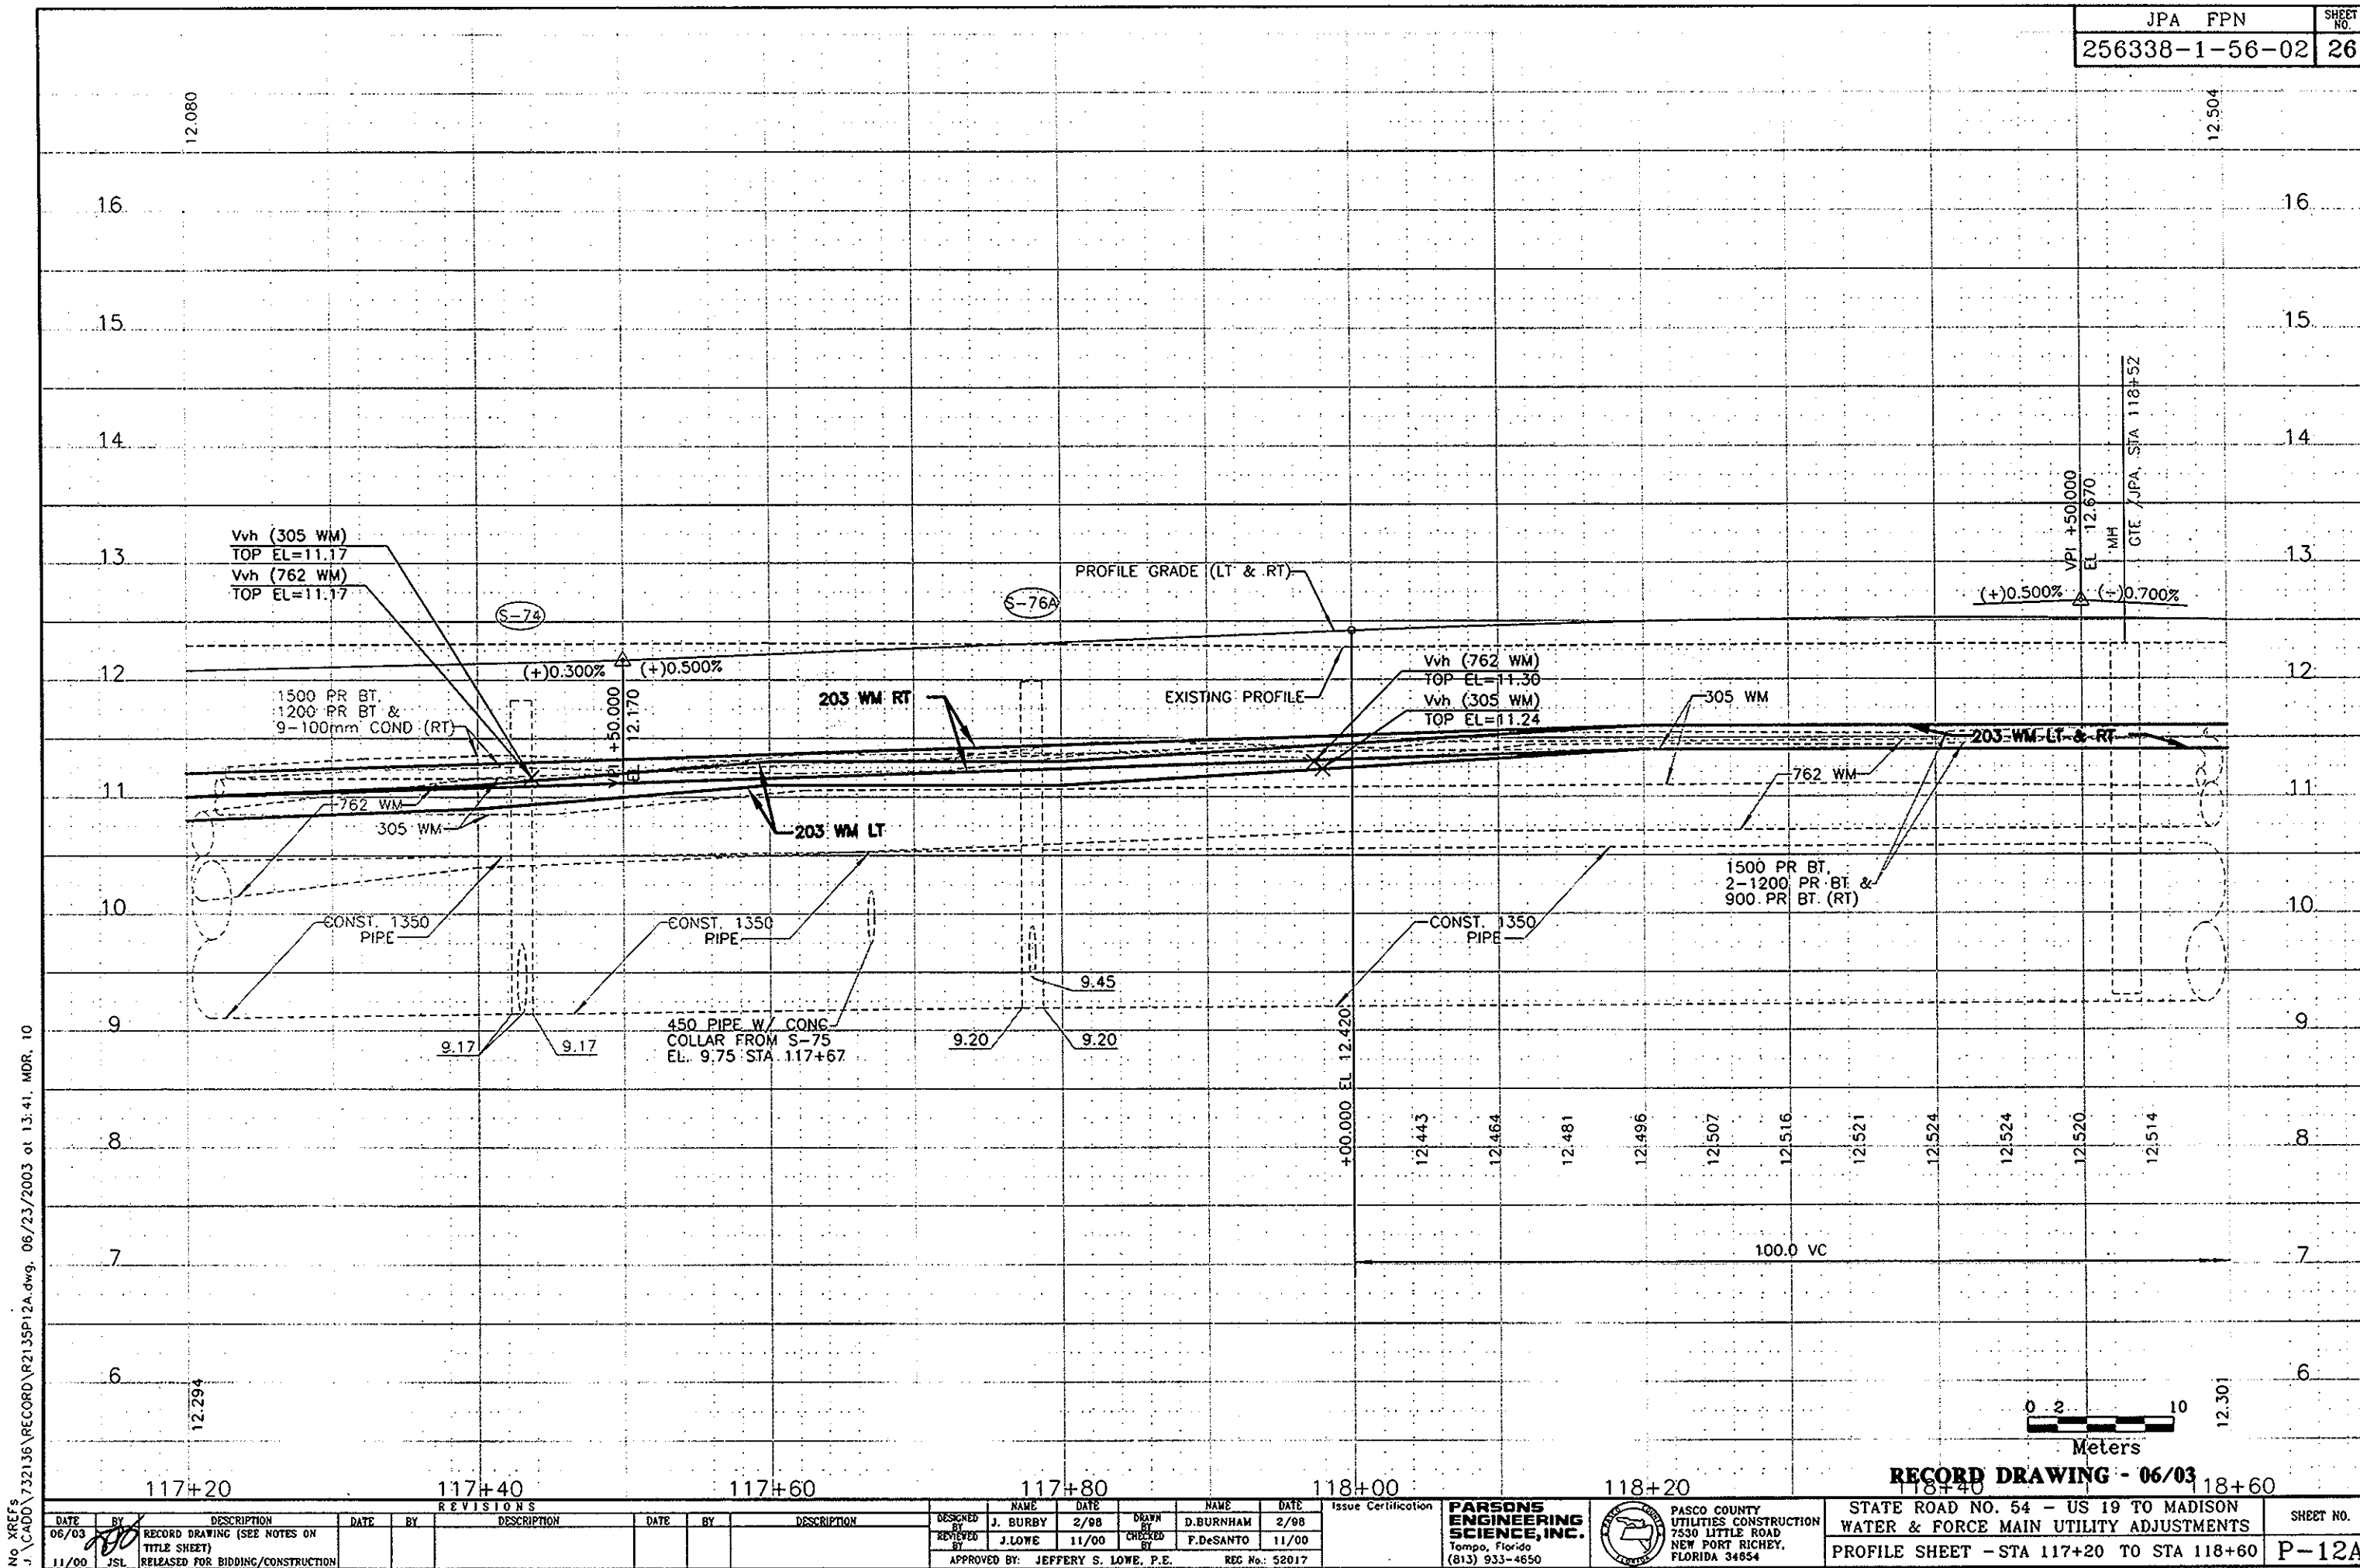



RECORD DRAWING - 06/03

REVISIONS												Issue Certification		 PARSONS ENGINEERING SCIENCE, INC. 7530 LITTLE ROCK NEWPORT RICHEY, FLORIDA 34654 (813) 933-4650		 PASCO COUNTY UTILITIES CONSTRUCTION 7530 LITTLE ROCK NEWPORT RICHEY, FLORIDA 34654		STATE ROAD NO. 54 - US 19 TO MADISON WATER & FORCE MAIN UTILITY ADJUSTMENTS PLAN SHEET - STA 118+60 TO STA 120+00		SHEET NO. P-13	
DATE	BY	DESCRIPTION	DATE	BY	DESCRIPTION	DATE	BY	DESCRIPTION	DESCRIBED	DATE	BY	DESCRIPTION									
06/00	CS	RECORD DRAWING (SEE NOTES ON TITLE SHEET)							J. BURBY	2/08	DRAWN	D.BURNHAM	2/08								
11/00	JSL	PREPARED FOR BIDDING/CONSTRUCTION							J.LOWE	11/00	CHECKED	P.DESANTO	11/00								
APPROVED BY: JEFFERY S. LOWE, P.E. REG. NO. 52017																					

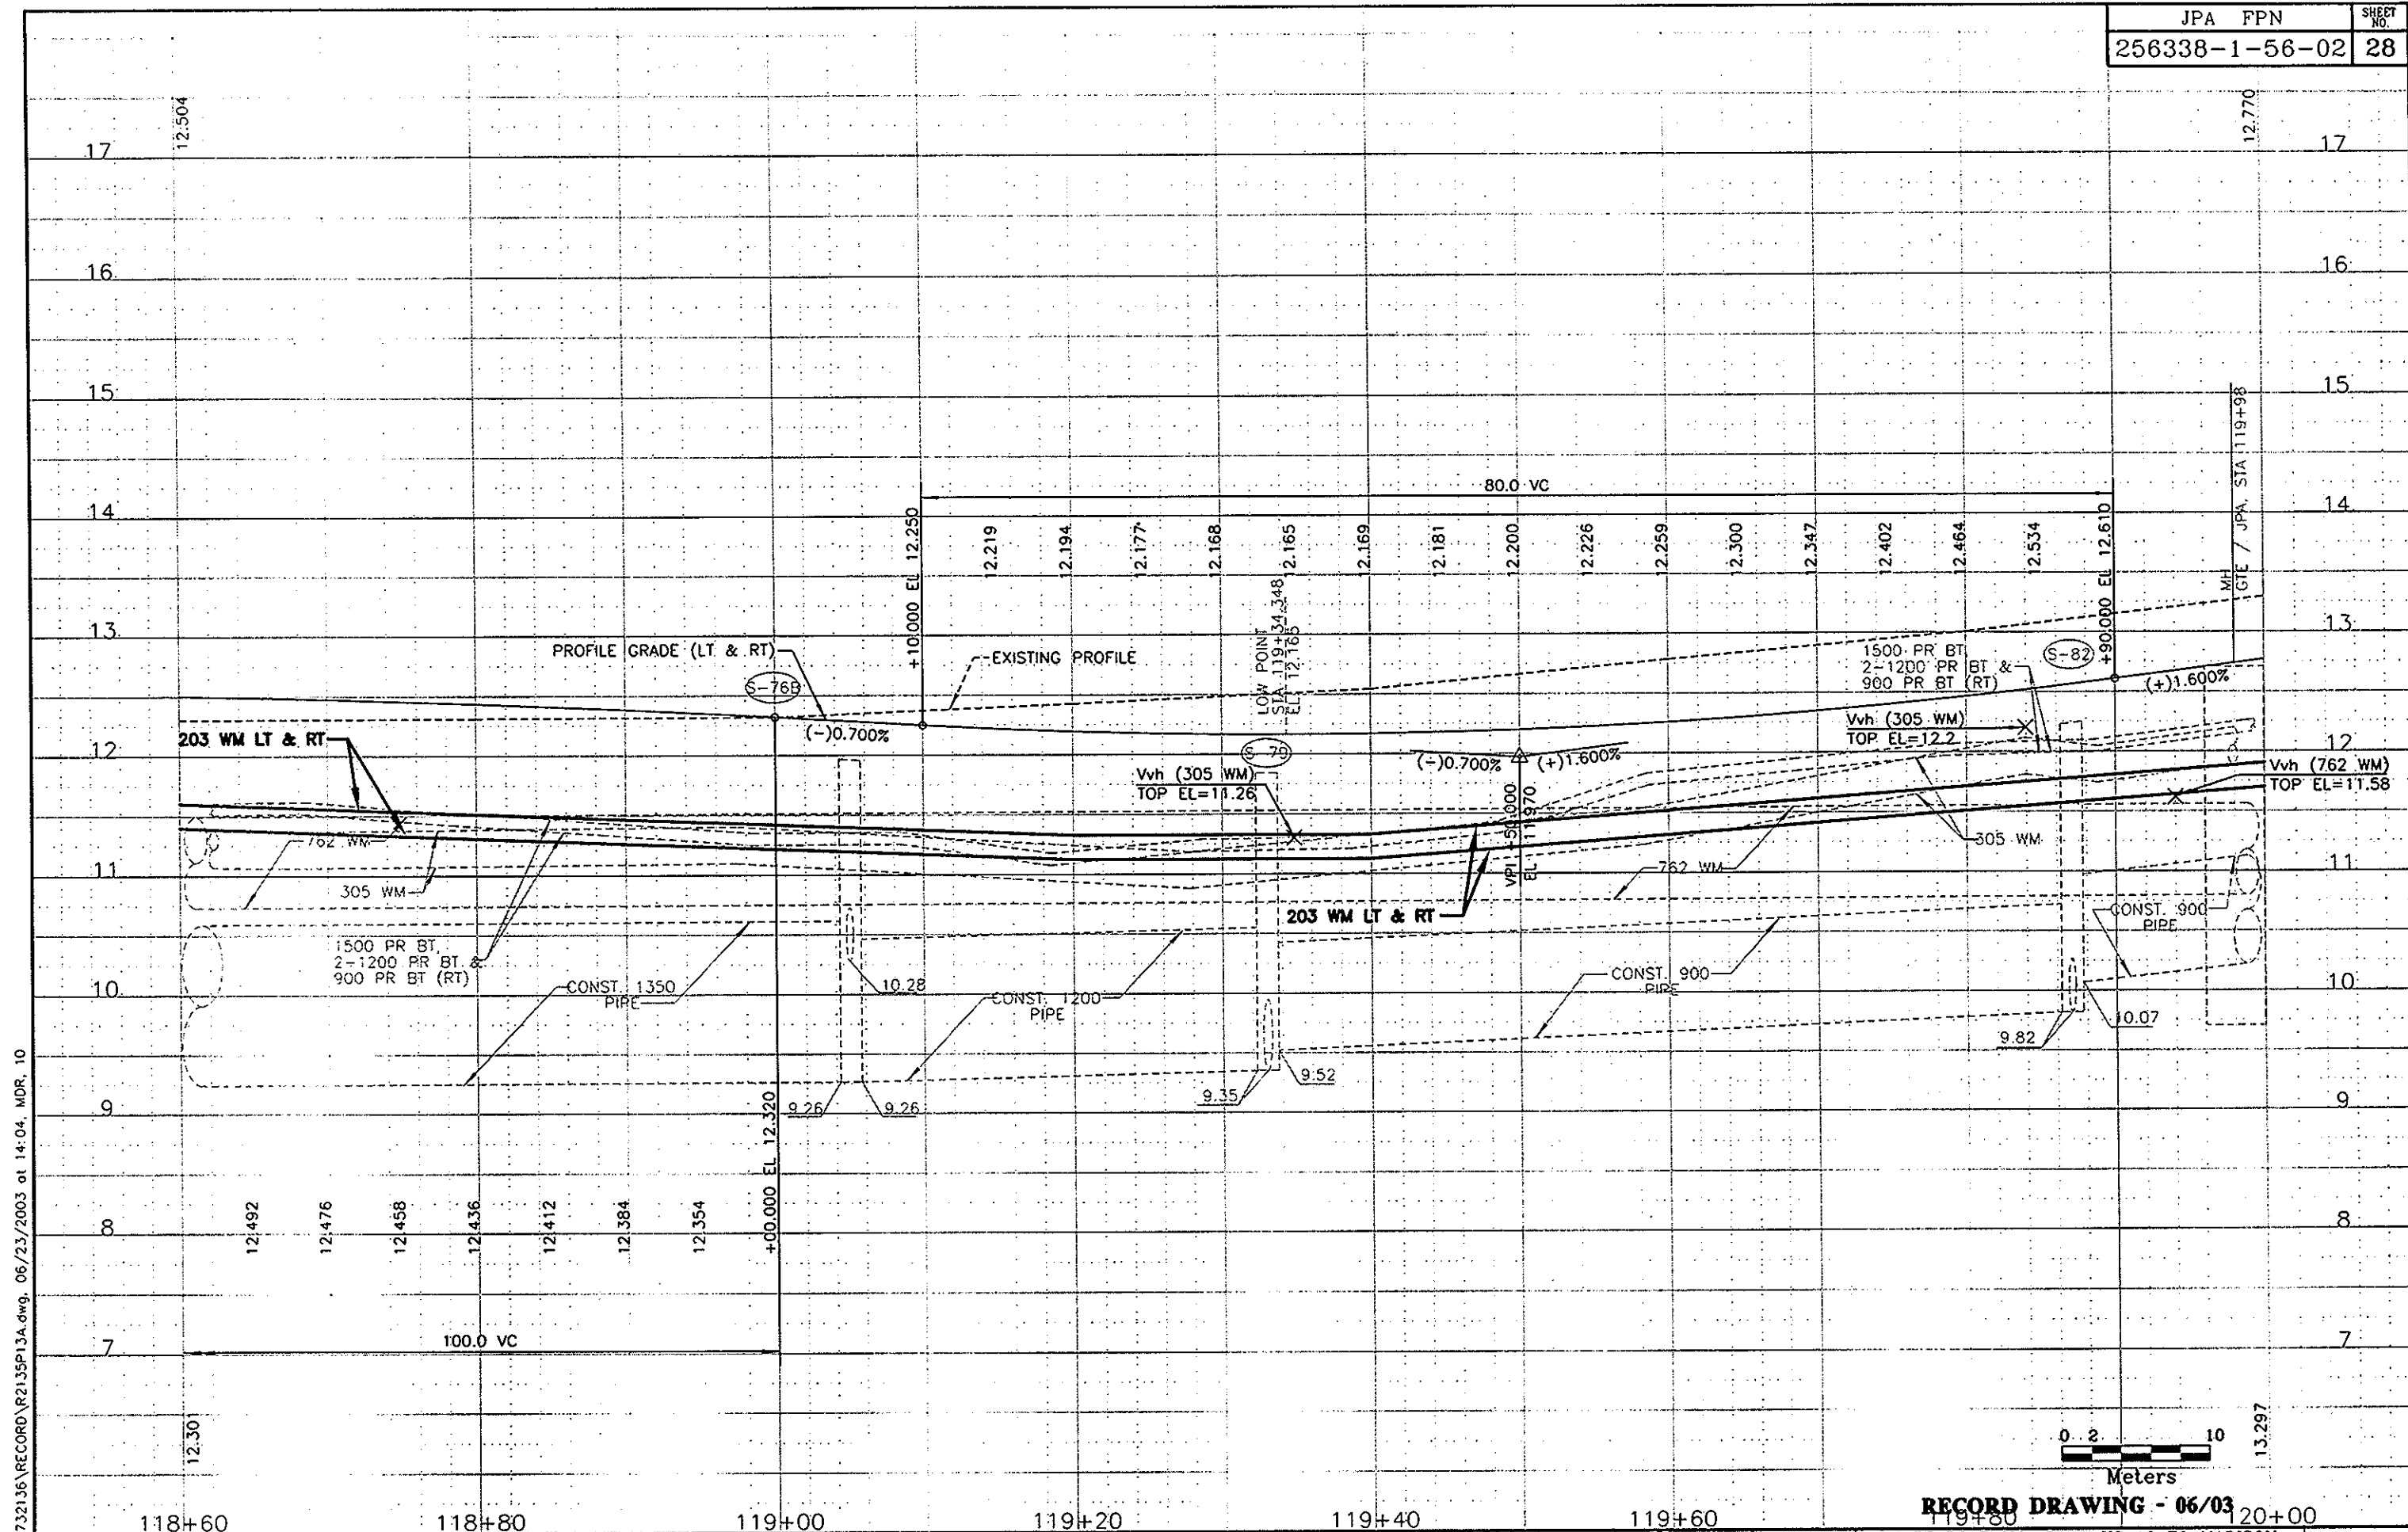



NO XREFS
J:\CADD\732136\RECORD\732136P13A.dwg, 06/23/2003 at 14:04, WDR, 10


REVISIONS				REVISIONS				REVISIONS			
DATE	BY	DESCRIPTION	DATE	BY	DESCRIPTION	DATE	BY	DESCRIPTION	DATE	BY	DESCRIPTION
06/03	JSL	RECORD DRAWING (SEE NOTES ON TITLE SHEET)	11/00	JSL	RELEASED FOR BIDDING/CONSTRUCTION						
APPROVED BY: JEFFERY S. LOWE, P.E.				APPROVED BY: JEFFERY S. LOWE, P.E.				APPROVED BY: JEFFERY S. LOWE, P.E.			
REG No.: 52017				REG No.: 52017				REG No.: 52017			

DESIGNED BY: J. BURBY	DATE: 2/98	DRAWN BY: D. BURNHAM	DATE: 2/98
REVIEWED BY: J. LOWE	DATE: 11/00	CHECKED BY: F. DeSANTO	DATE: 11/00
Issue Certification			
PARSONS ENGINEERING SCIENCE, INC.			
PASCO COUNTY UTILITIES CONSTRUCTION			
7530 LITTLE ROAD NEW PORT RICHEY, FLORIDA 34654			

STATE ROAD NO. 54 - US 19 TO MADISON	SHEET NO.
WATER & FORCE MAIN UTILITY ADJUSTMENTS	
PROFILE SHEET - STA 118+50 TO STA 120+00	P-13A

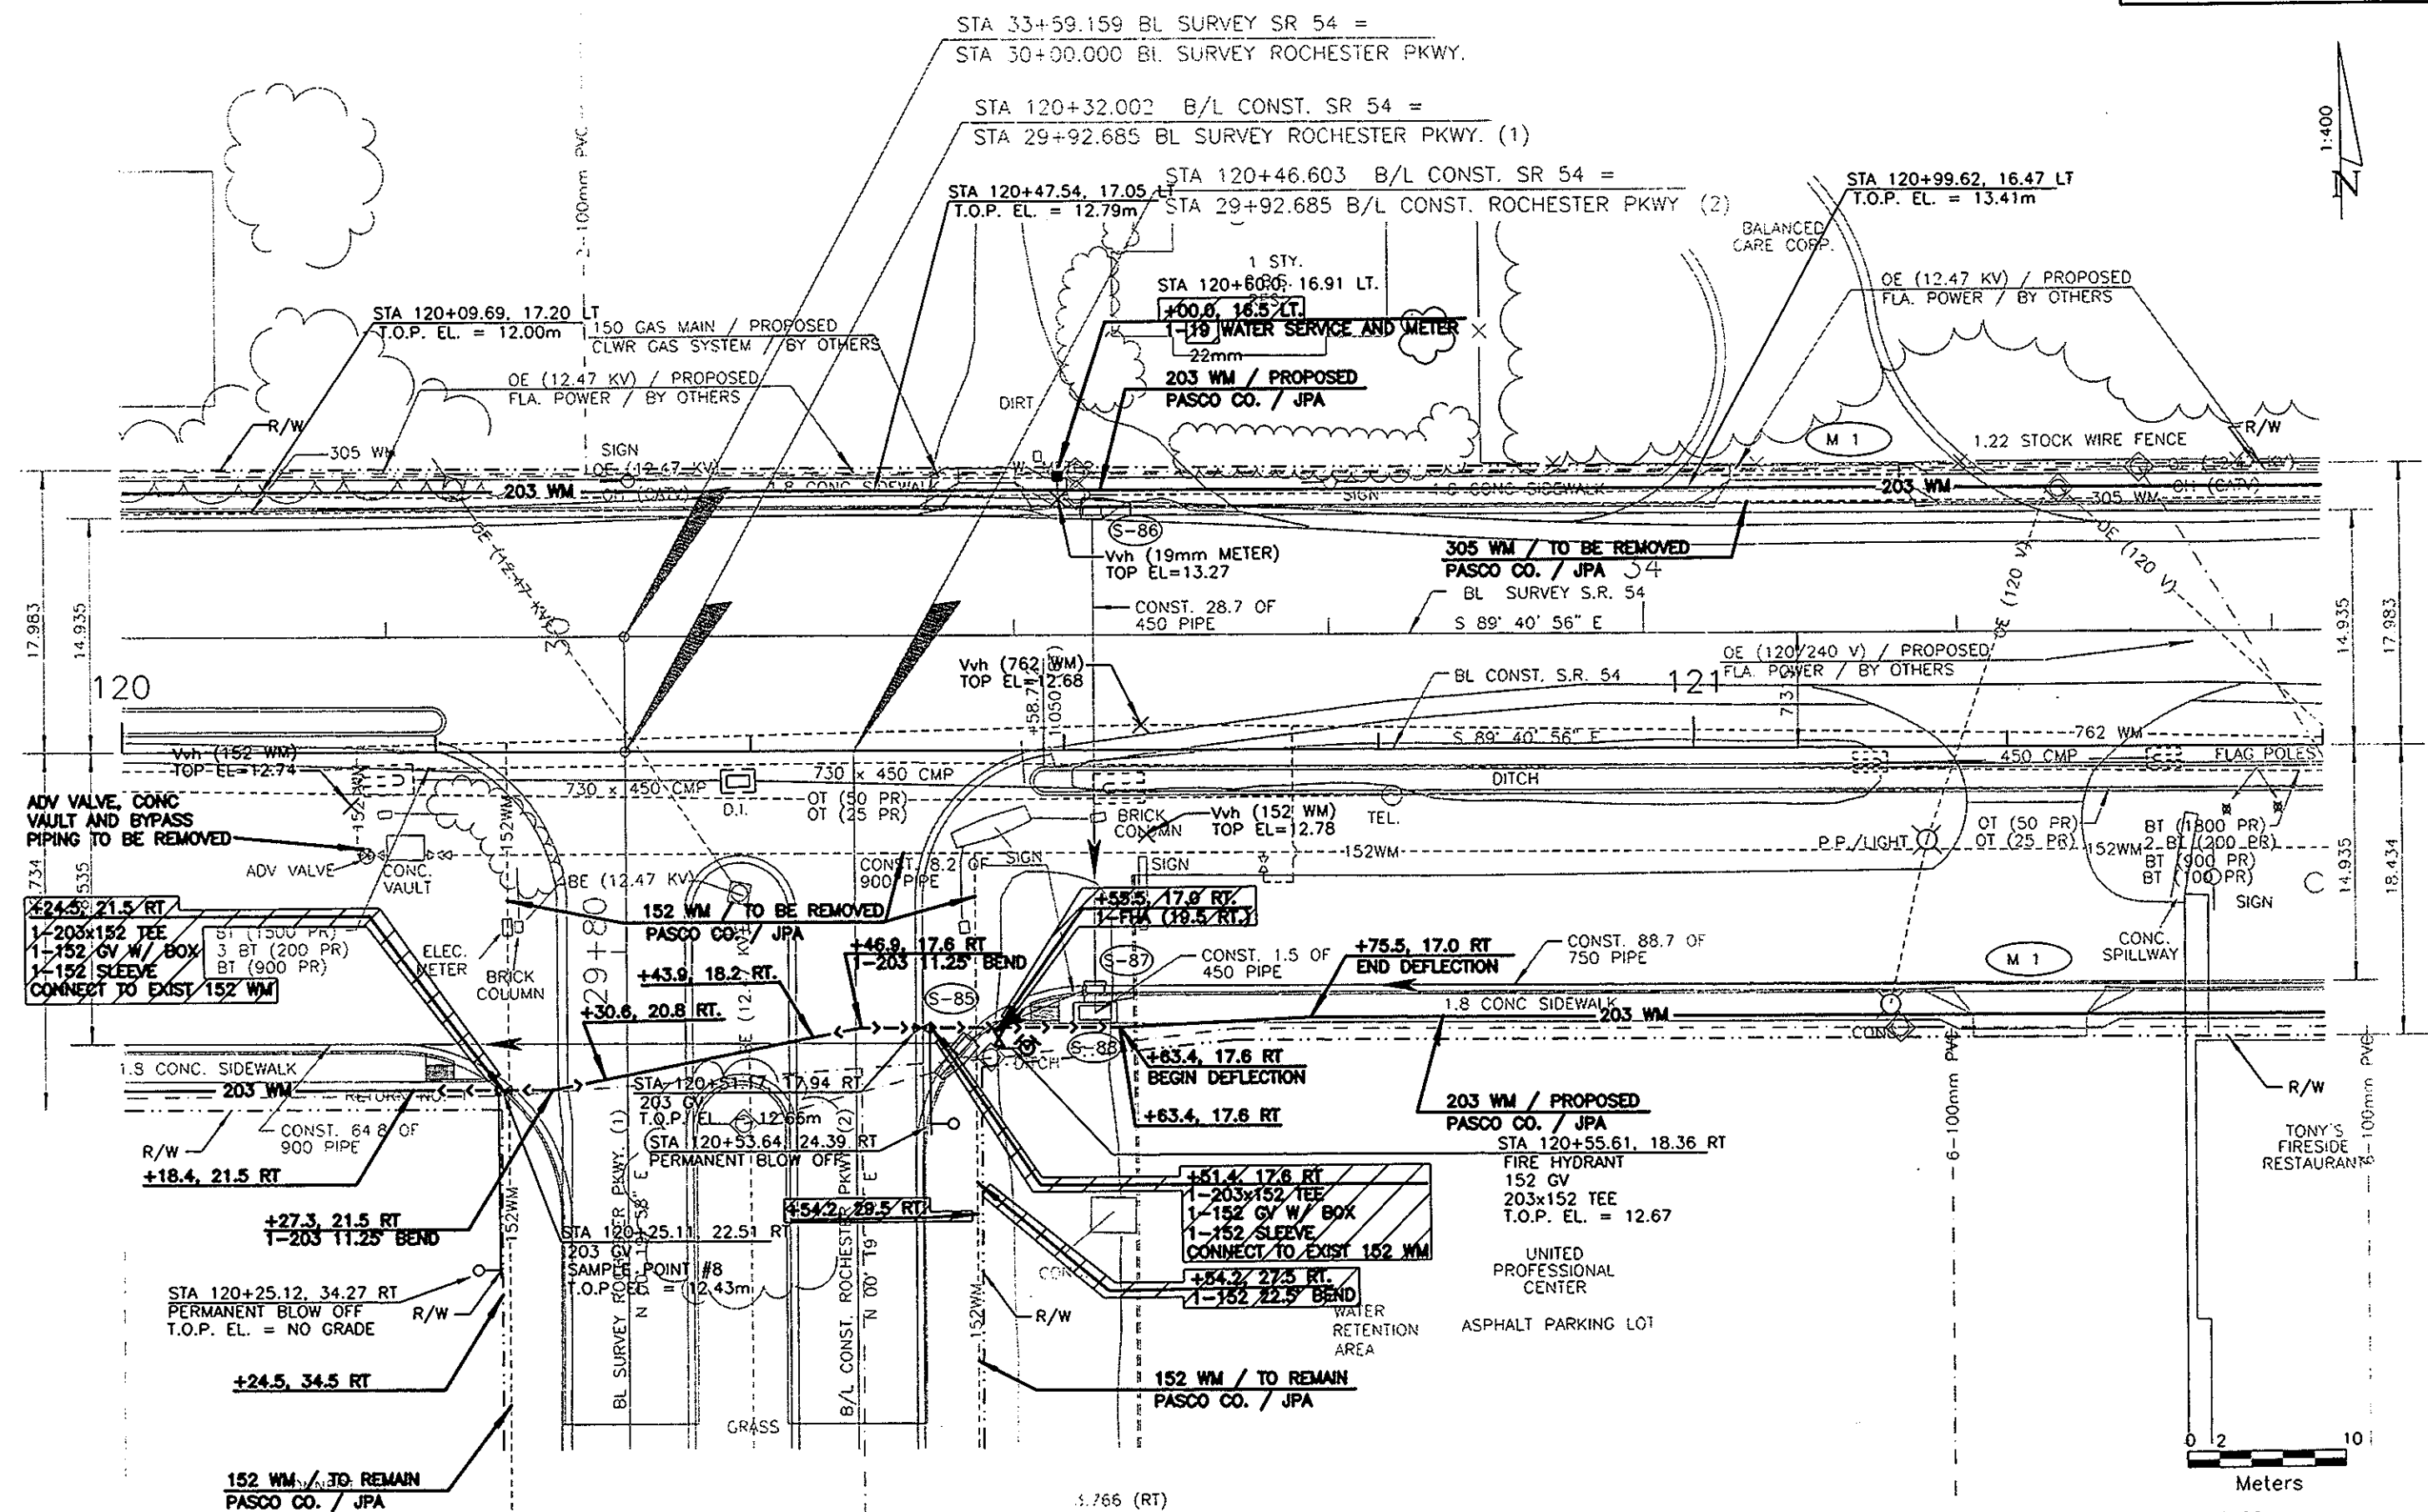

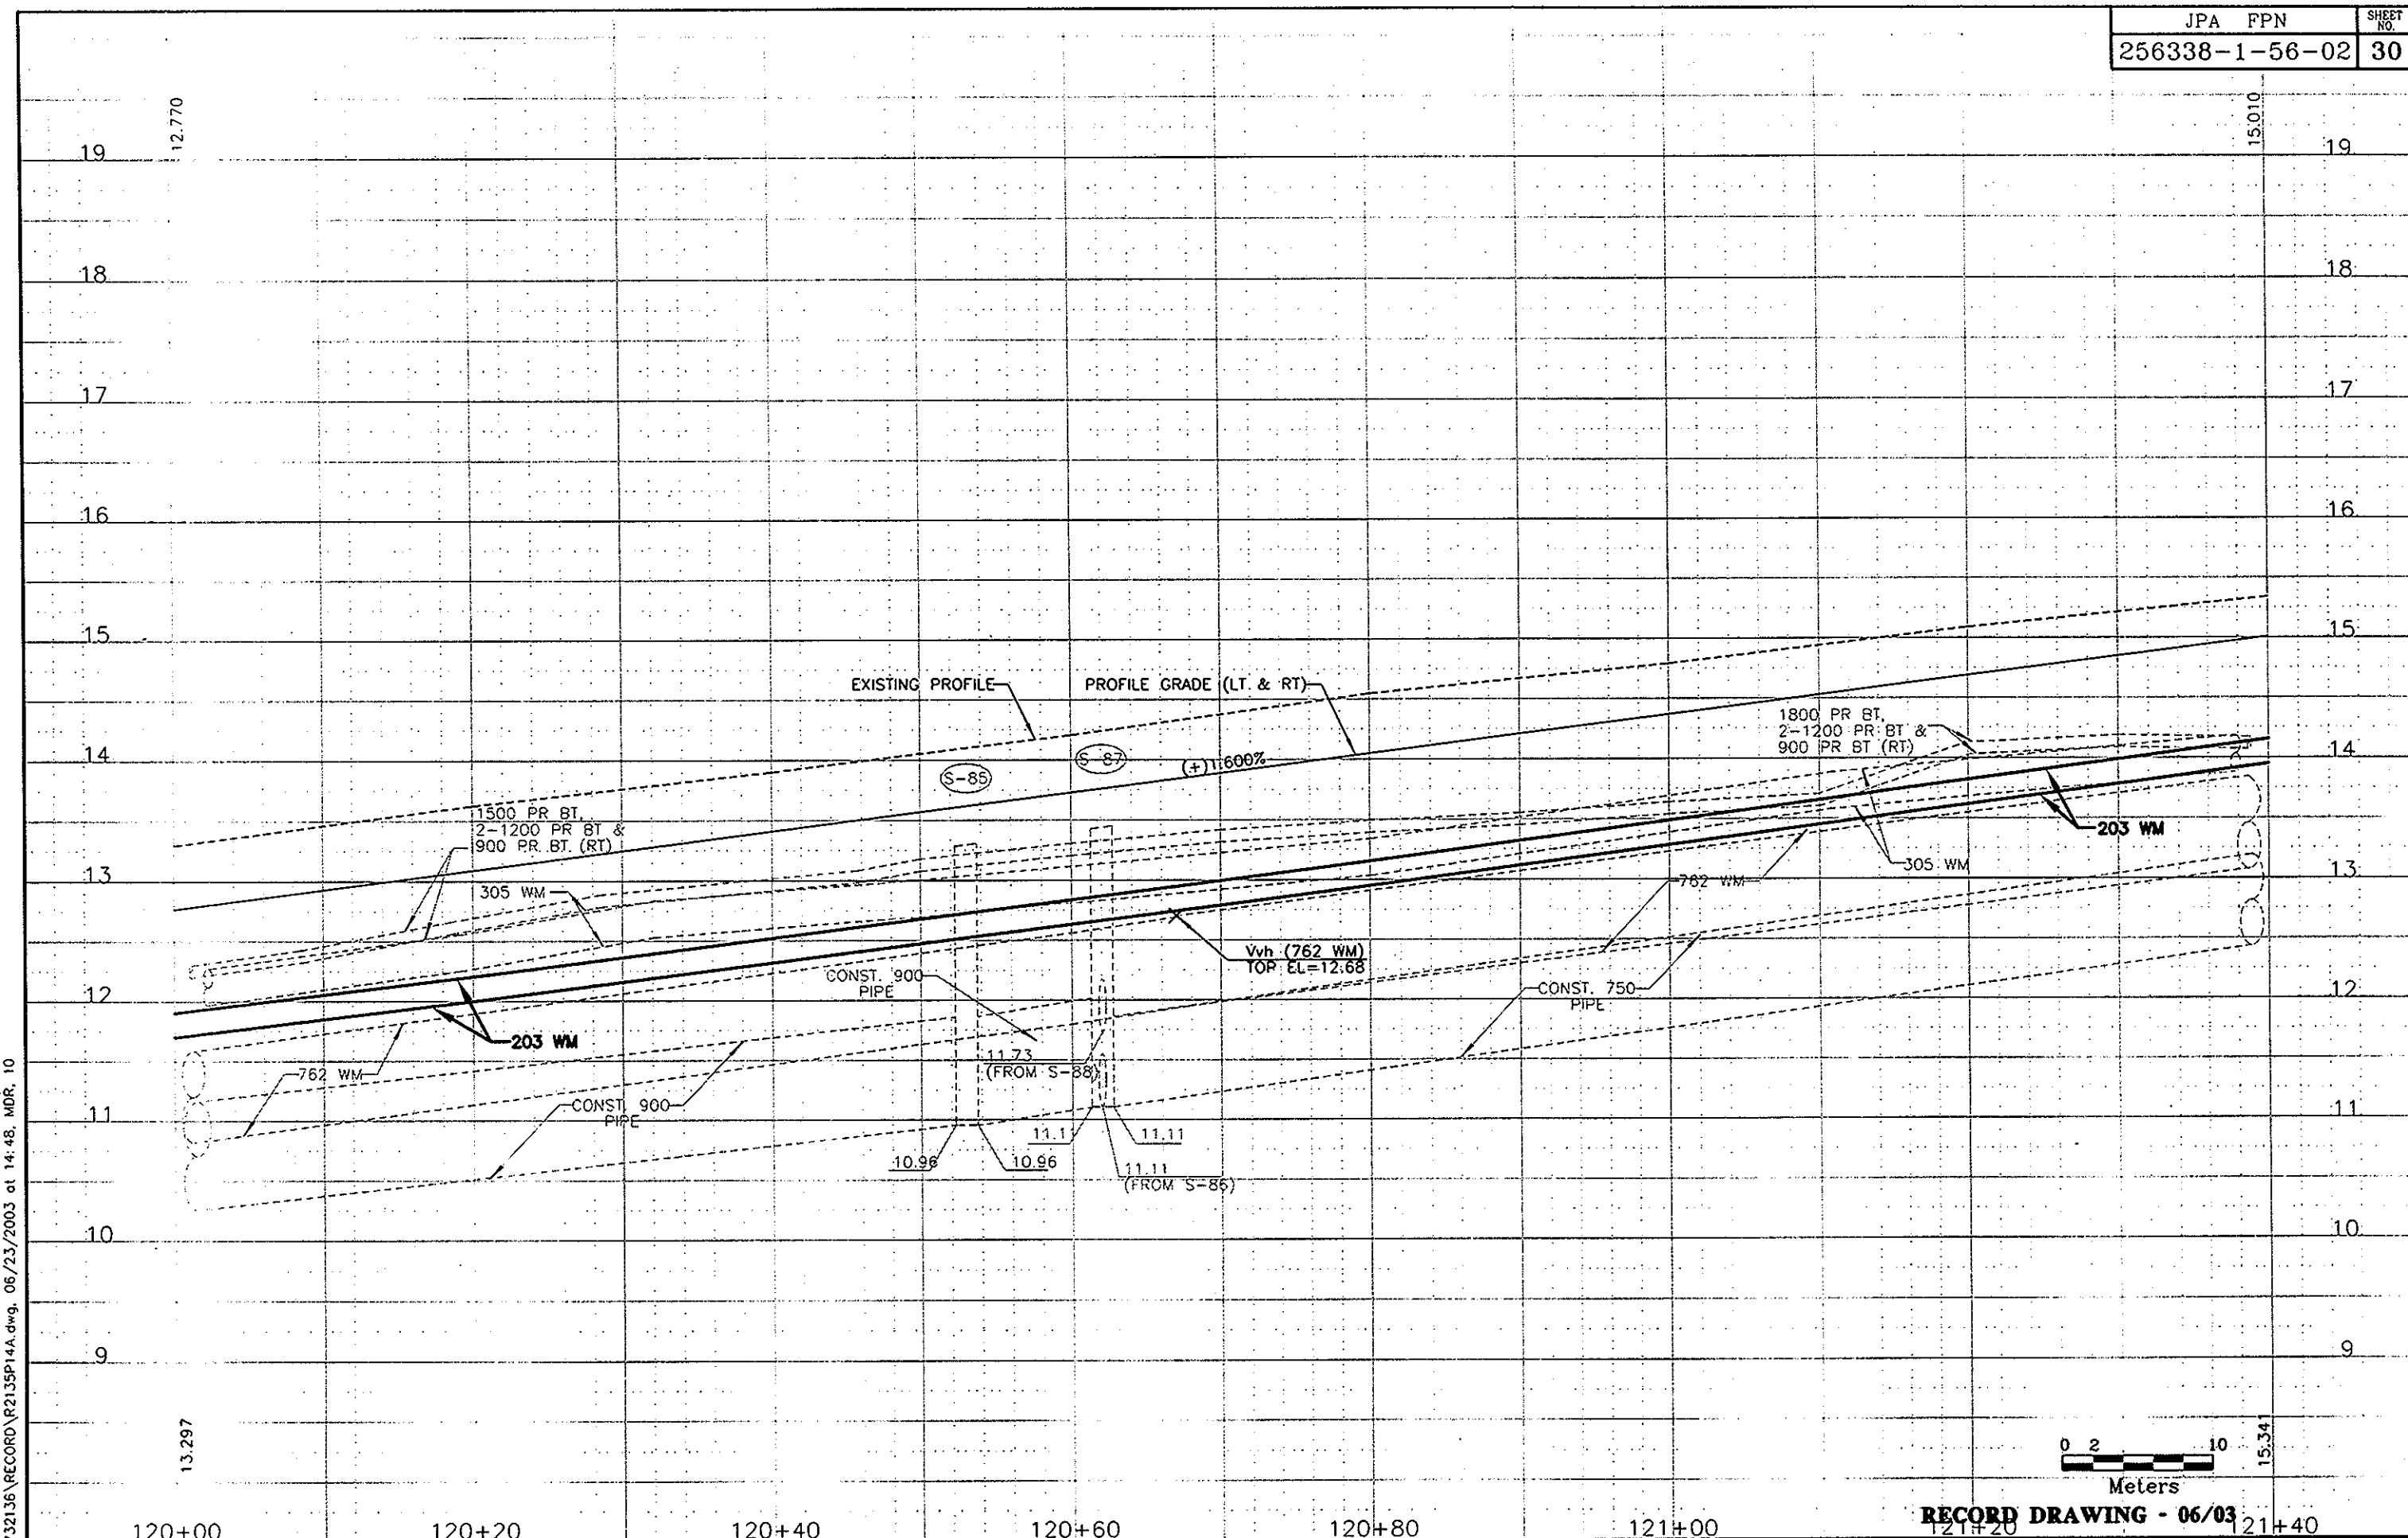

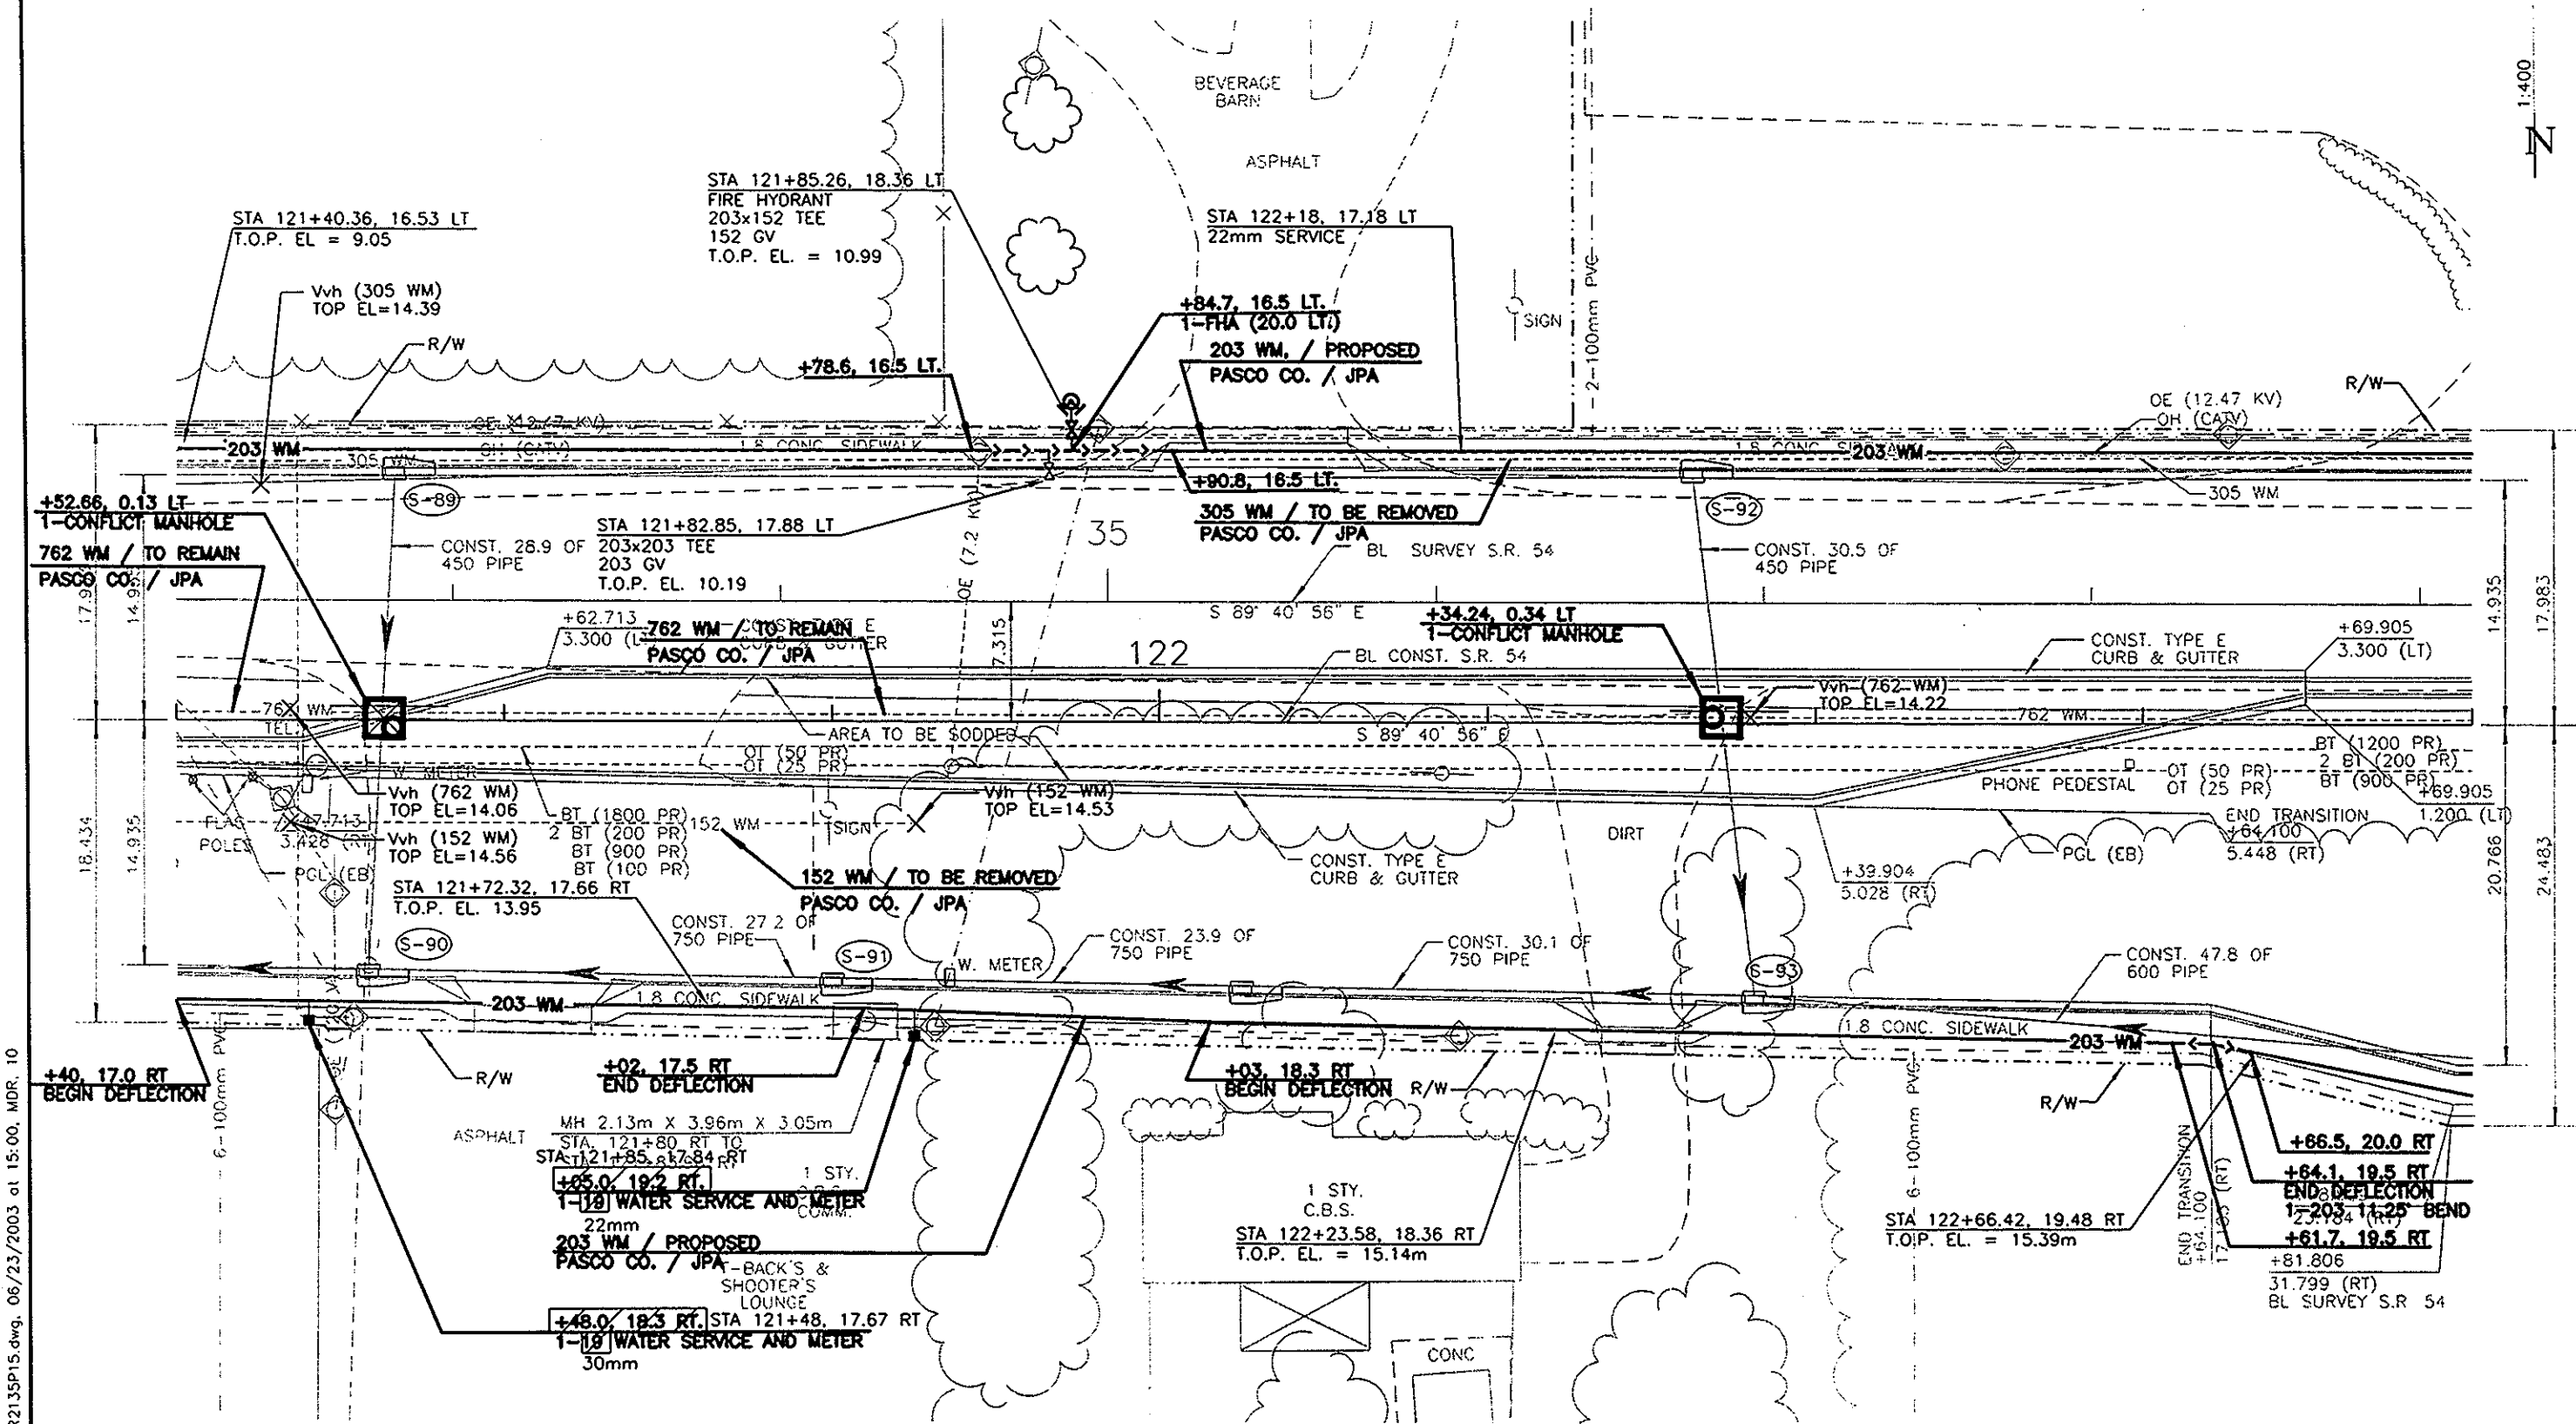



RECORD DRAWING - 06/03


REVISIONS				REVISIONS				REVISIONS			
DATE	BY	DESCRIPTION	DATE	BY	DESCRIPTION	DATE	BY	DESCRIPTION	DATE	BY	DESCRIPTION
06/03	JSL	RECORD DRAWING (SEE NOTES ON TITLE SHEET)									
11/00	JSL	RELEASED FOR BIDDING/CONSTRUCTION									


DESIGNED BY	J. BURBY	DATE	2/98	DRAWN BY	D. BURNHAM	DATE	2/98
REVIEWED BY	J. LOWE	DATE	11/00	CHECKED BY	F. DeSANTO	DATE	11/00
APPROVED BY				REG No: 52017			
JEFFERY S. LOWE, P.E.							


PARSONS ENGINEERING SCIENCE, INC.	PASCO COUNTY UTILITIES CONSTRUCTION	STATE ROAD NO. 54 - US 19 TO MADISON WATER & FORCE MAIN UTILITY ADJUSTMENTS	SHEET NO.
Tampa, Florida (813) 933-4650	7530 LITTLE ROAD NEW PORT RICHEY, FLORIDA 34654	PLAN SHEET - STA 121+40 TO STA 122+80	P-15

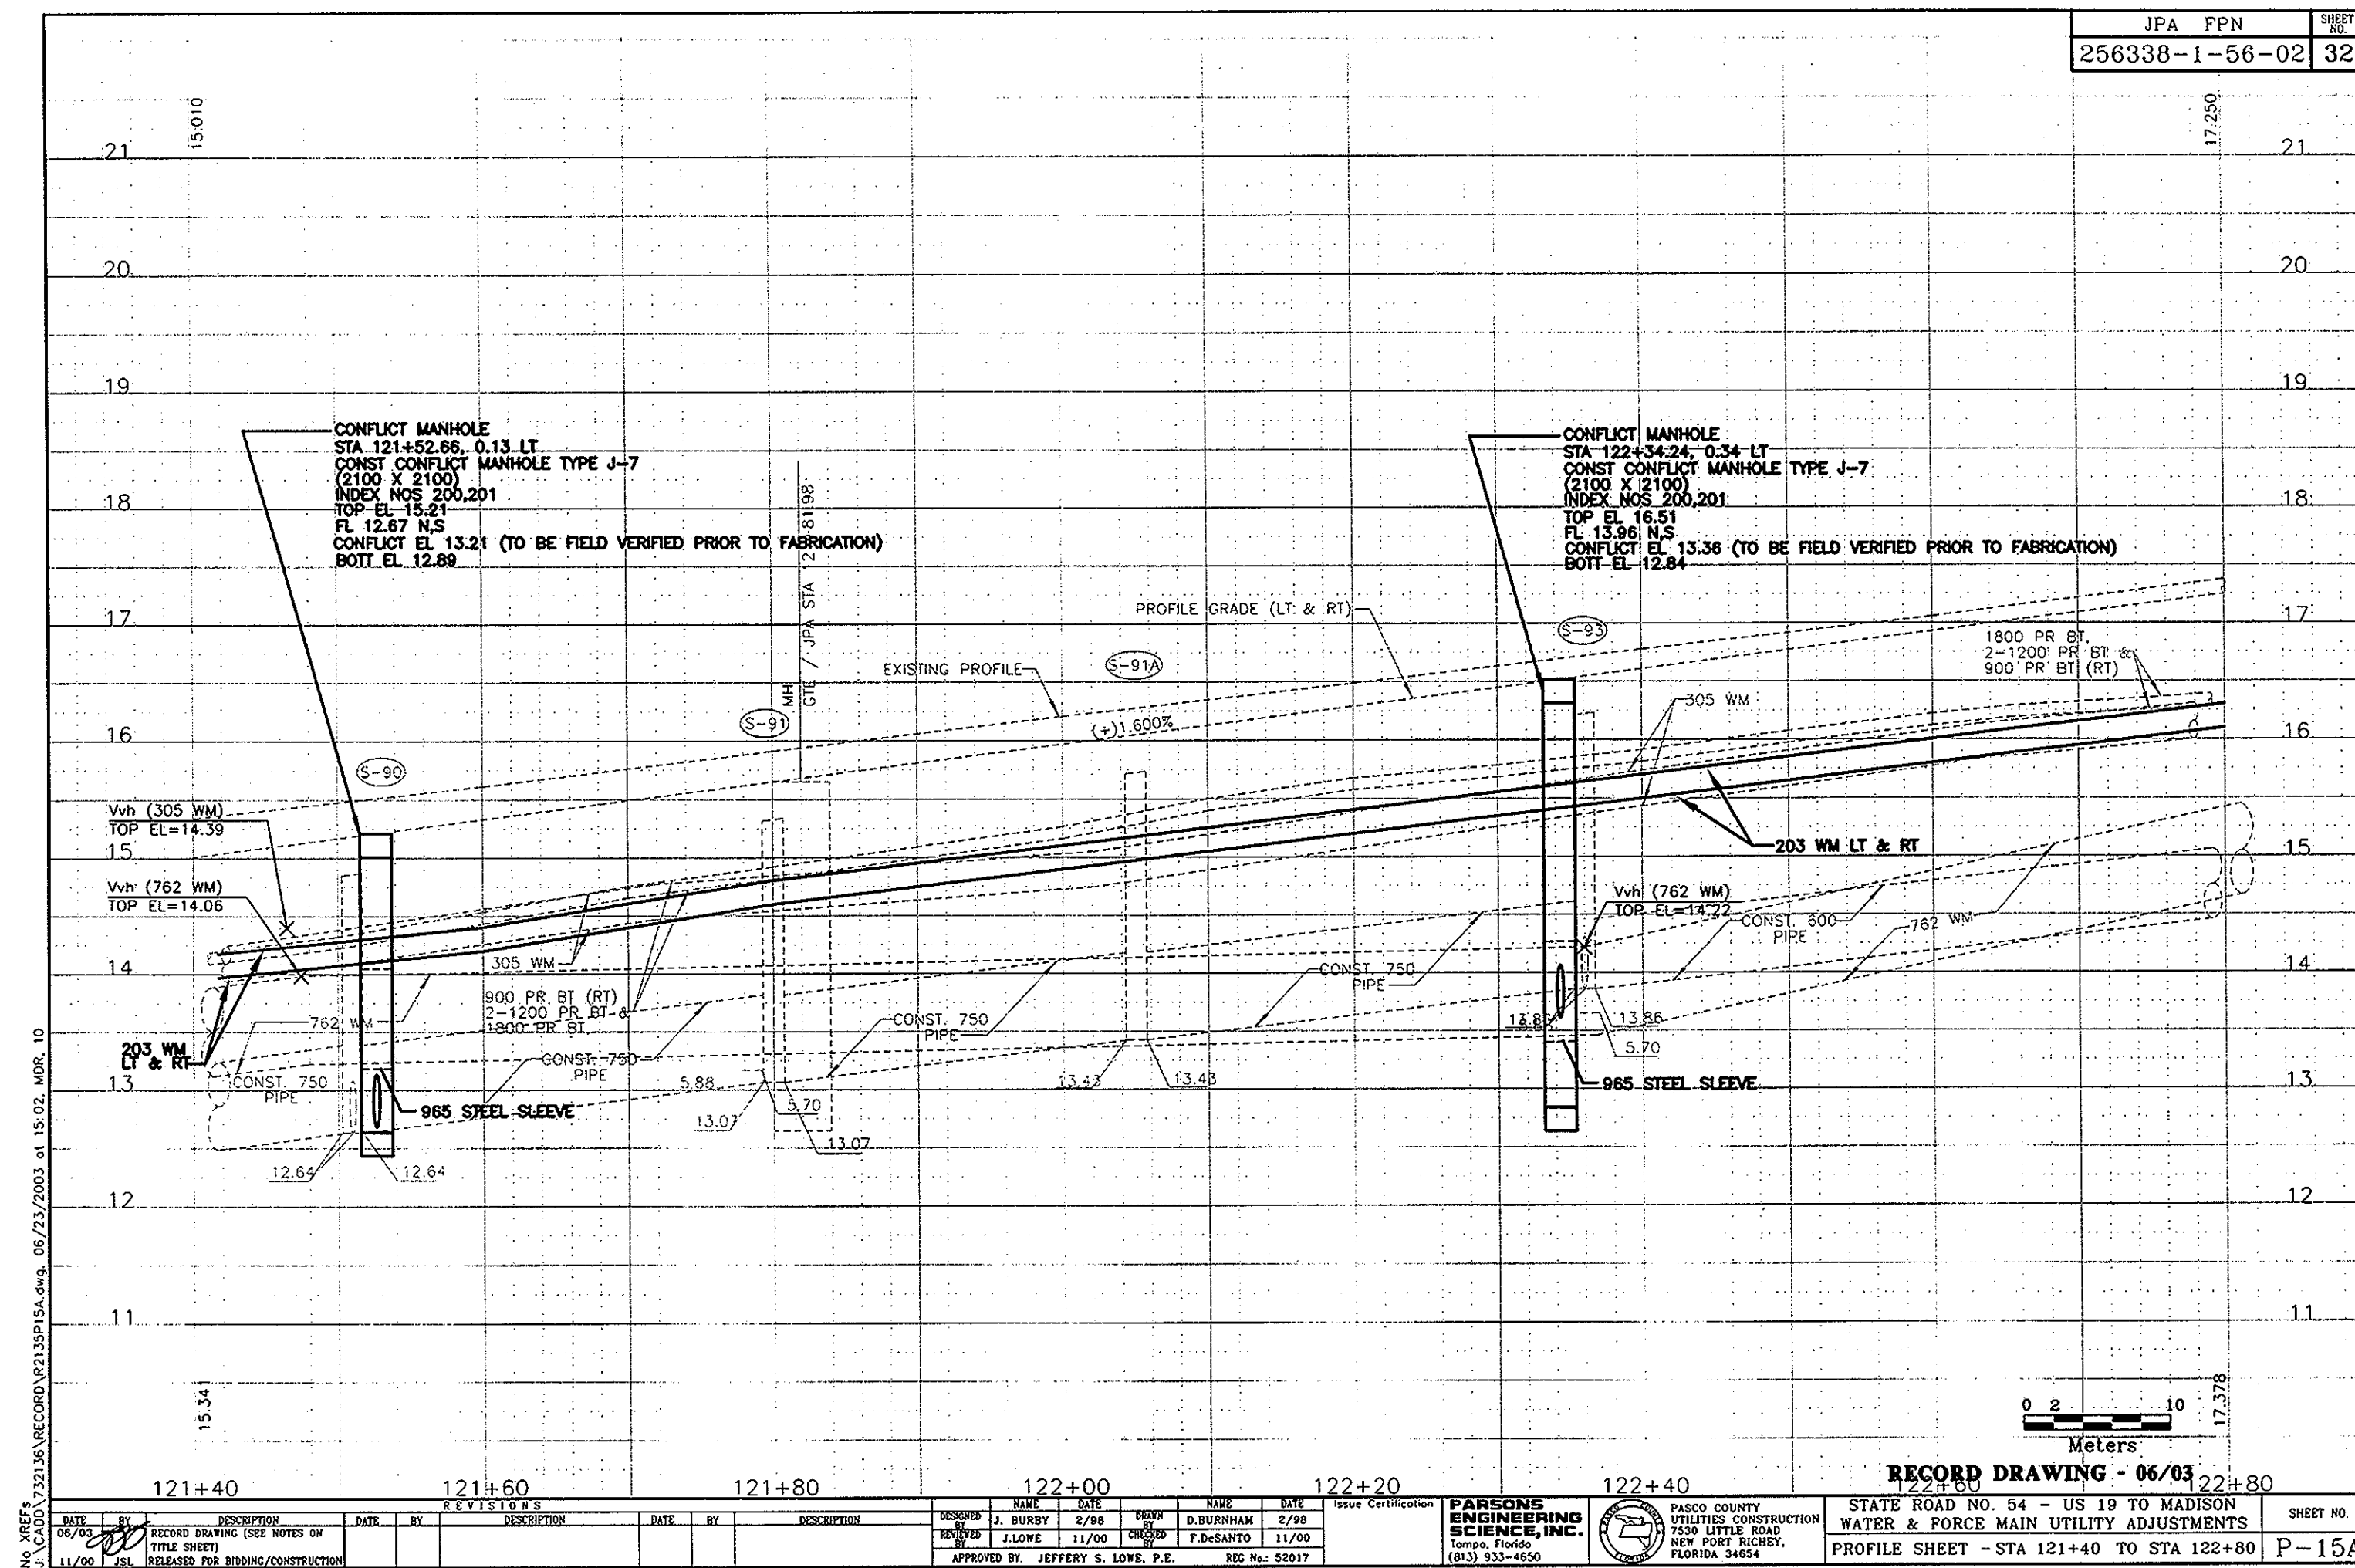


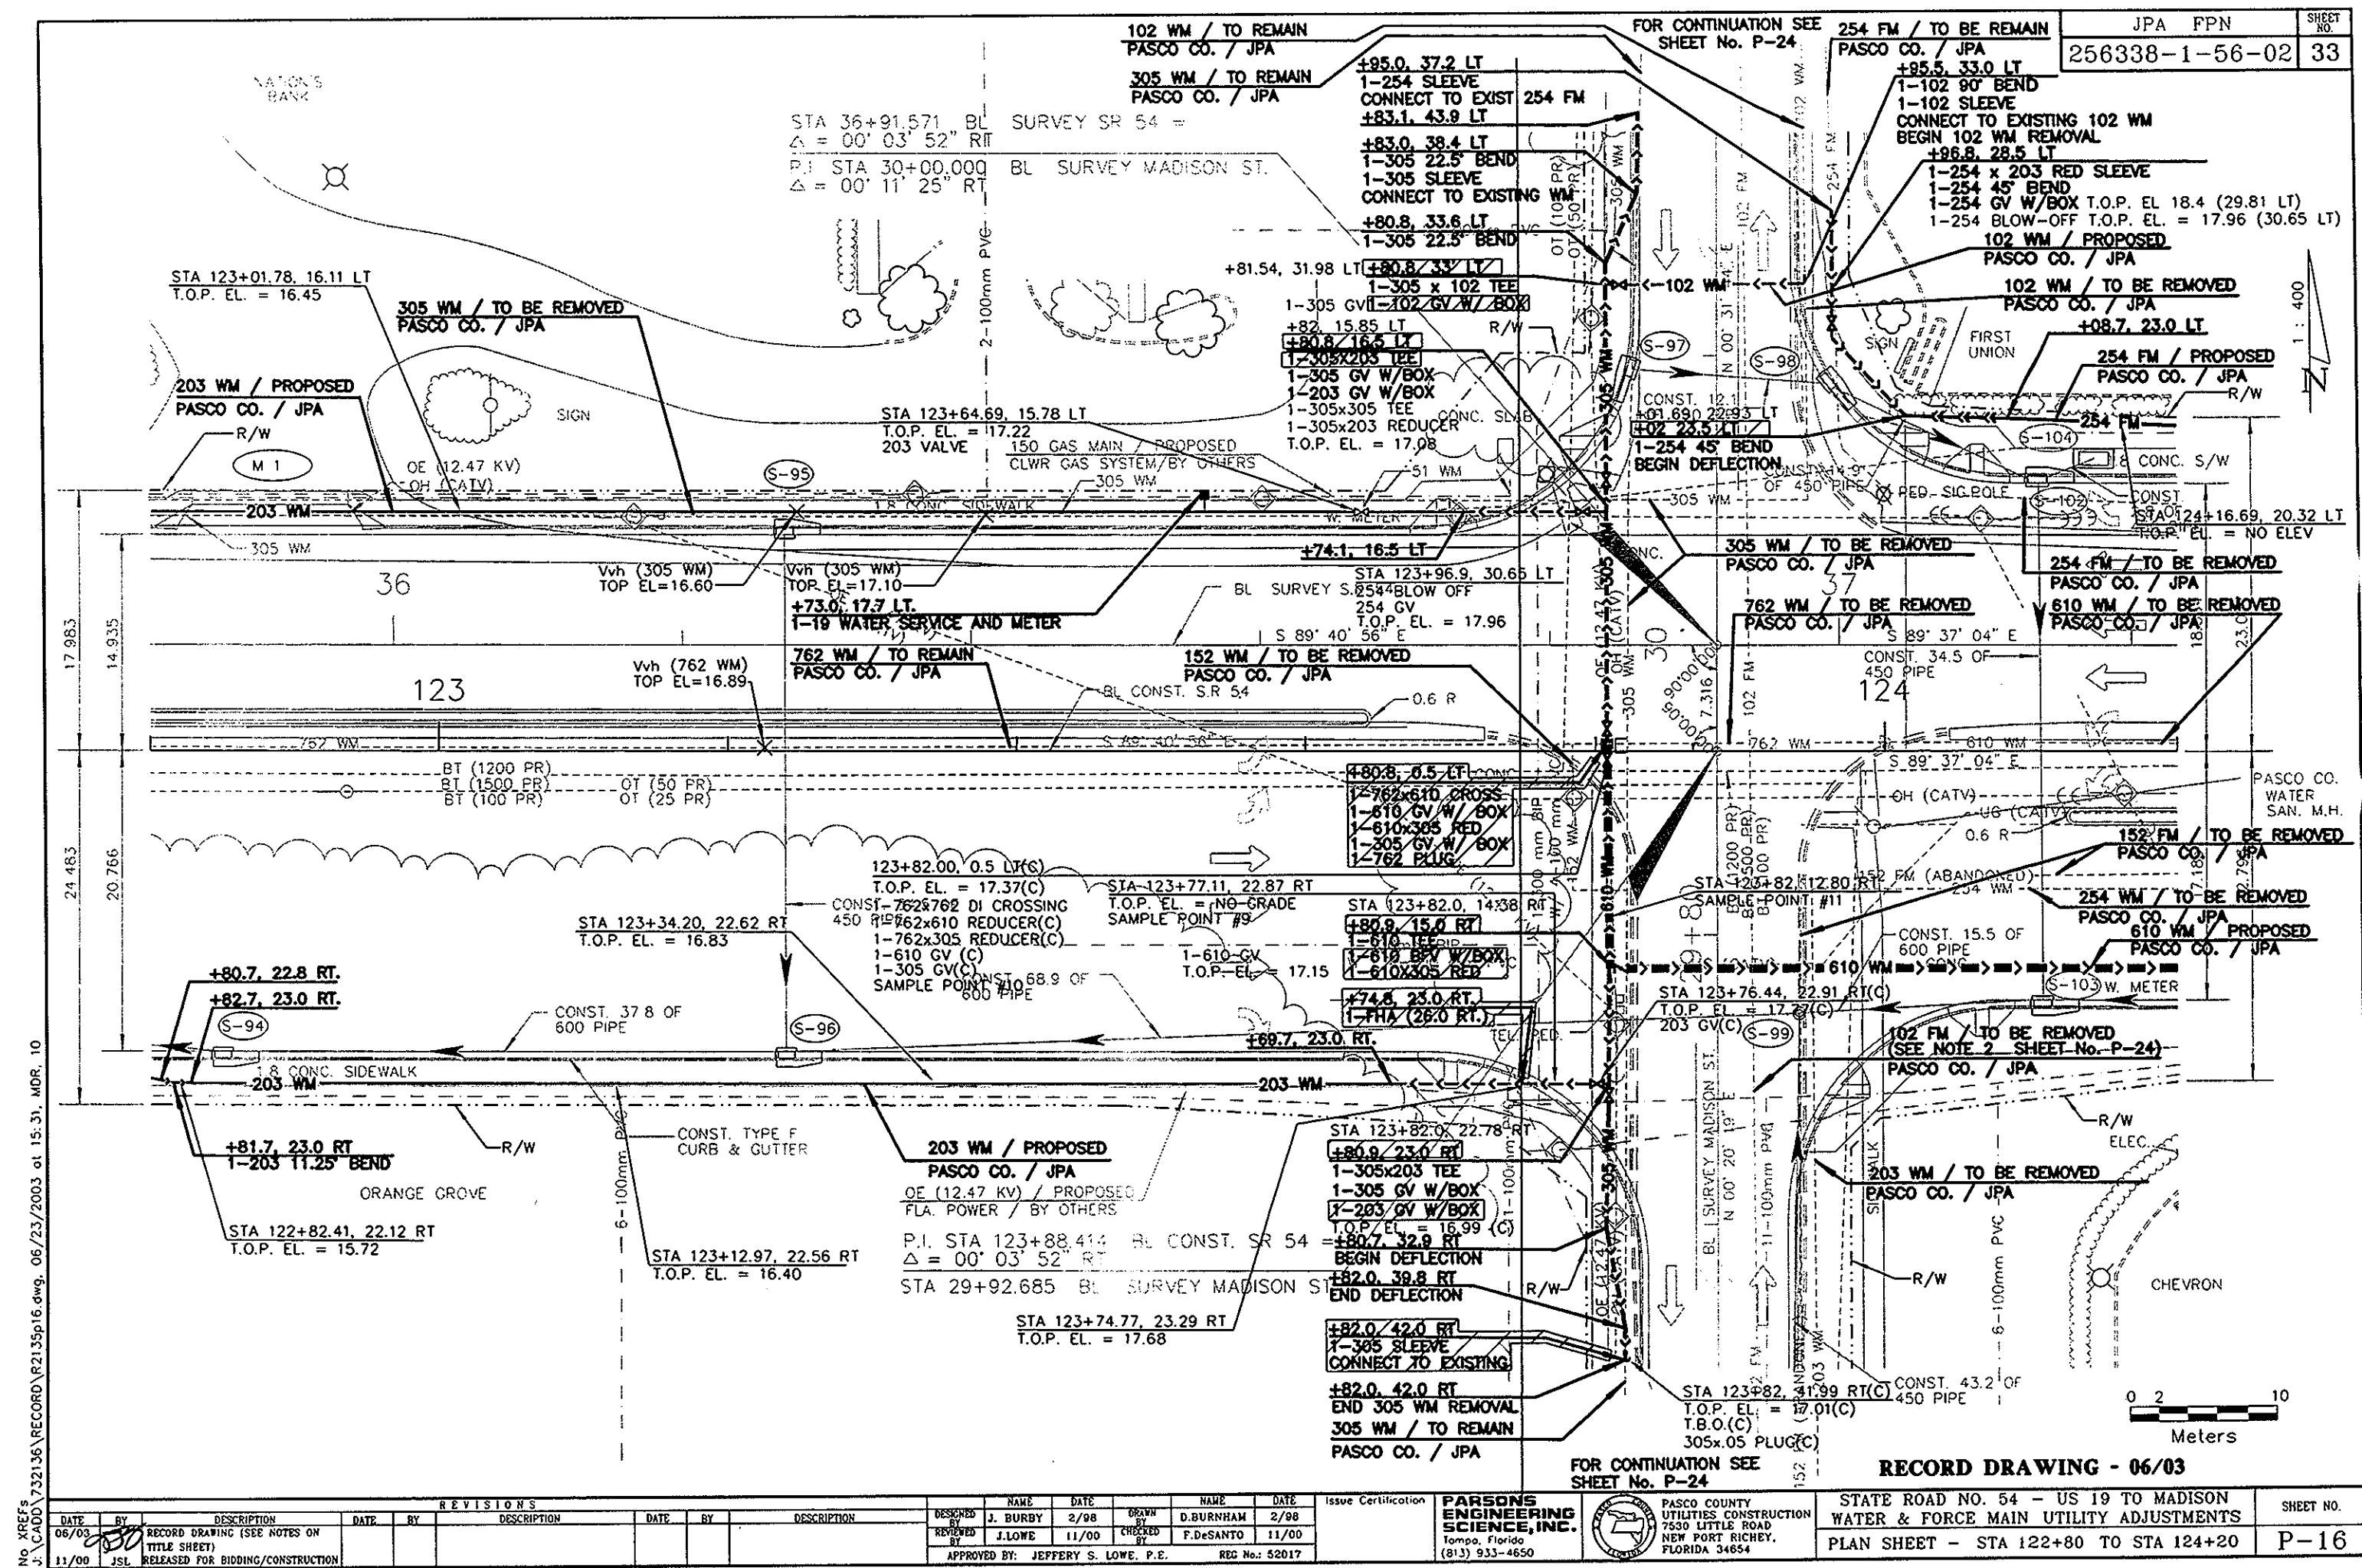

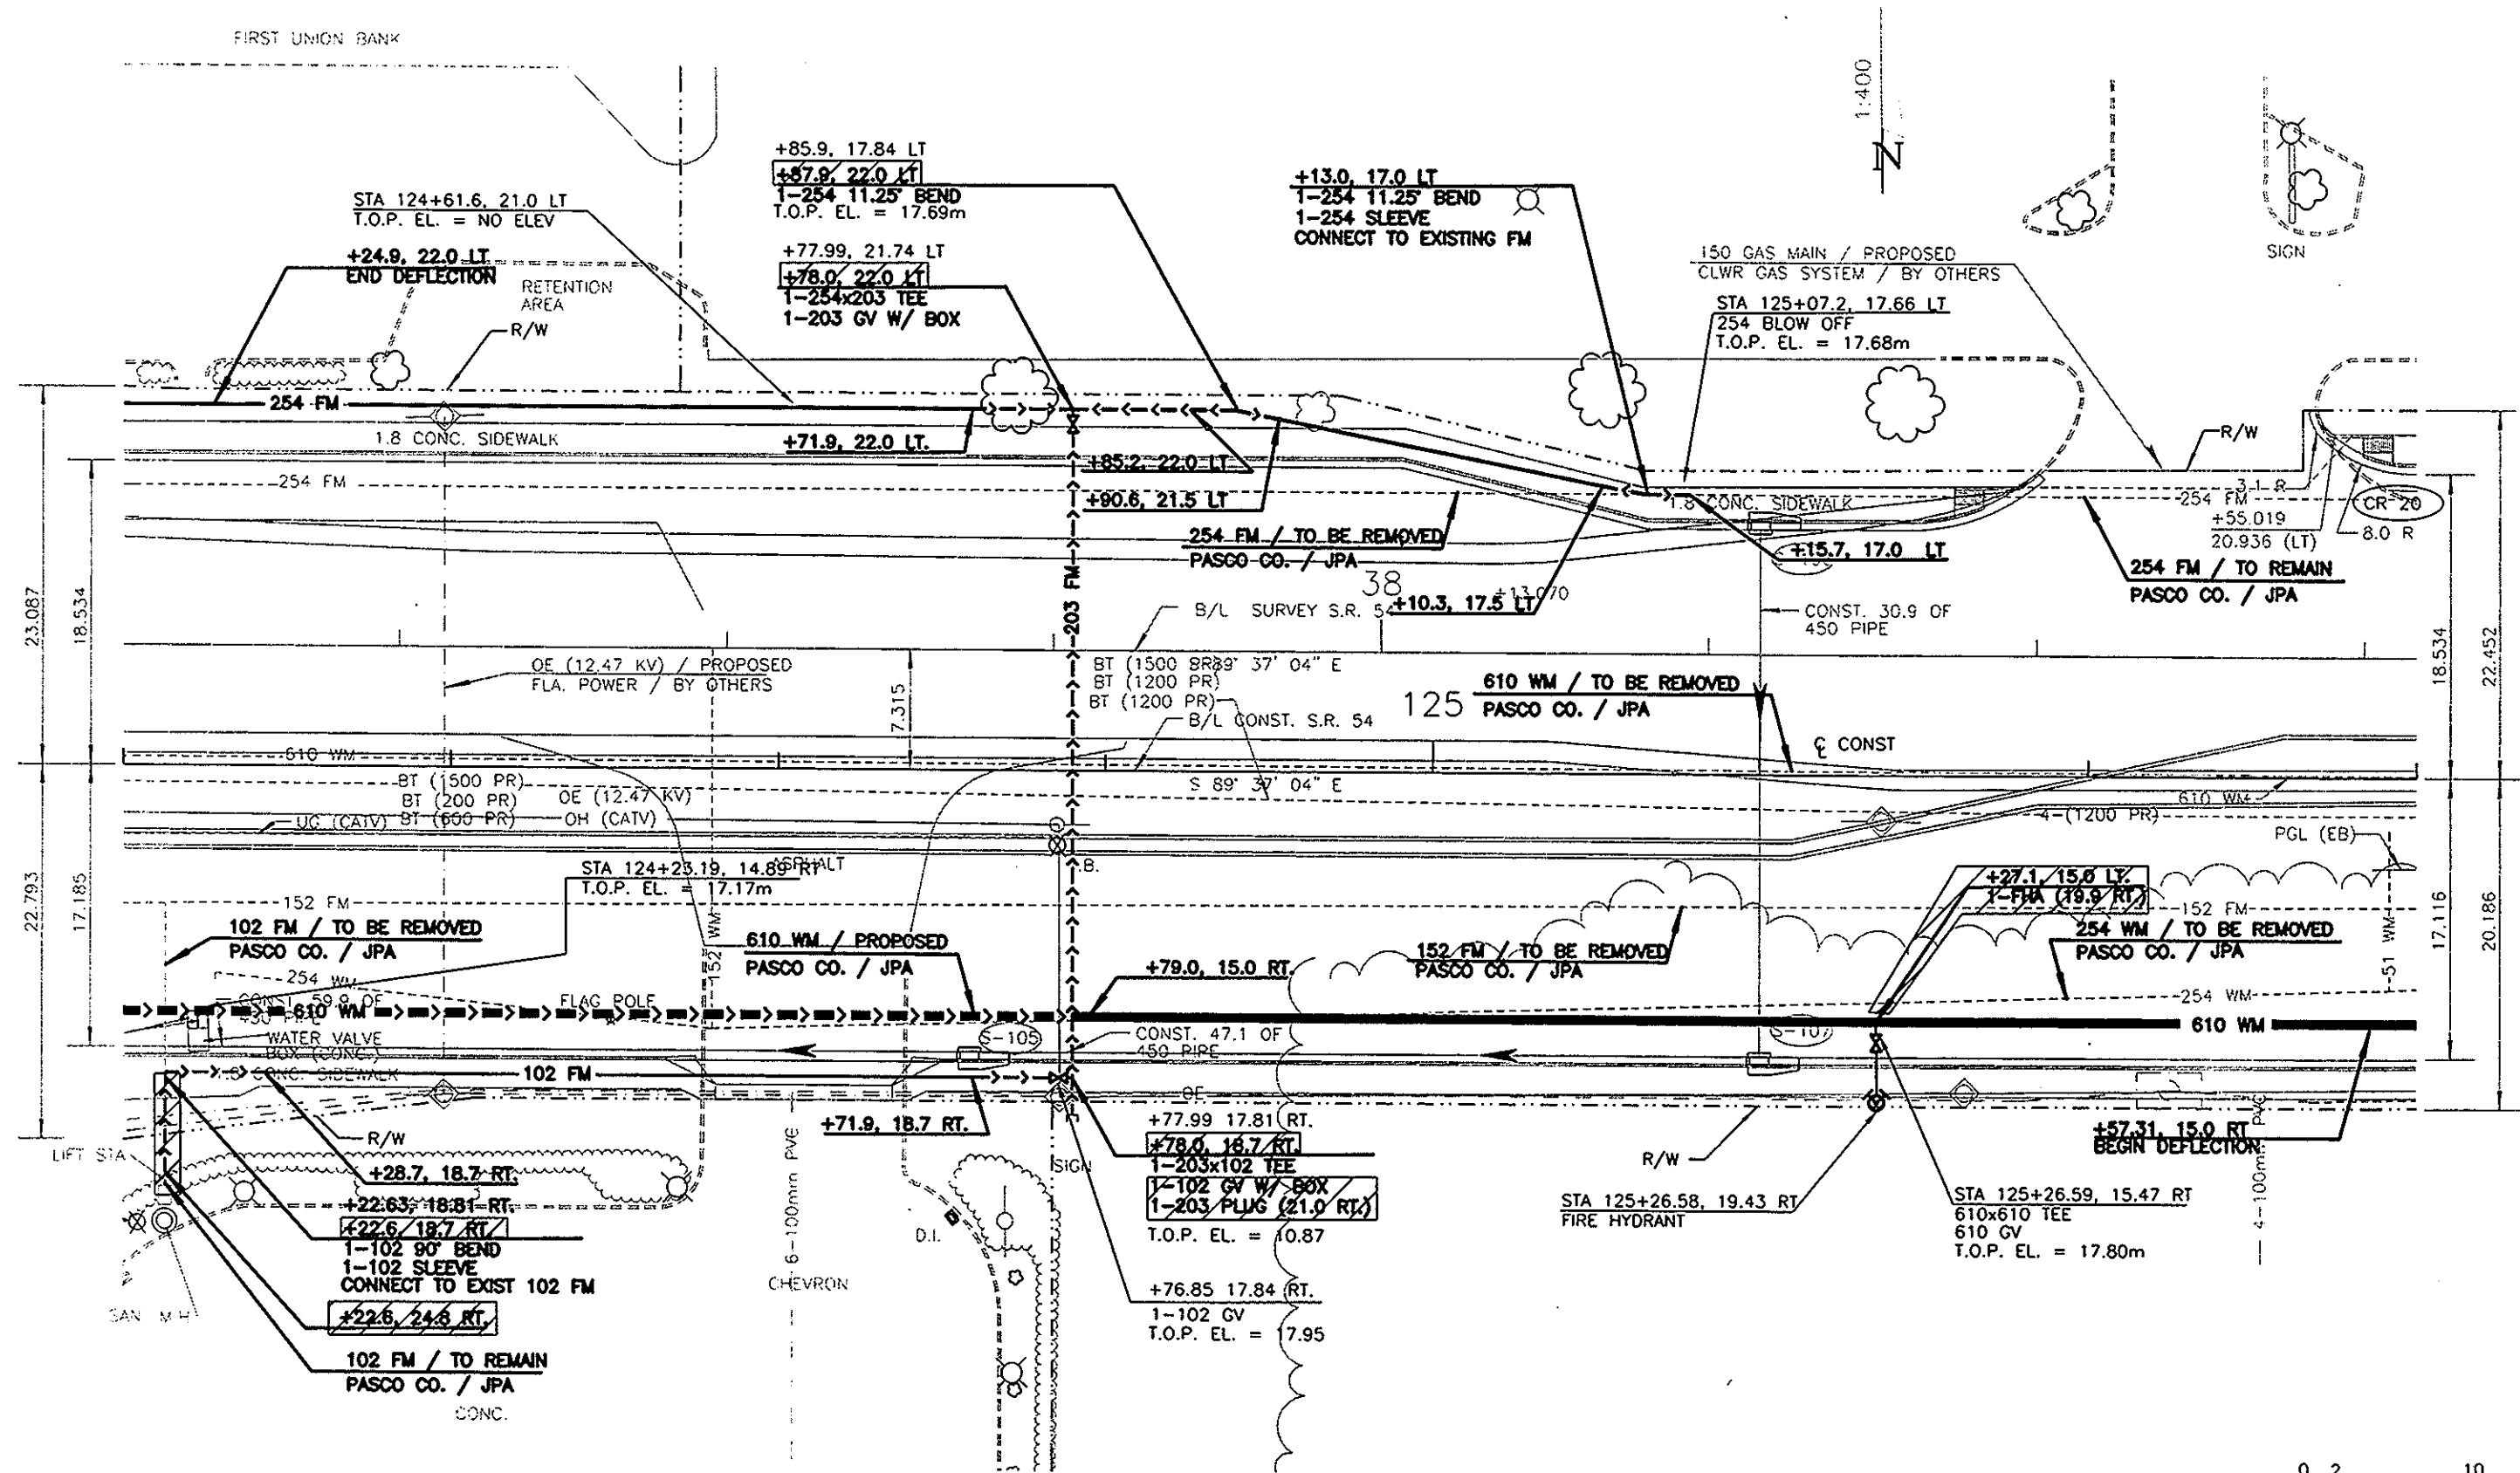

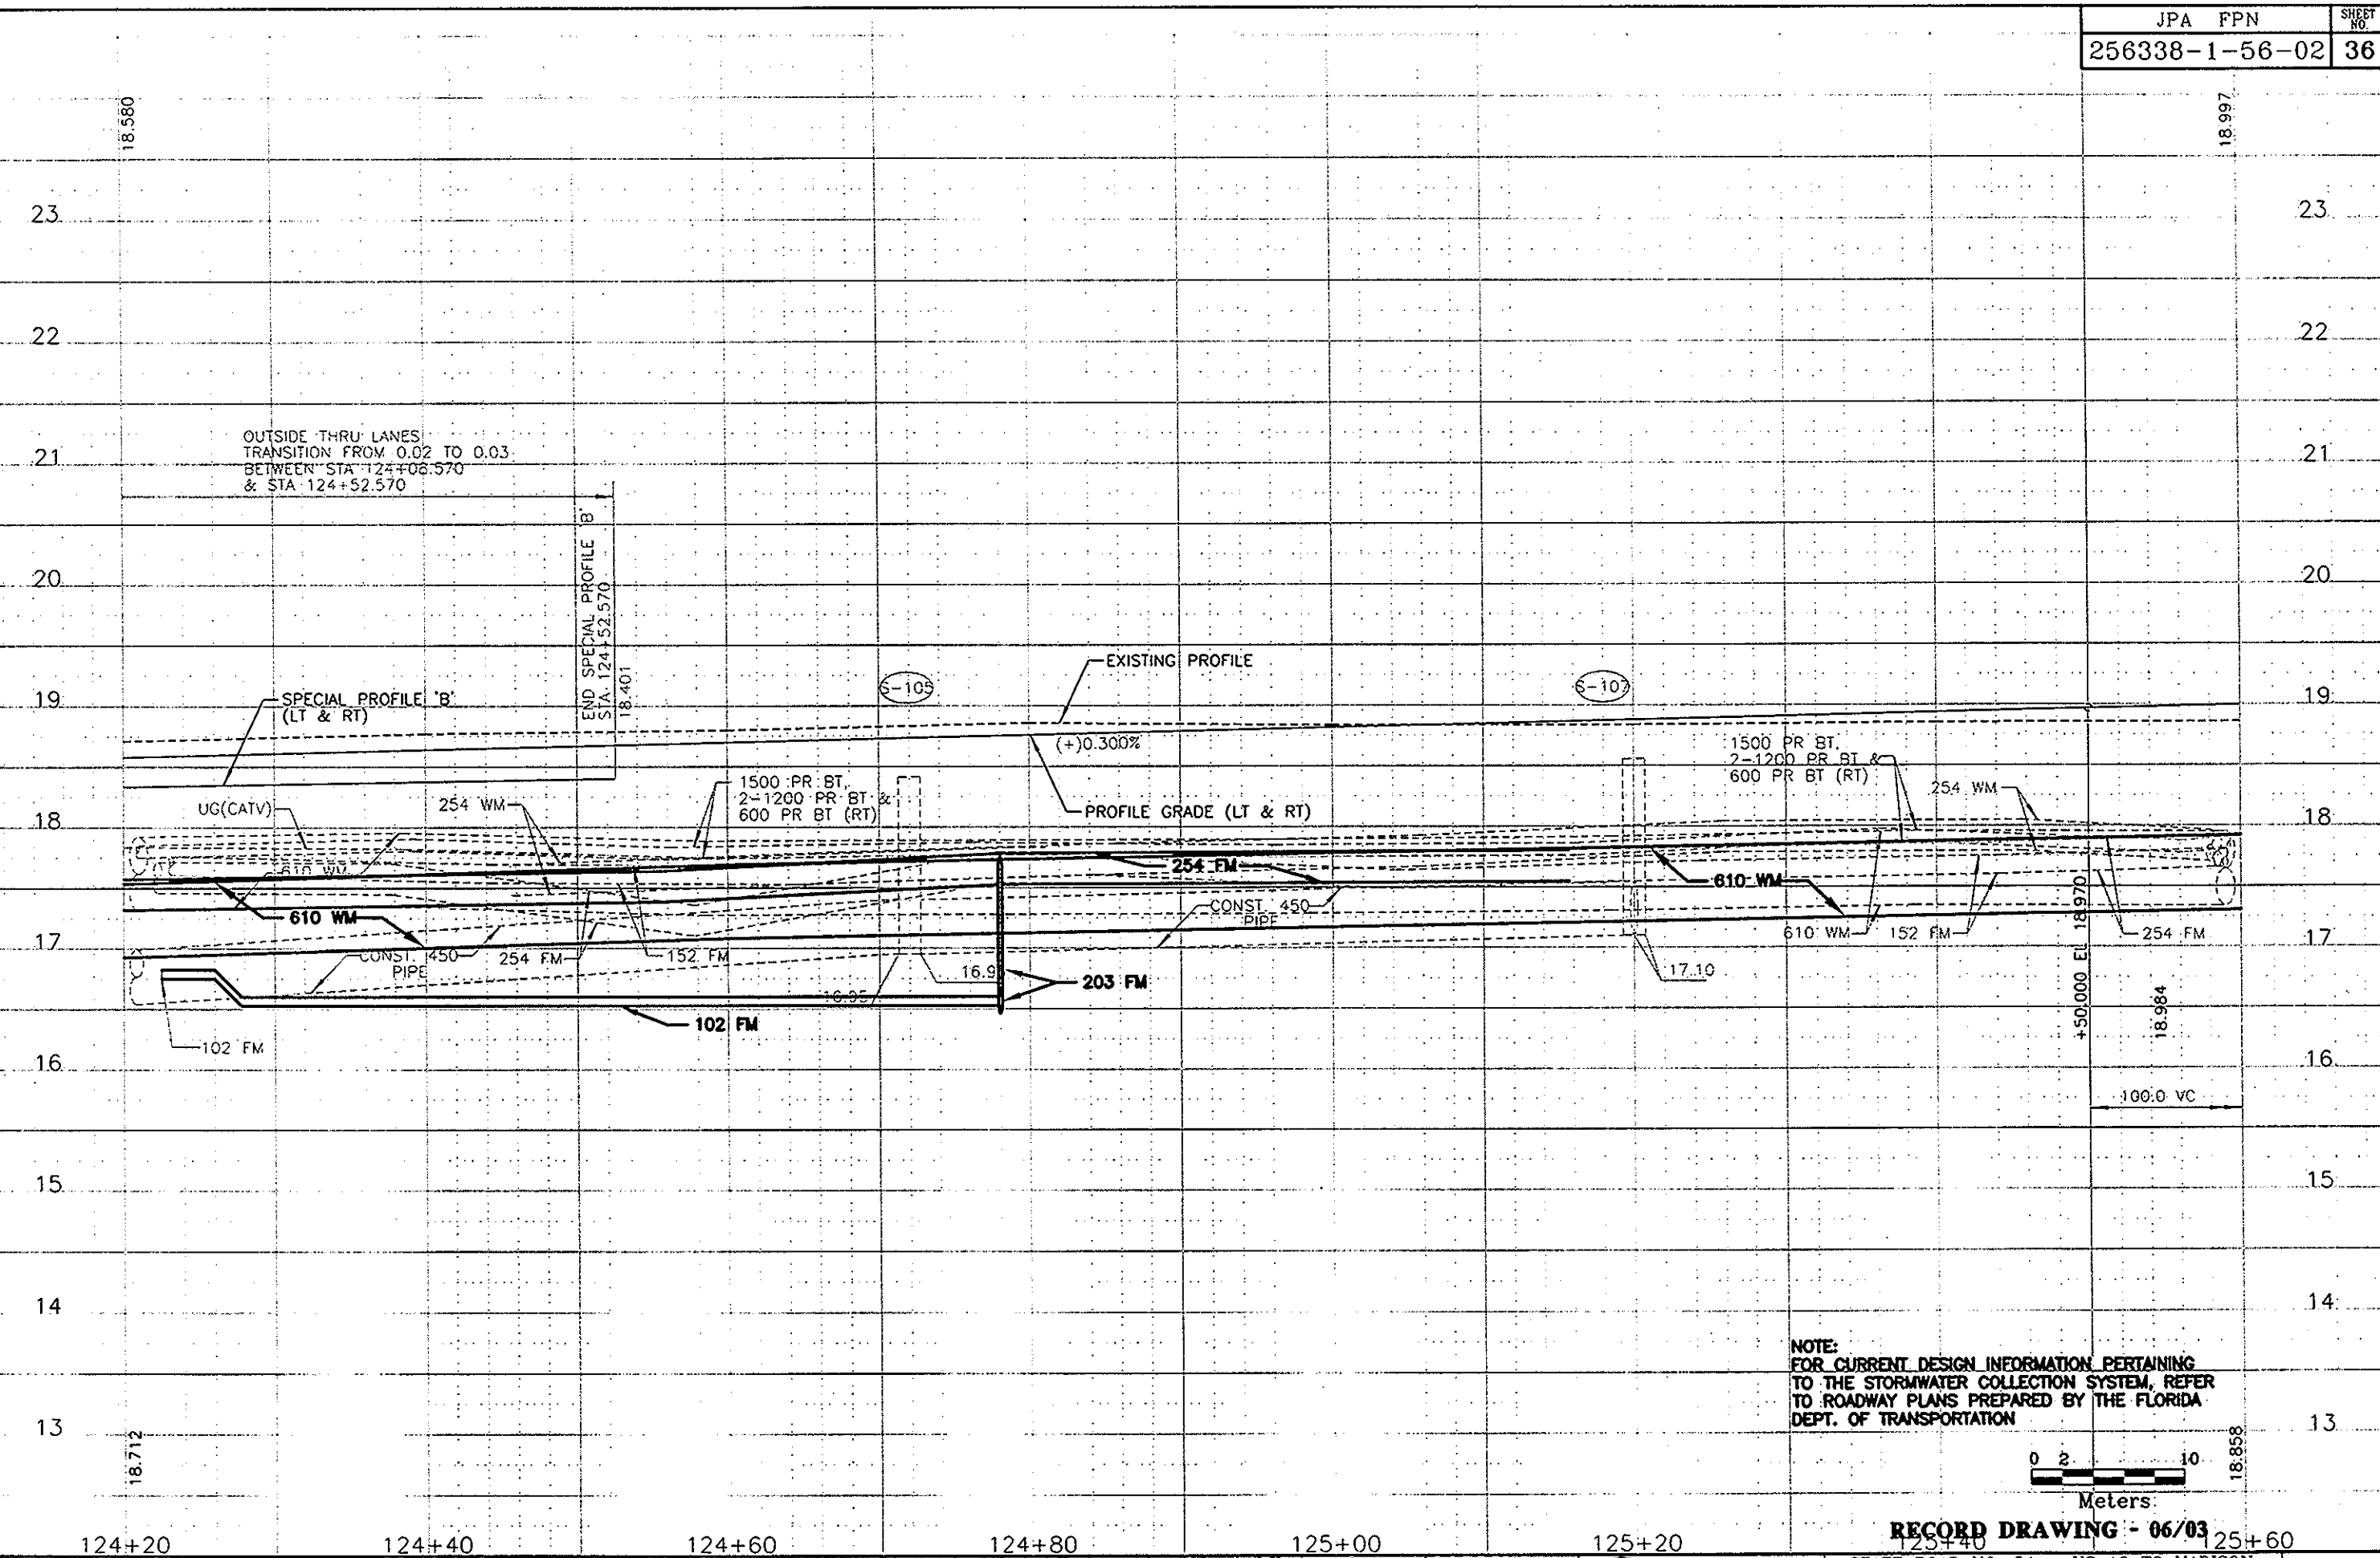


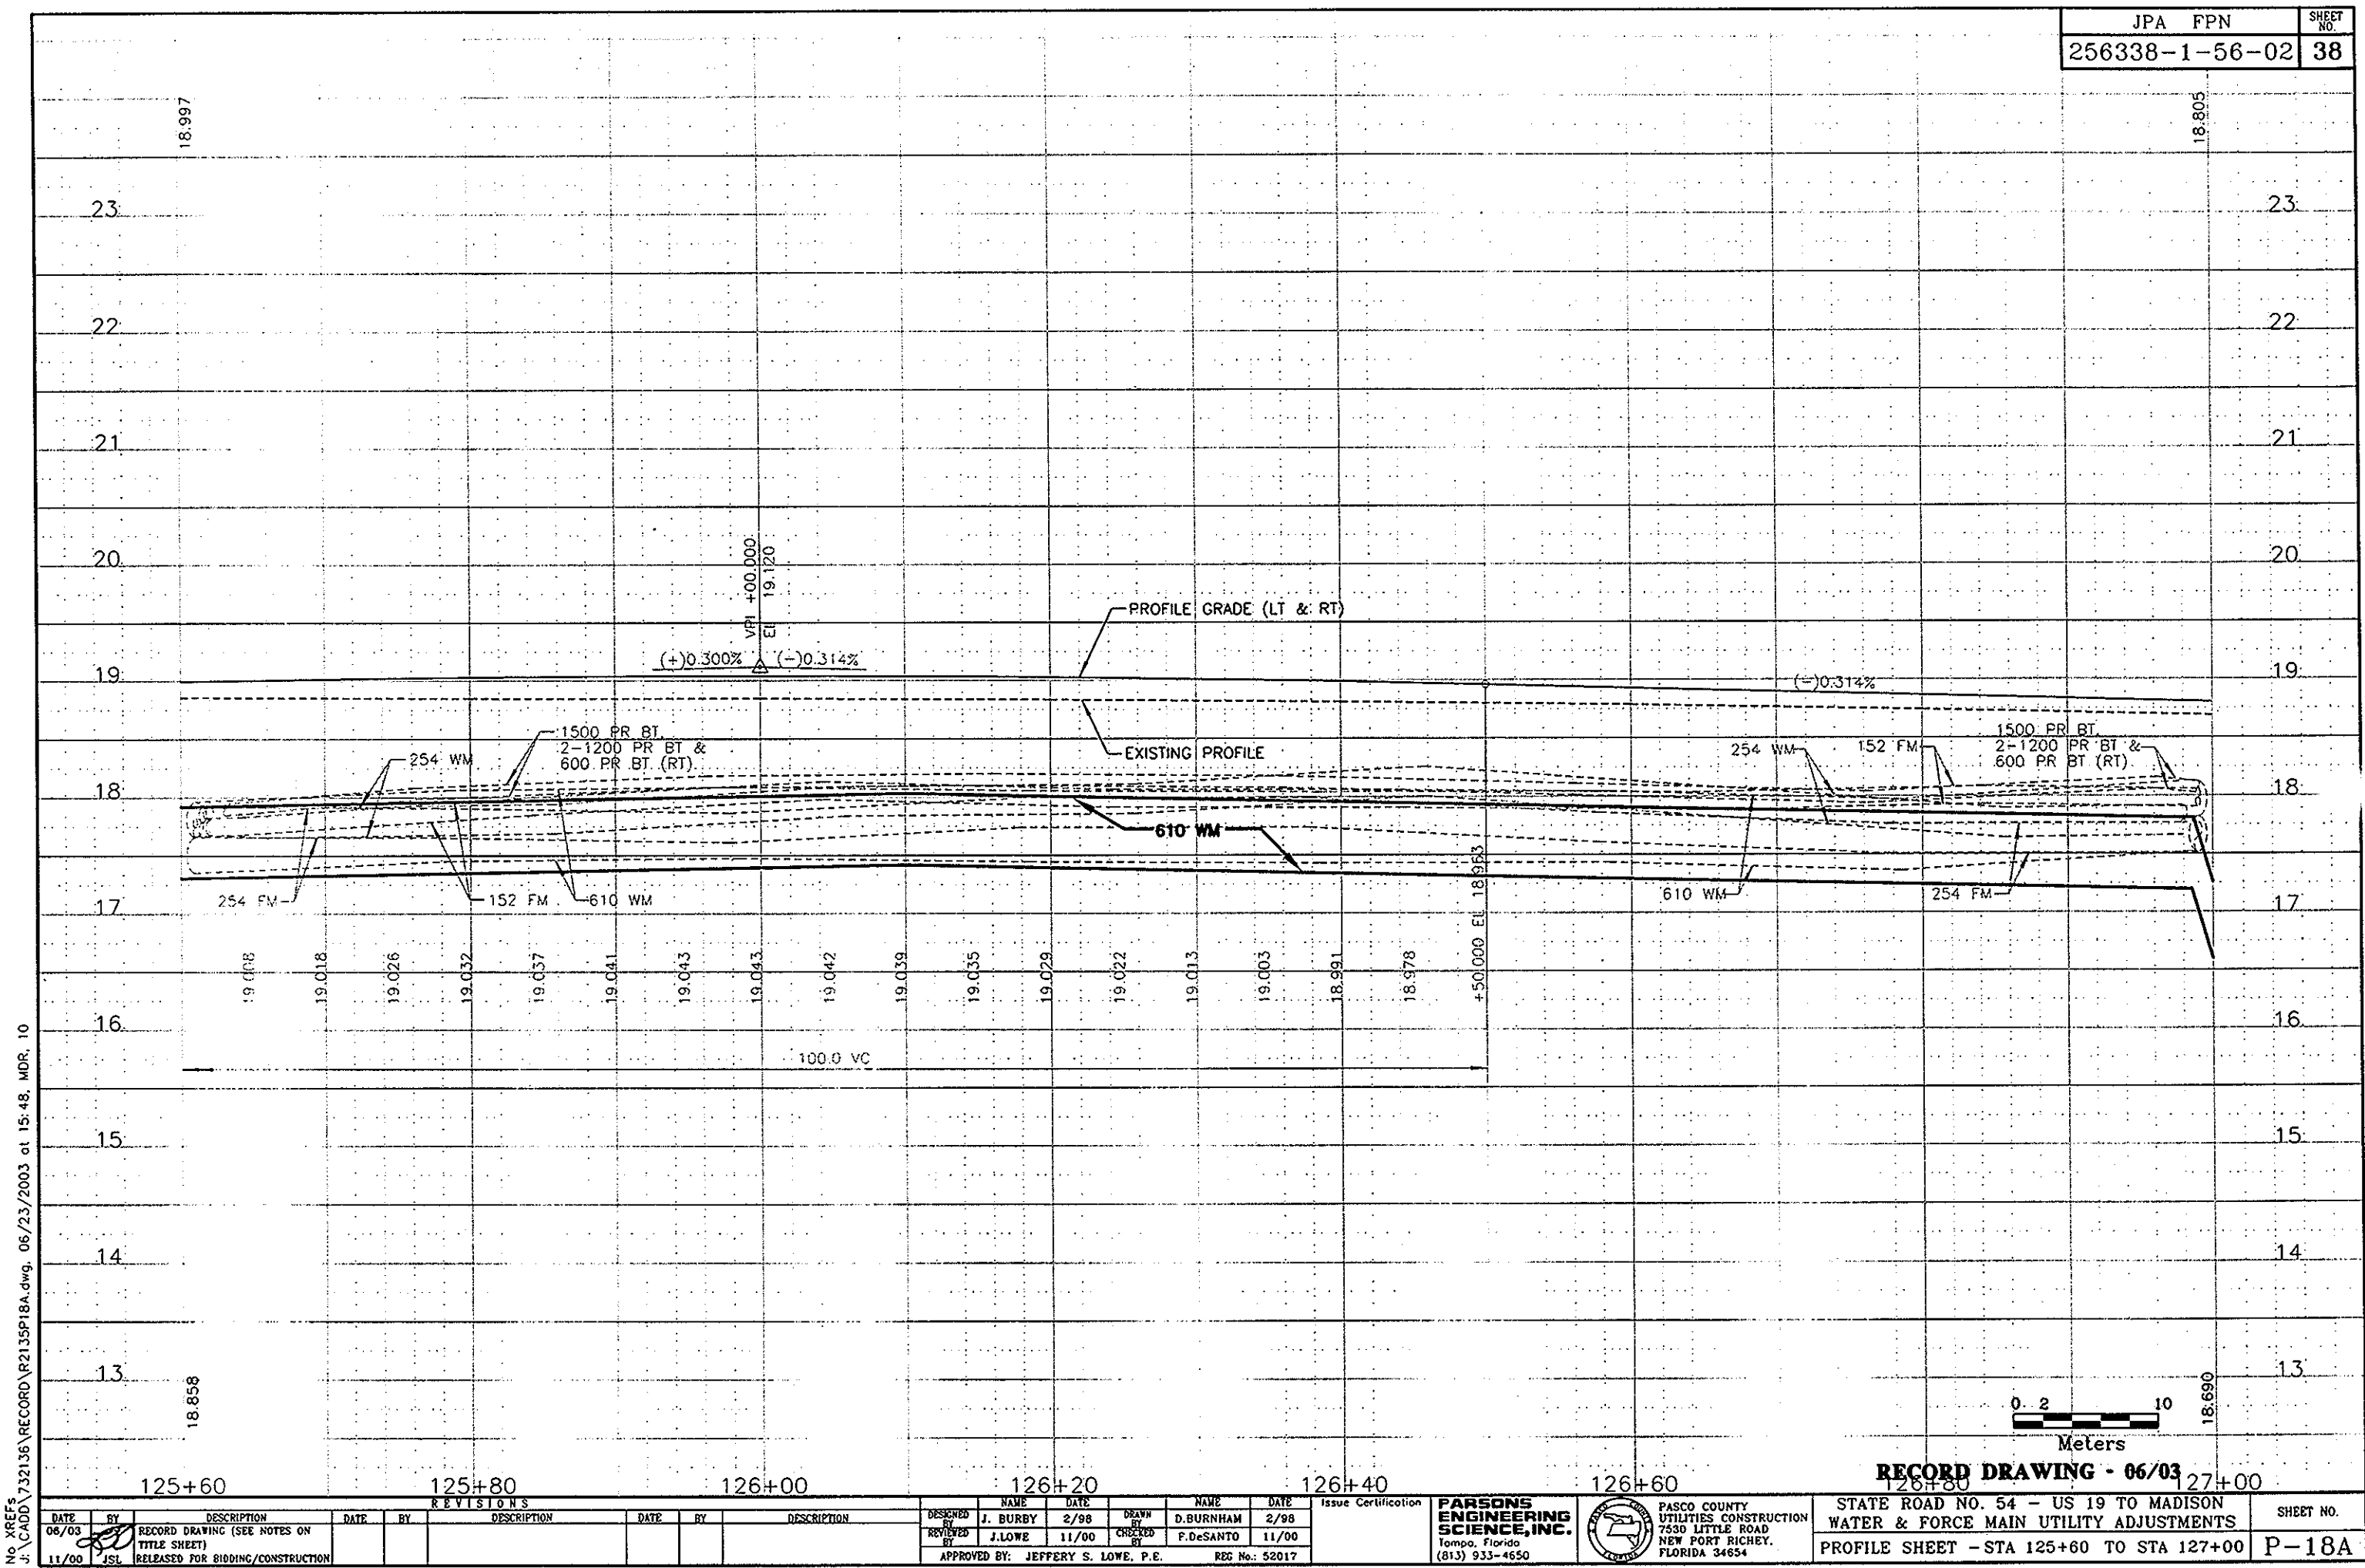

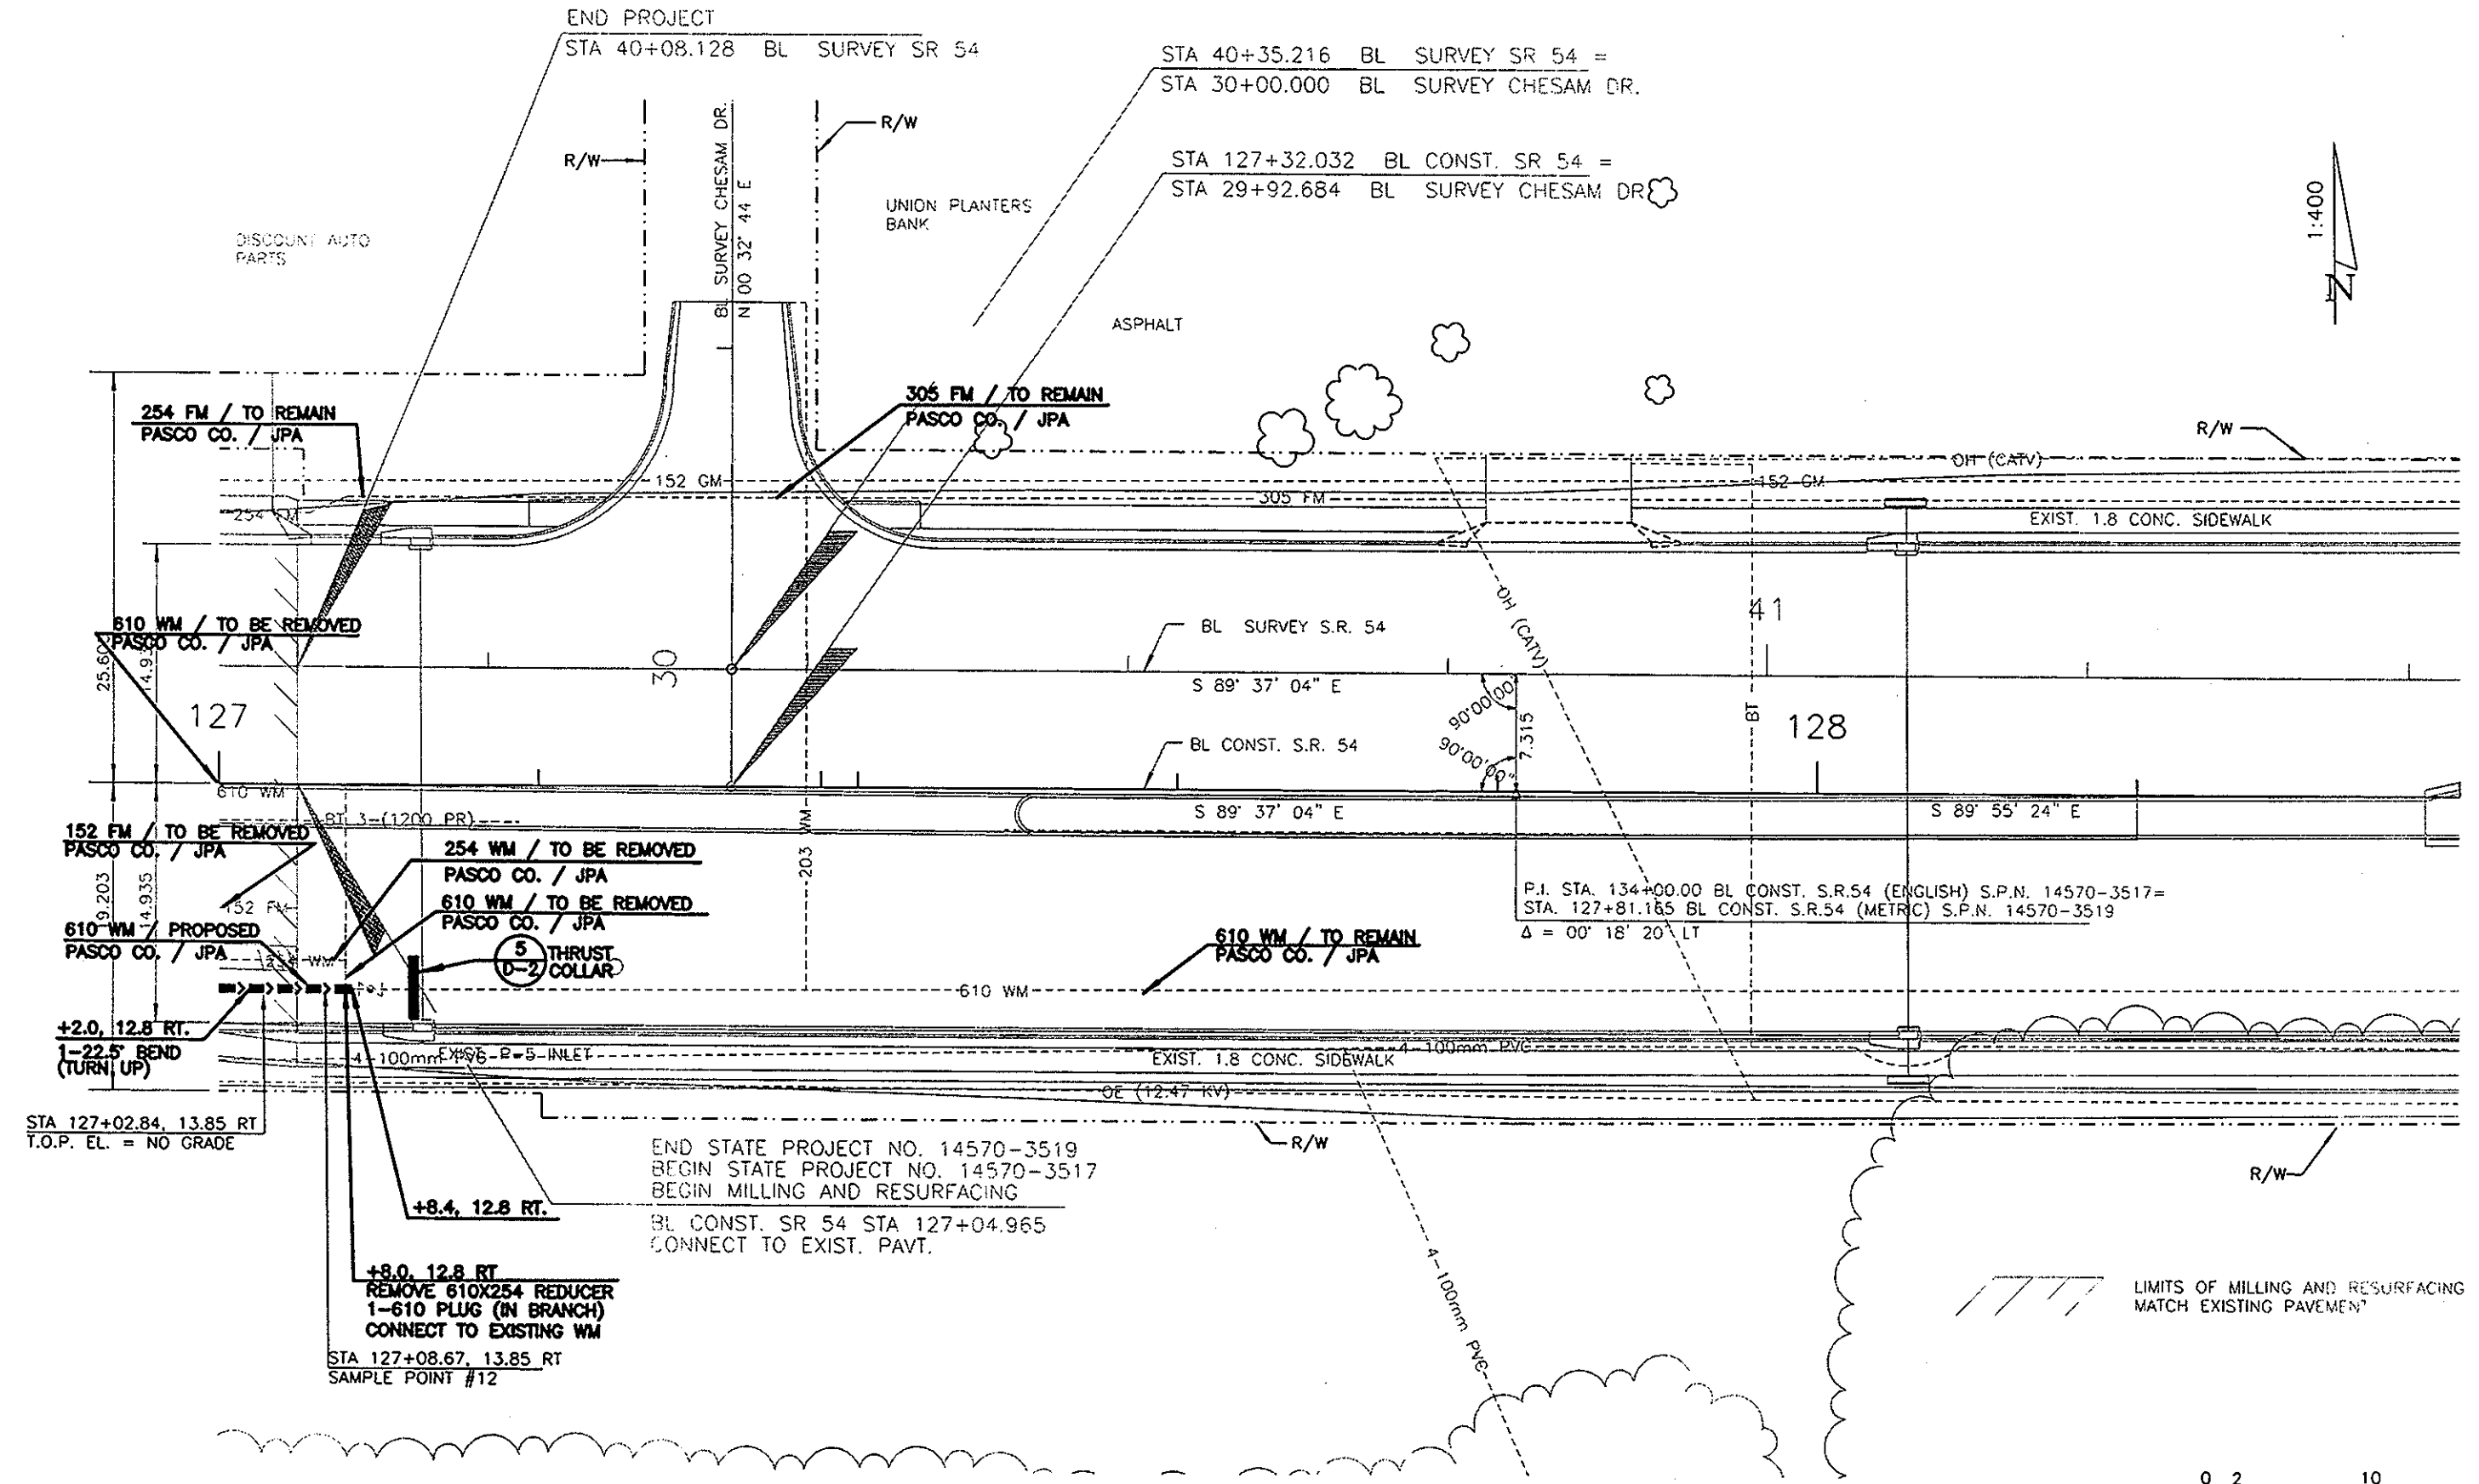

No XREFs
J:\CADD\732136\RECORD\2135P19.dwg, 06/23/2003 at 15:54, MDR, 10

REVISIONS				REVISIONS				REVISIONS			
DATE	BY	DESCRIPTION	DATE	BY	DESCRIPTION	DATE	BY	DESCRIPTION	DATE	BY	DESCRIPTION
06/03	J.BURBY	RECORD DRAWING (SEE NOTES ON TITLE SHEET)	11/00	J.LOWE	RELEASED FOR BIDDING/CONSTRUCTION						
APPROVED BY: JEFFERY S. LOWE, P.E.				REG No: 52017				Issue Certification			
DESIGNED BY: J.BURBY				DATE: 2/98				DRAWN BY: D.BURNHAM			
CHECKED BY: J.LOWE				DATE: 11/00				CHECKED BY: P.DeSANTO			
DATE: 11/00				DATE: 11/00				DATE: 11/00			
PARSONS ENGINEERING SCIENCE, INC.				PASCO COUNTY UTILITIES CONSTRUCTION				STATE ROAD NO. 54 - US 19 TO MADISON WATER & FORCE MAIN UTILITY ADJUSTMENTS			
Tampa, Florida (813) 933-4650				7650 LITTLE ROAD NEW PORT RICHEY, FLORIDA 34654				PLAN SHEET - STA 127+00 TO STA 128+40			
SHEET NO.				P-19				SHEET NO.			

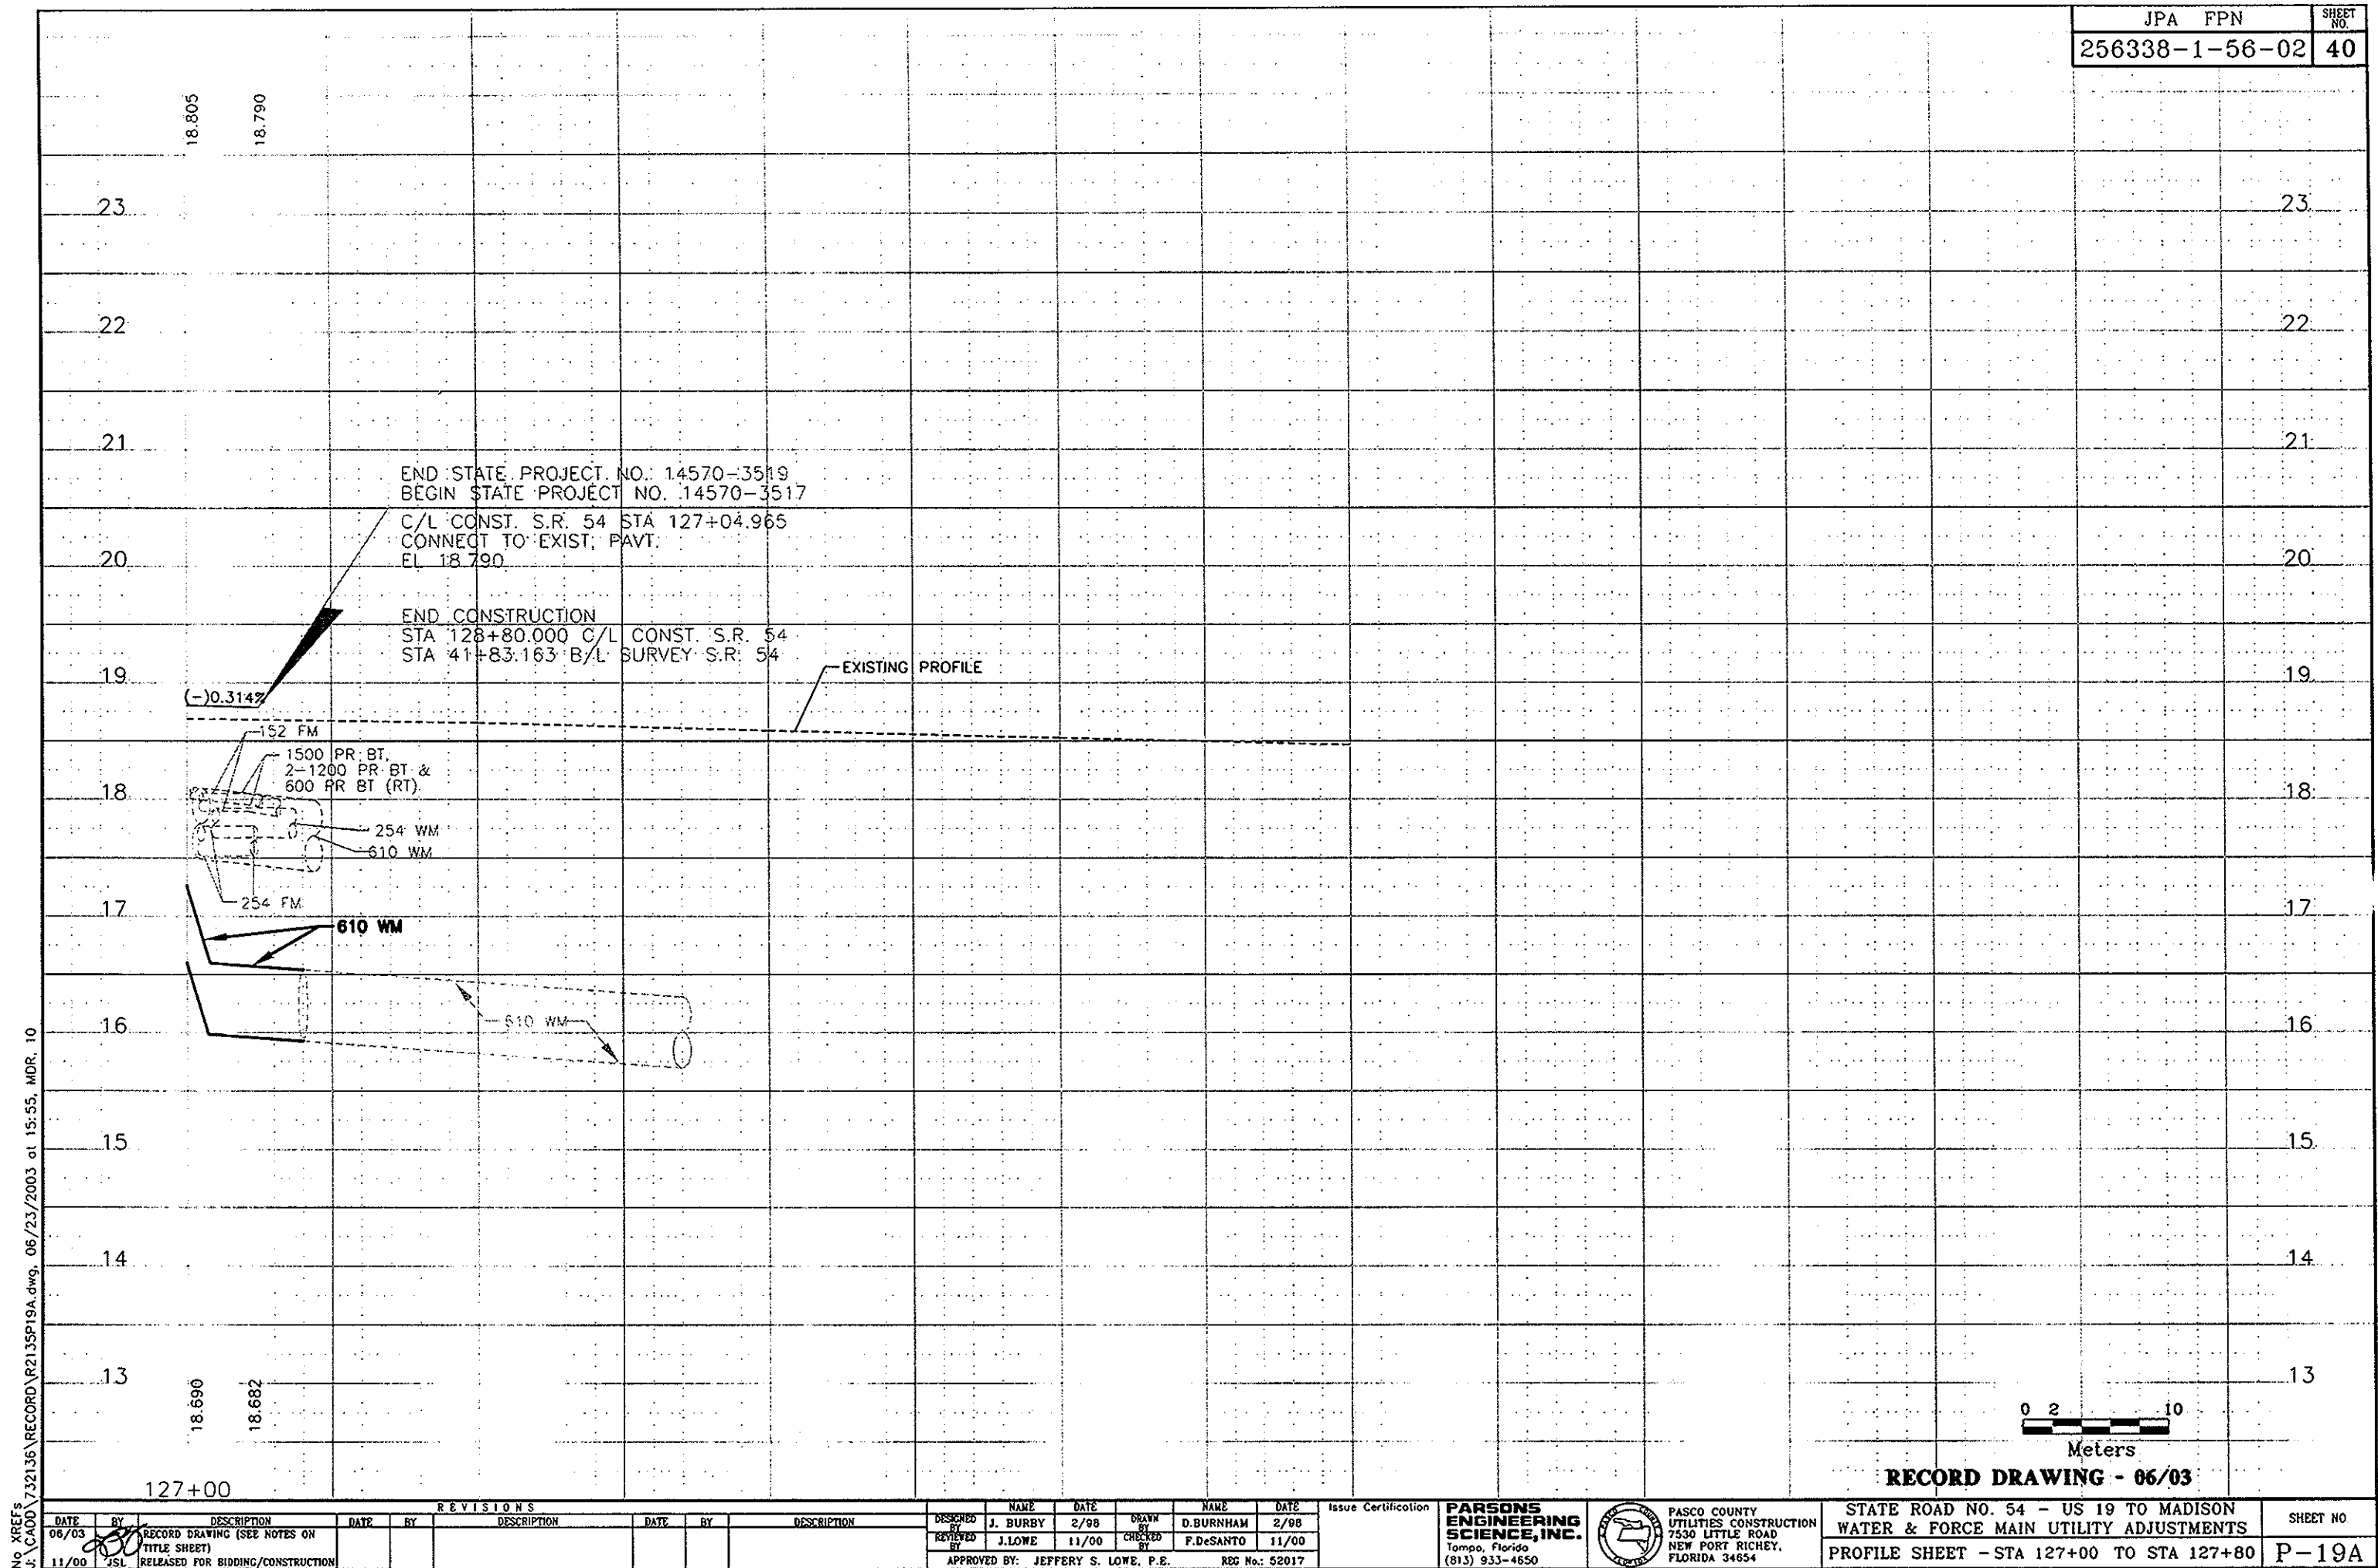

No. REFs
C:\CADD\132136\RECORD\132136\19A.dwg, 06/23/2003 at 15:55, MDR, 10

BEGIN PROJECT
CONNECT TO EXIST. PAVT.
STA 15+46.990 B/L SURVEY S.R. 54
STA 102+43.967 C/L CONST. S.R. 54

BEGIN CONSTRUCTION
STA 15+35.096 B/L SURVEY S.R. 54
STA 102+32.073 C/L CONST. S.R. 54
OFFSET: 26.232 RT

CONFLICT MANHOLE
STA 102+64.02 RT
CONST. CONFLICT MANHOLE TYPE J-7
(2100 X 2100)
INDEX NOS 200,201
TOP EL. 7.86
FL 4.96 N.S.
CONFLICT EL. 5.47 (TO BE FIELD VERIFIED PRIOR TO FABRICATION)
BOTT EL. 3.98

EXISTING PROFILE AT
C/L CONST. S.R. 54

FROM
EXISTING STRUCTURE

EXISTING 600
PIPE

PROFILE GRADE (LT & RT)

EXISTING PROFILE AT
B/L SURVEY S.R. 54

2-100mm COND.
1800 BT &
900 BT RT

Wh (358 FM)
TOP EL. 6.80

203 WM LT.
203 WM RT.

4-100mm COND.
1800 BT &
900 BT RT

305 WM

162 WM

CONST. 600
PIPE

985 STEEL SLEEVE




102+60 102+80 102+100 102+120

RECORD DRAWING - 06/03



REVISIONS										102+60				102+80				103+00				103+20									
DATE	BY	DESCRIPTION	DATE	BY	DESCRIPTION	DATE	BY	DESCRIPTION	DATE	BY	DESCRIPTION	NAME	DATE	NAME	DATE	NAME	DATE	NAME	DATE	NAME	DATE										
06/03	JSL	RECORD DRAWING (SEE NOTES ON TITLE SHEET)										J. BURBY	2/98	D. BURNHAM	2/98																
11/00	JSL	RELEASED FOR BIDDING/CONSTRUCTION										J. LOWE	11/00	F. DeSANTO	11/00																
APPROVED BY: JEFFERY S. LOWE, P.E.										REC NO: 52017				Issue Certification				PARSONS ENGINEERING SCIENCE, INC. Tampa, Florida (813) 933-4650				PASCO COUNTY UTILITIES CONSTRUCTION 7500 LITTLE ROAD NEW PORT RICHEY, FLORIDA 34654				STATE ROAD NO. 54 - US 19 TO MADISON WATER & FORCE MAIN UTILITY ADJUSTMENTS PROFILE SHEET - STA 102+00 TO STA 105+20				SHEET NO. P-1A	




REVISIONS										NAME		DATE		Issue Certification		PARSONS ENGINEERING SCIENCE, INC.		 PASCO COUNTY UTILITIES CONSTRUCTION 7530 LITTLE ROAD NEW PORT RICHEY, FLORIDA 34654		STATE ROAD NO. 54 - US 19 TO MADISON WATER & FORCE MAIN UTILITY ADJUSTMENTS		SHEET NO.							
DATE	BY	DESCRIPTION	DATE	BY	DESCRIPTION	DATE	BY	DESCRIPTION	DESCRIBED BY	NAME	DATE	DATE	DATE	DATE	DATE	DATE	DATE	DATE	DATE	DATE	DATE	DATE	DATE						
06/03	JSL	RECORD DRAWING (SEE NOTES ON TITLE SHEET)							REVIEWED BY	J. BURBY	2/98	DRAWN BY	D. BURNHAM	2/98															
11/00	JSL	RELEASED FOR BIDDING/CONSTRUCTION							CHECKED BY	J. LOWE	11/00		F. DESANTO	11/00															
										APPROVED BY: JEFFERY S. LOWE, P.E.										REC No.: 52017									
																				Tampa, Florida (813) 933-4650						PLAN SHEET - STA 103+20 TO STA 104+60		P-2	

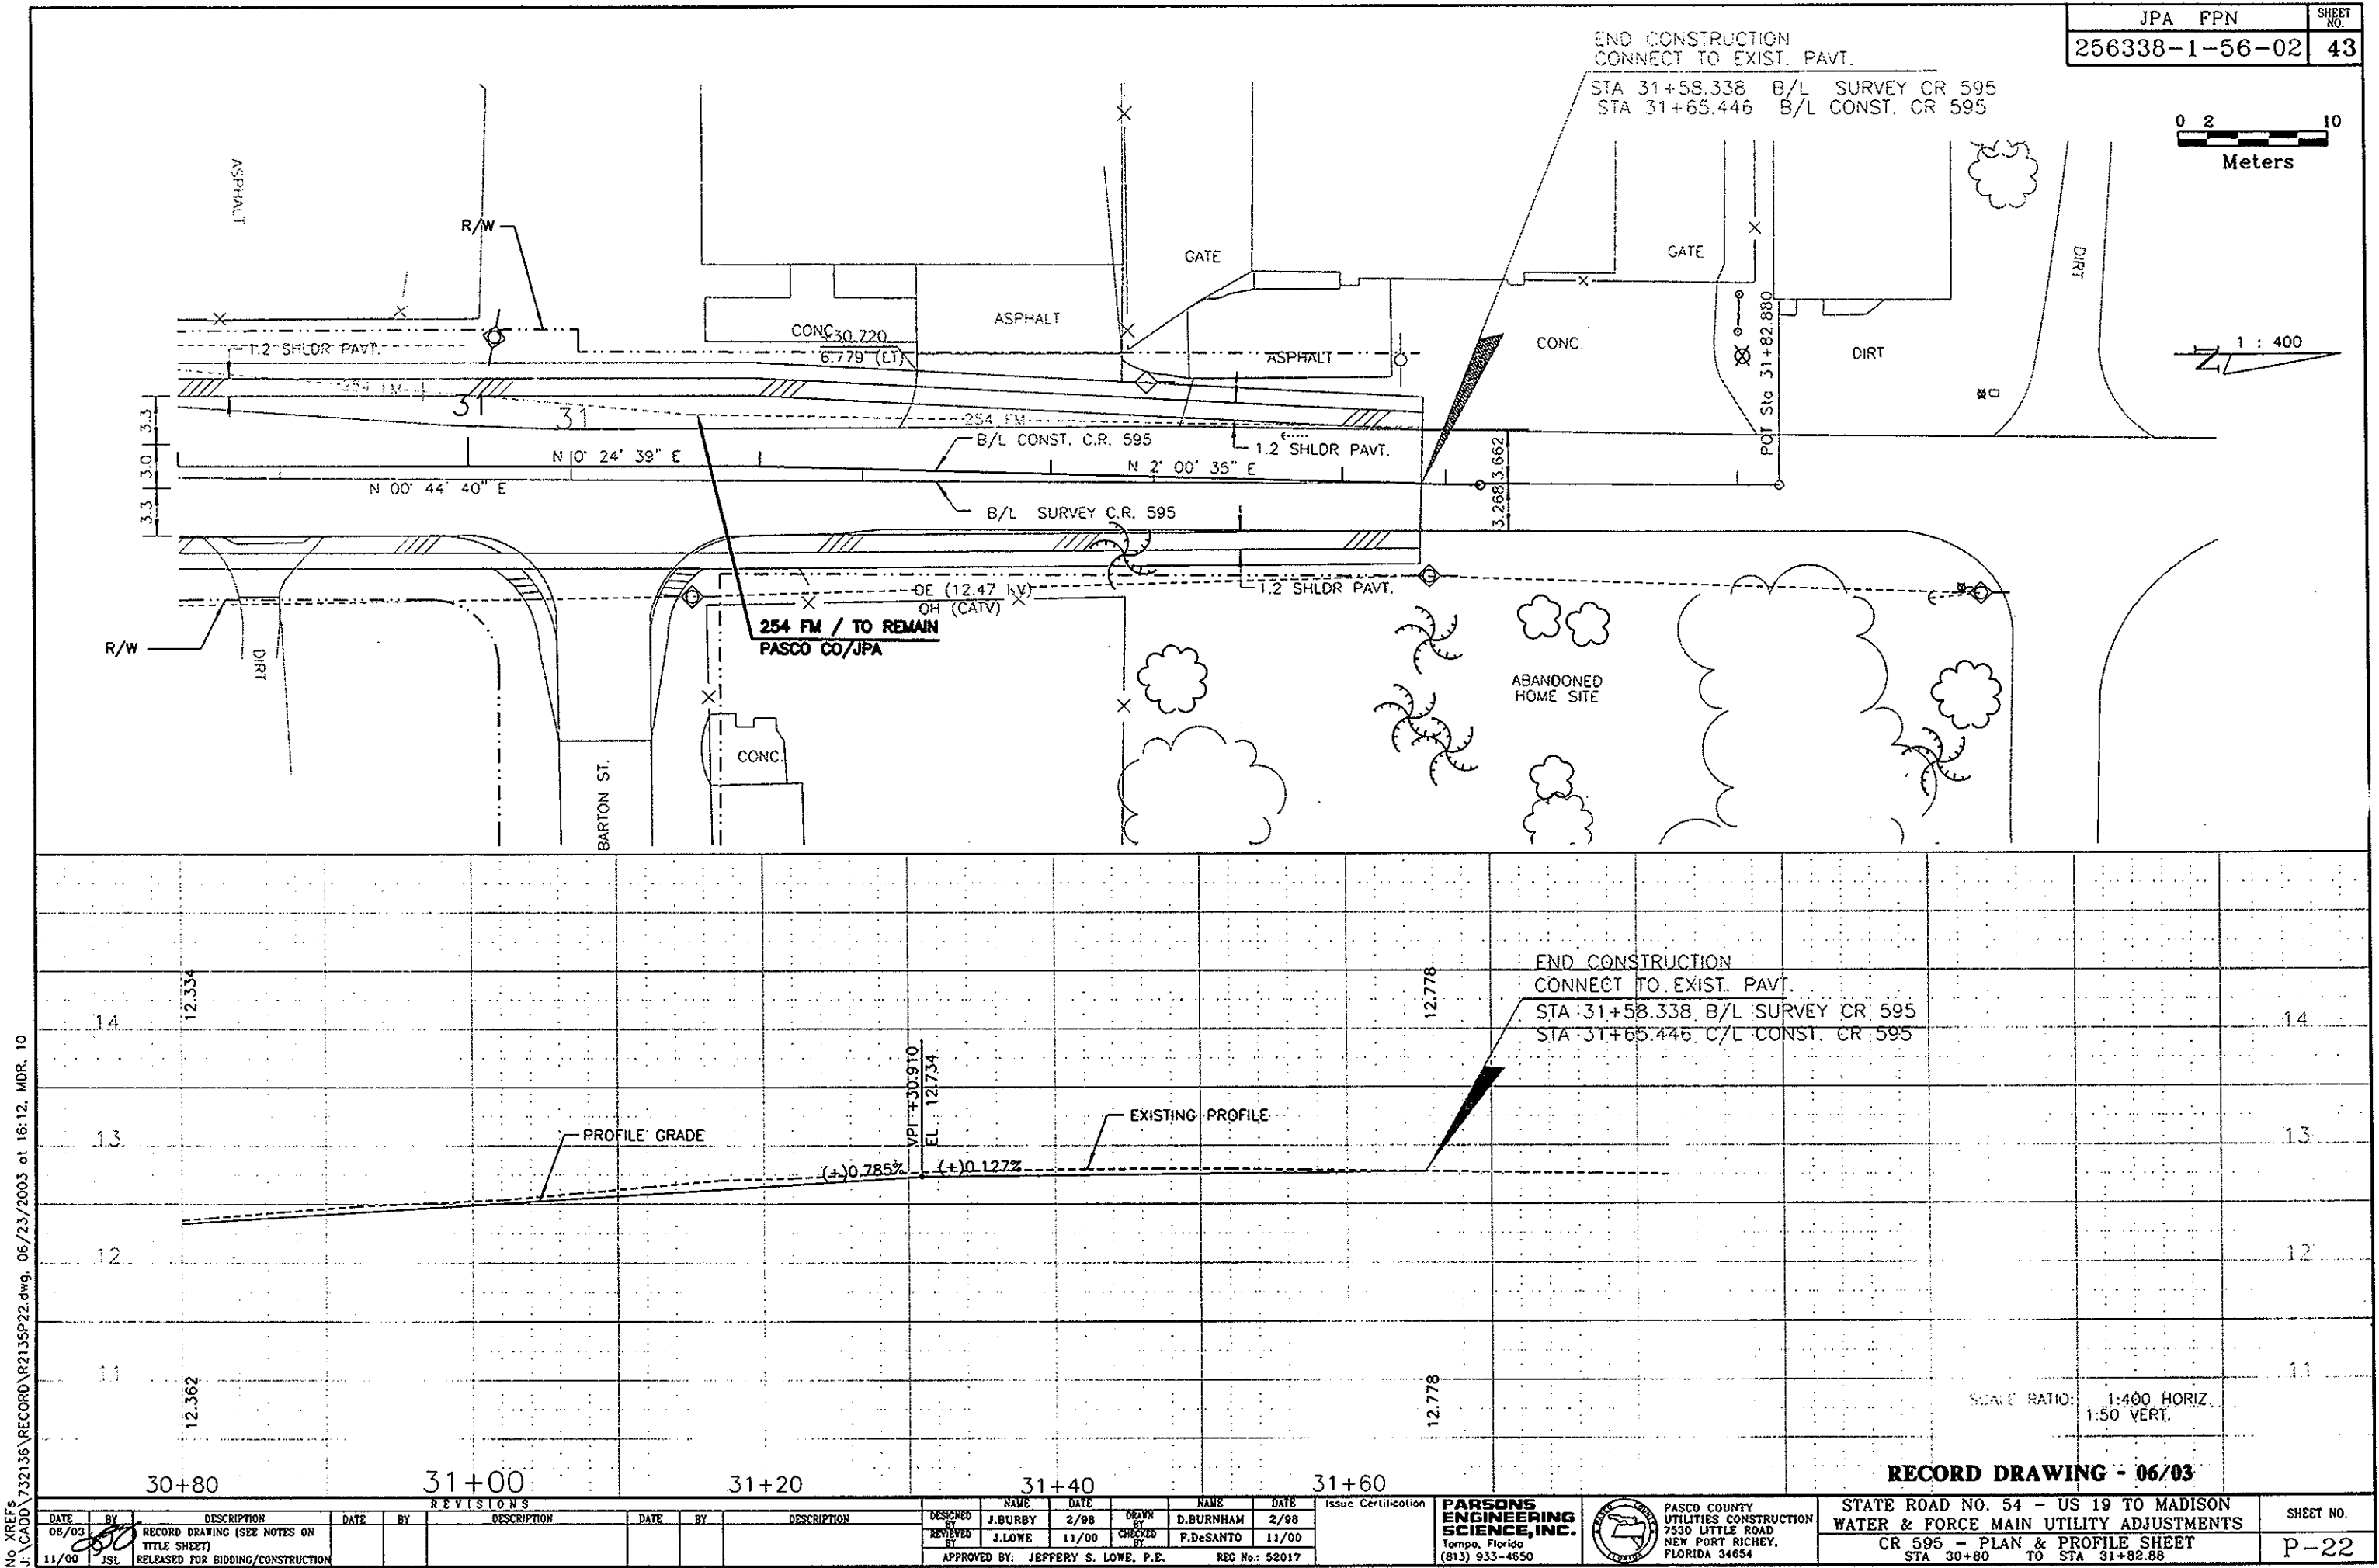


BEGIN CONSTRUCTION
CONNECT TO EXIST. PAVT.
STA 28+34.346 B/L SURVEY MADISON ST.

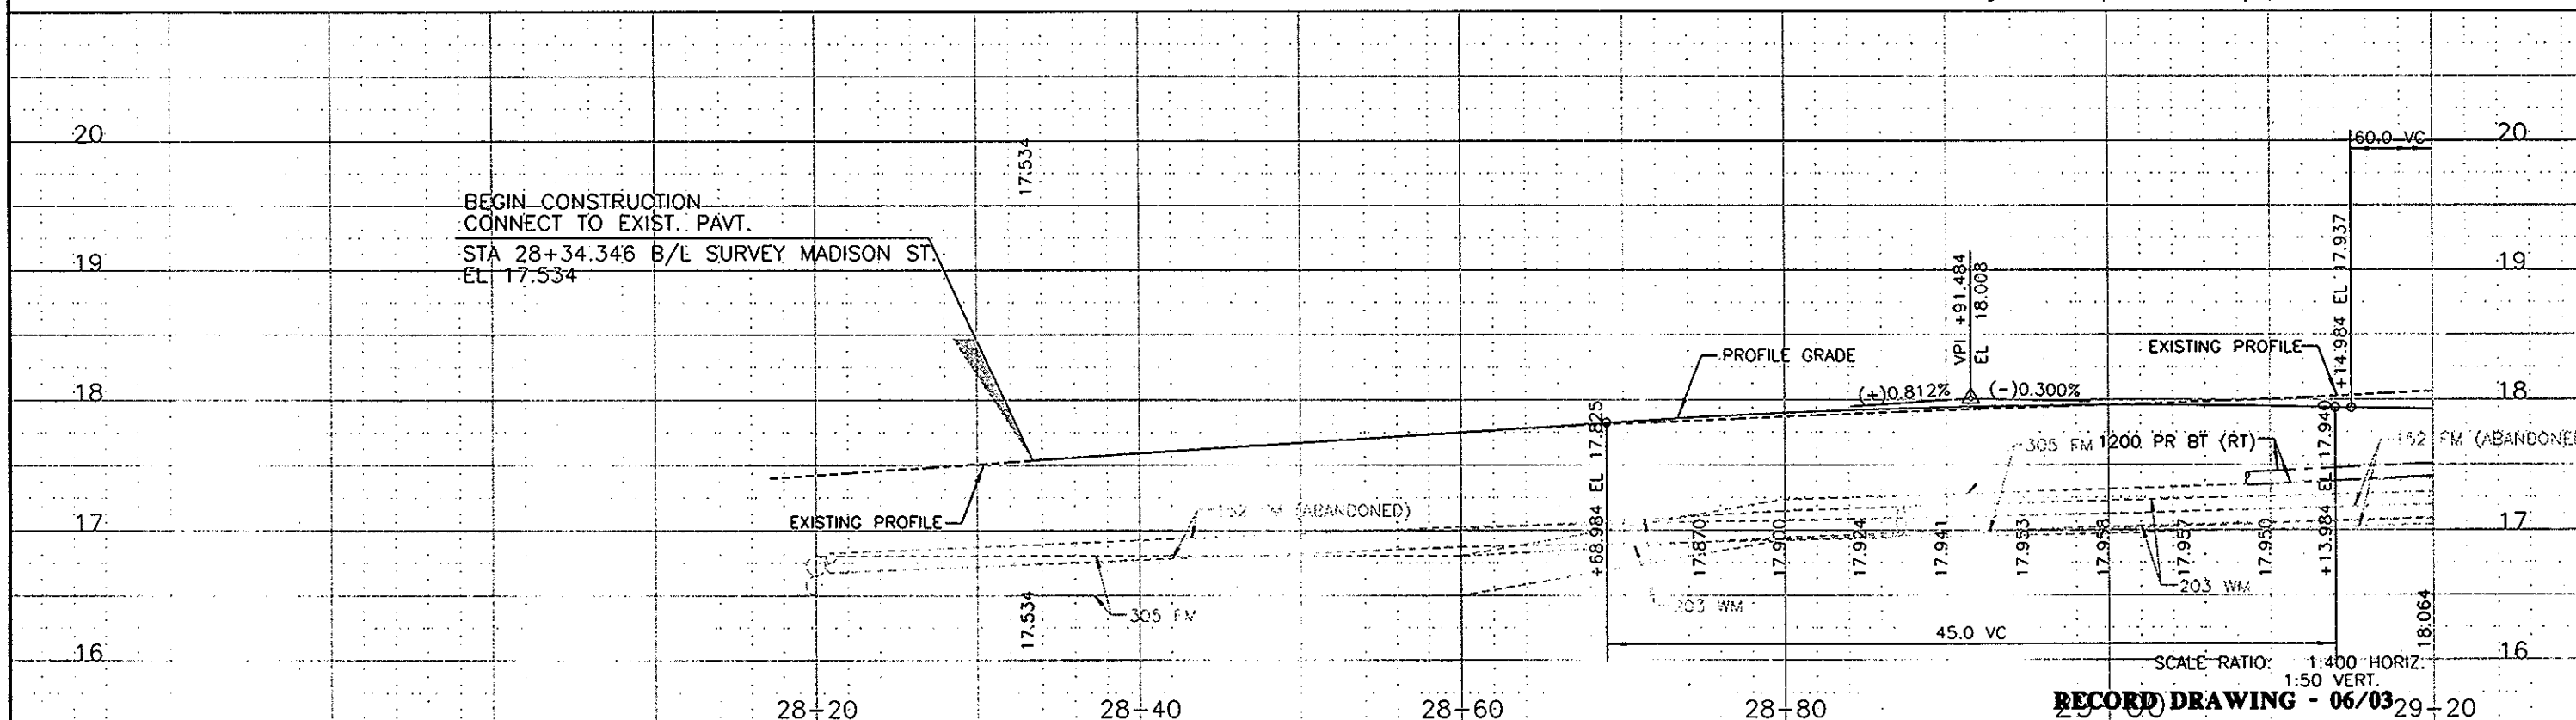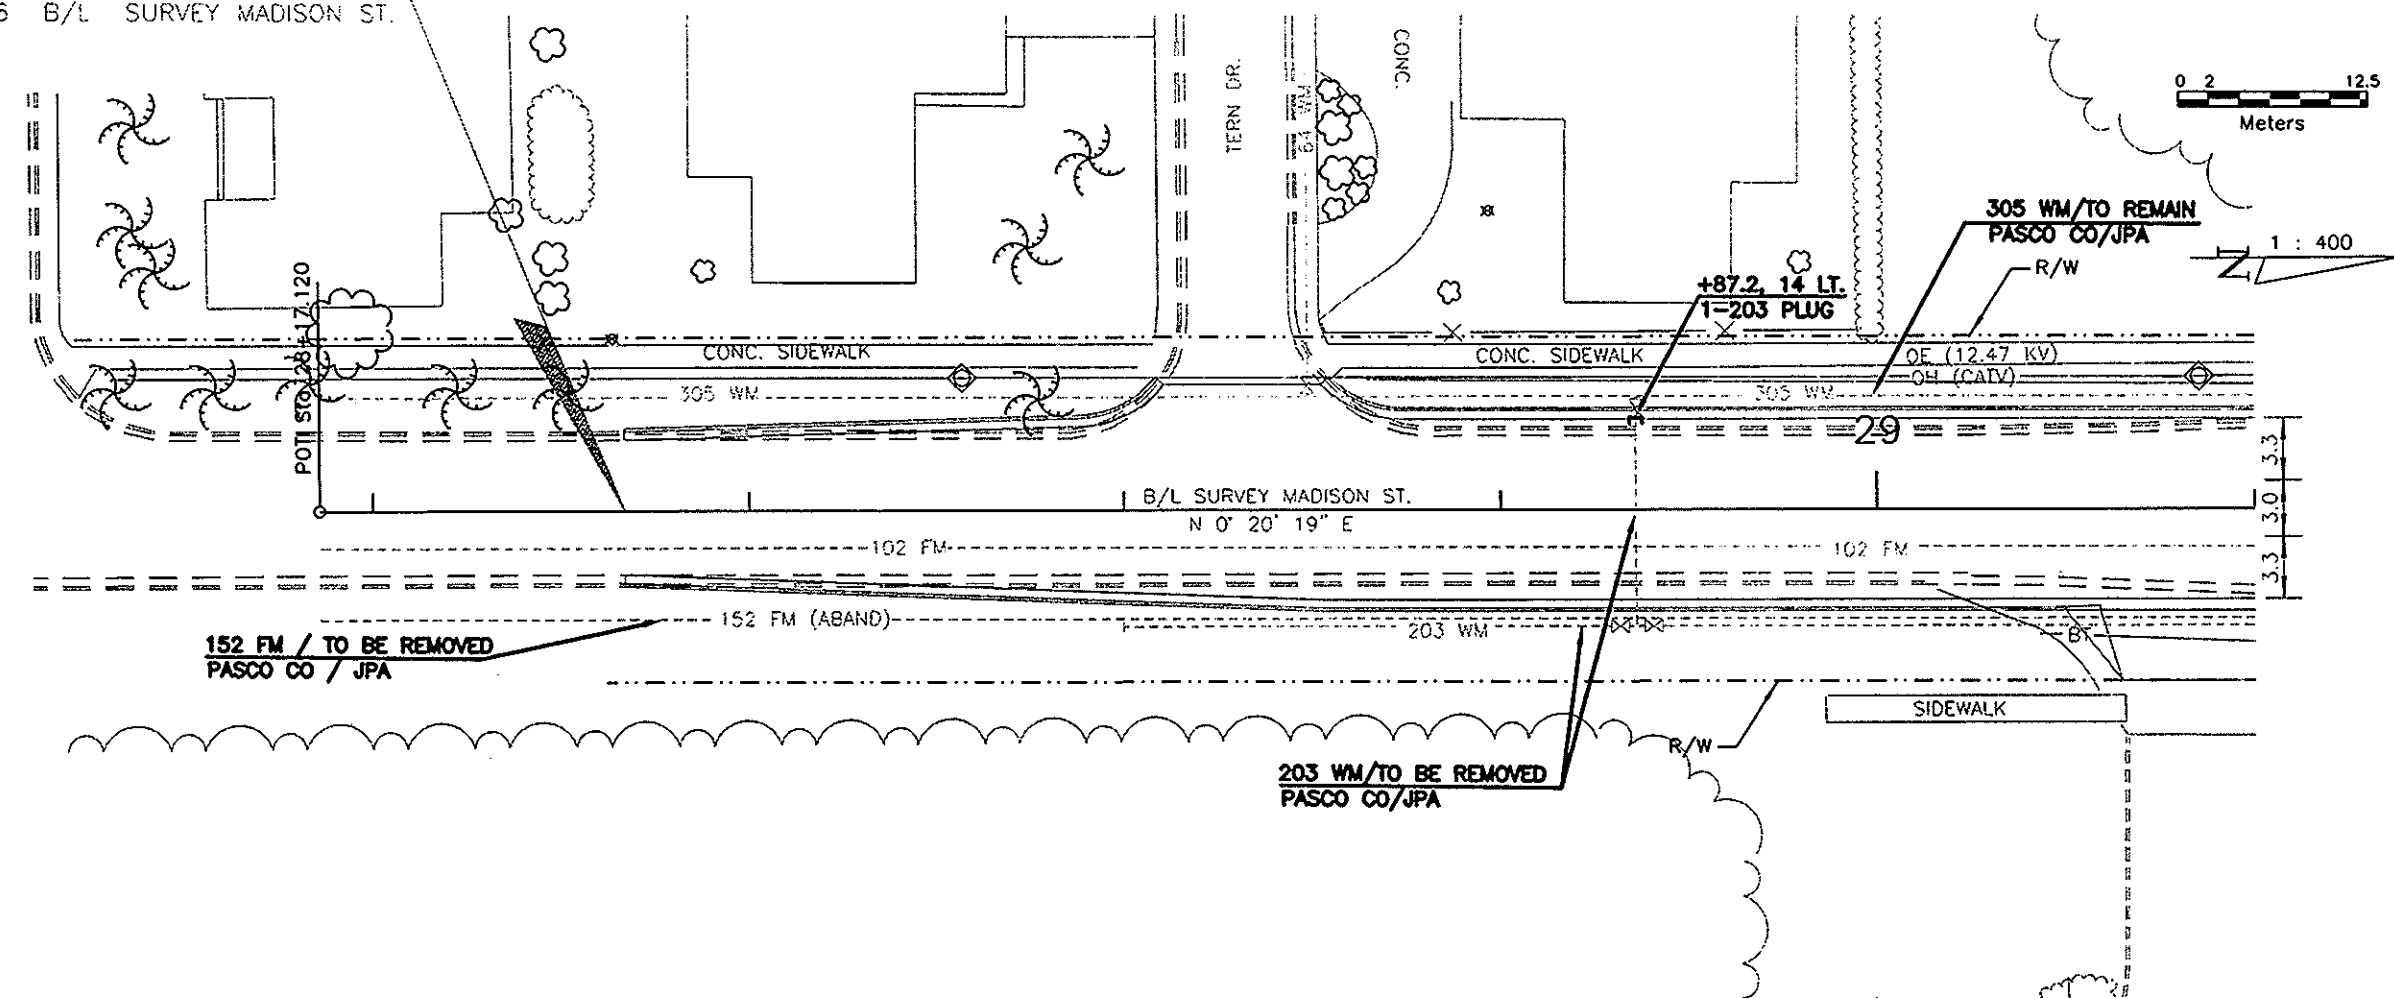


R E V I S I O N S													Issue Certification		 PASCO COUNTY ENGINEERING SCIENCE, INC. (813) 933-4650	 PASCO COUNTY UTILITIES CONSTRUCTION 7530 LITTLE ROAD NEW PORT RICHEY, FLORIDA 34654	STATE ROAD NO. 54 - US 19 TO MADISON WATER & FORCE MAIN UTILITY ADJUSTMENTS MADISON STREET - PLAN & PROFILE SHEET STA 28+20 TO STA 29+20	SHEET NO.
DATE	BY	DESCRIPTION	DATE	BY	DESCRIPTION	DATE	BY	DESCRIPTION	DESIGNED	DATE	DRAWN	DATE						
06/02	JSL	RECORD DRAWING (SEE NOTES ON TITLE SHEET)							DESIGNED	J.BURBY	2/98	DRAWN	D.BURNHAM	2/98				
11/00	JSL	RELEASED FOR BIDDING/CONSTRUCTION							REVISED	J.LOWE	11/00	CHECKED	P.F.SANTO	11/00				
APPROVED BY: JEFFERY S. LOWE, P.E.										REG No: 52017								

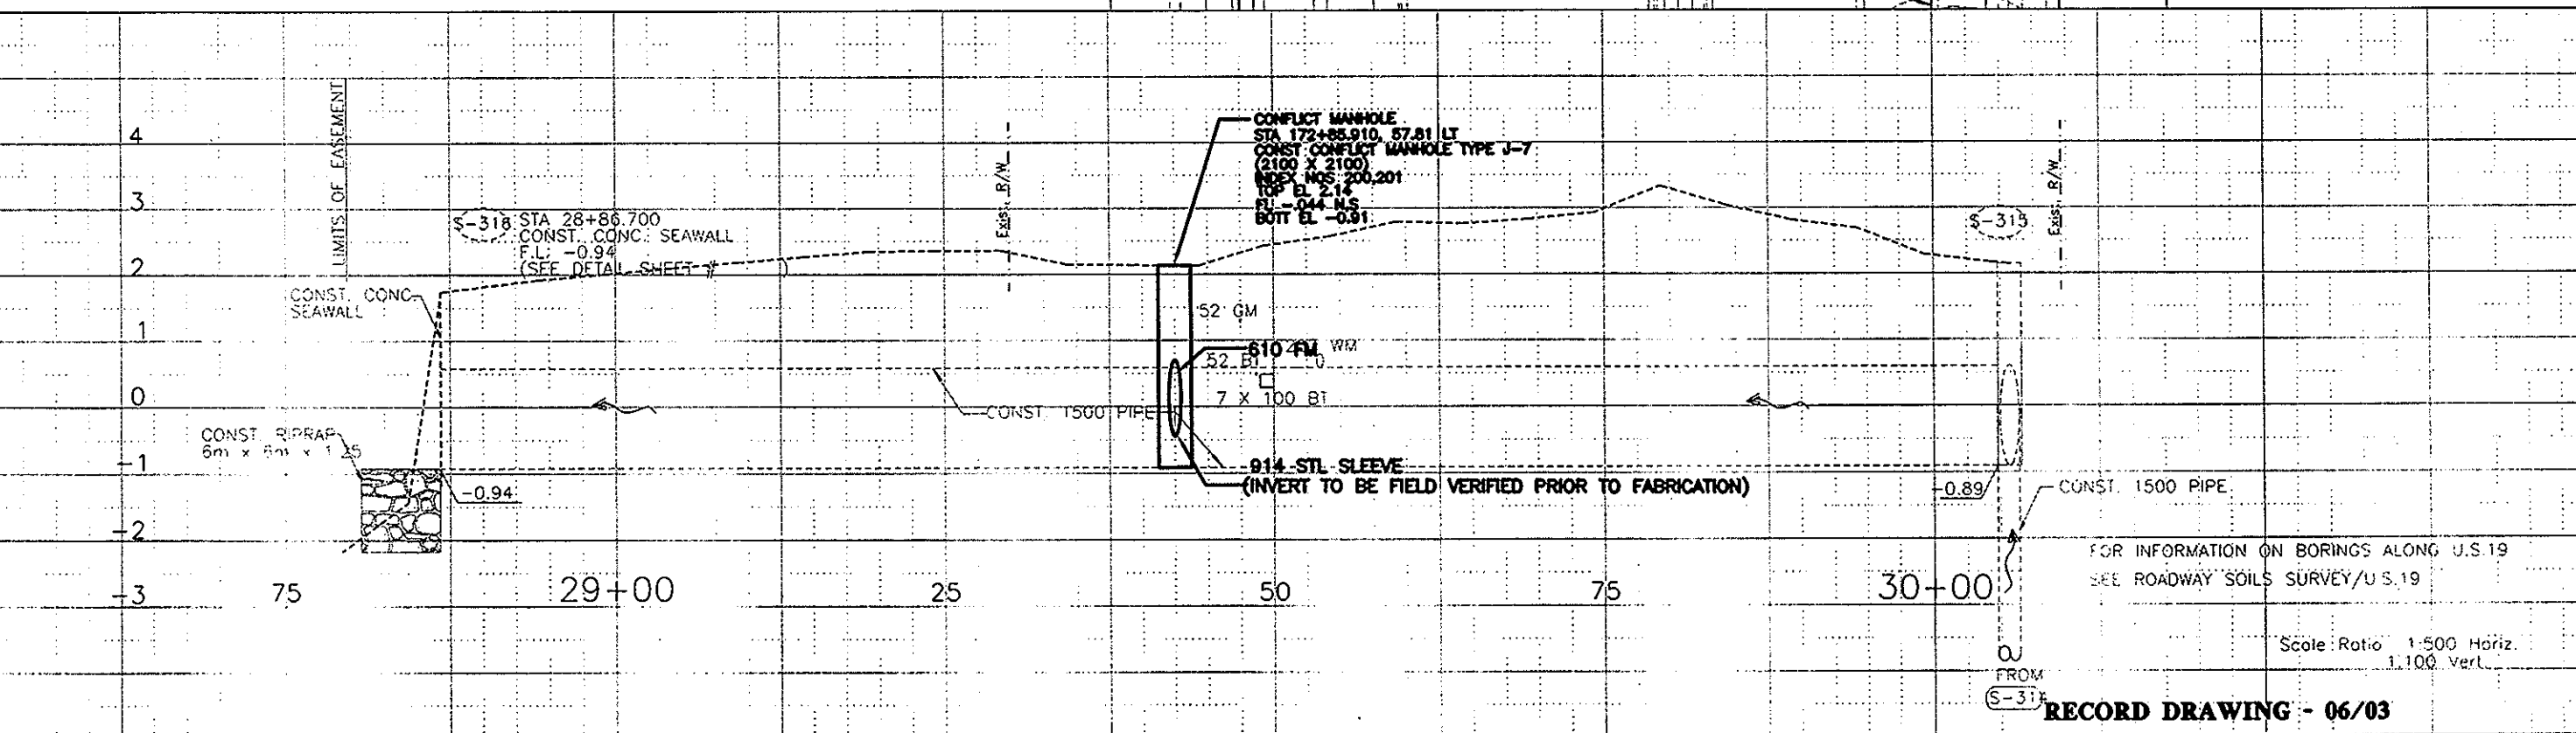

REVISIONS										NAME		DATE		DATE		Issue Certification	
DATE	BY	DESCRIPTION	DATE	BY	DESCRIPTION	DATE	BY	DESCRIPTION	NAME	DATE	NAME	DATE					
06/03	JSL	RECORD DRAWING (SEE NOTES ON TITLE SHEET)							J.BURNHAM	2/98	D.BURNHAM	2/98					
11/00	JSL	RELEASED FOR BIDDING/CONSTRUCTION							P.DeSANTO	11/00							
APPROVED BY: JEFFERY S. LOWE, P.E.										REC No: 52017							
										PARSONS ENGINEERING SCIENCE, INC.				PASCO COUNTY UTILITIES CONSTRUCTION SCIENCE ROAD NEW PORT RICHEY, FLORIDA 34654			
										Tampa, Florida (813) 933-4650				STATE ROAD NO. 54 - US 19 TO MADISON WATER & FORCE MAIN UTILITY ADJUSTMENTS US 19 OUTFALL - PLAN & PROFILE SHEET STA 28+86.896 TO STA 30+00			
														SHEET NO. P-25			

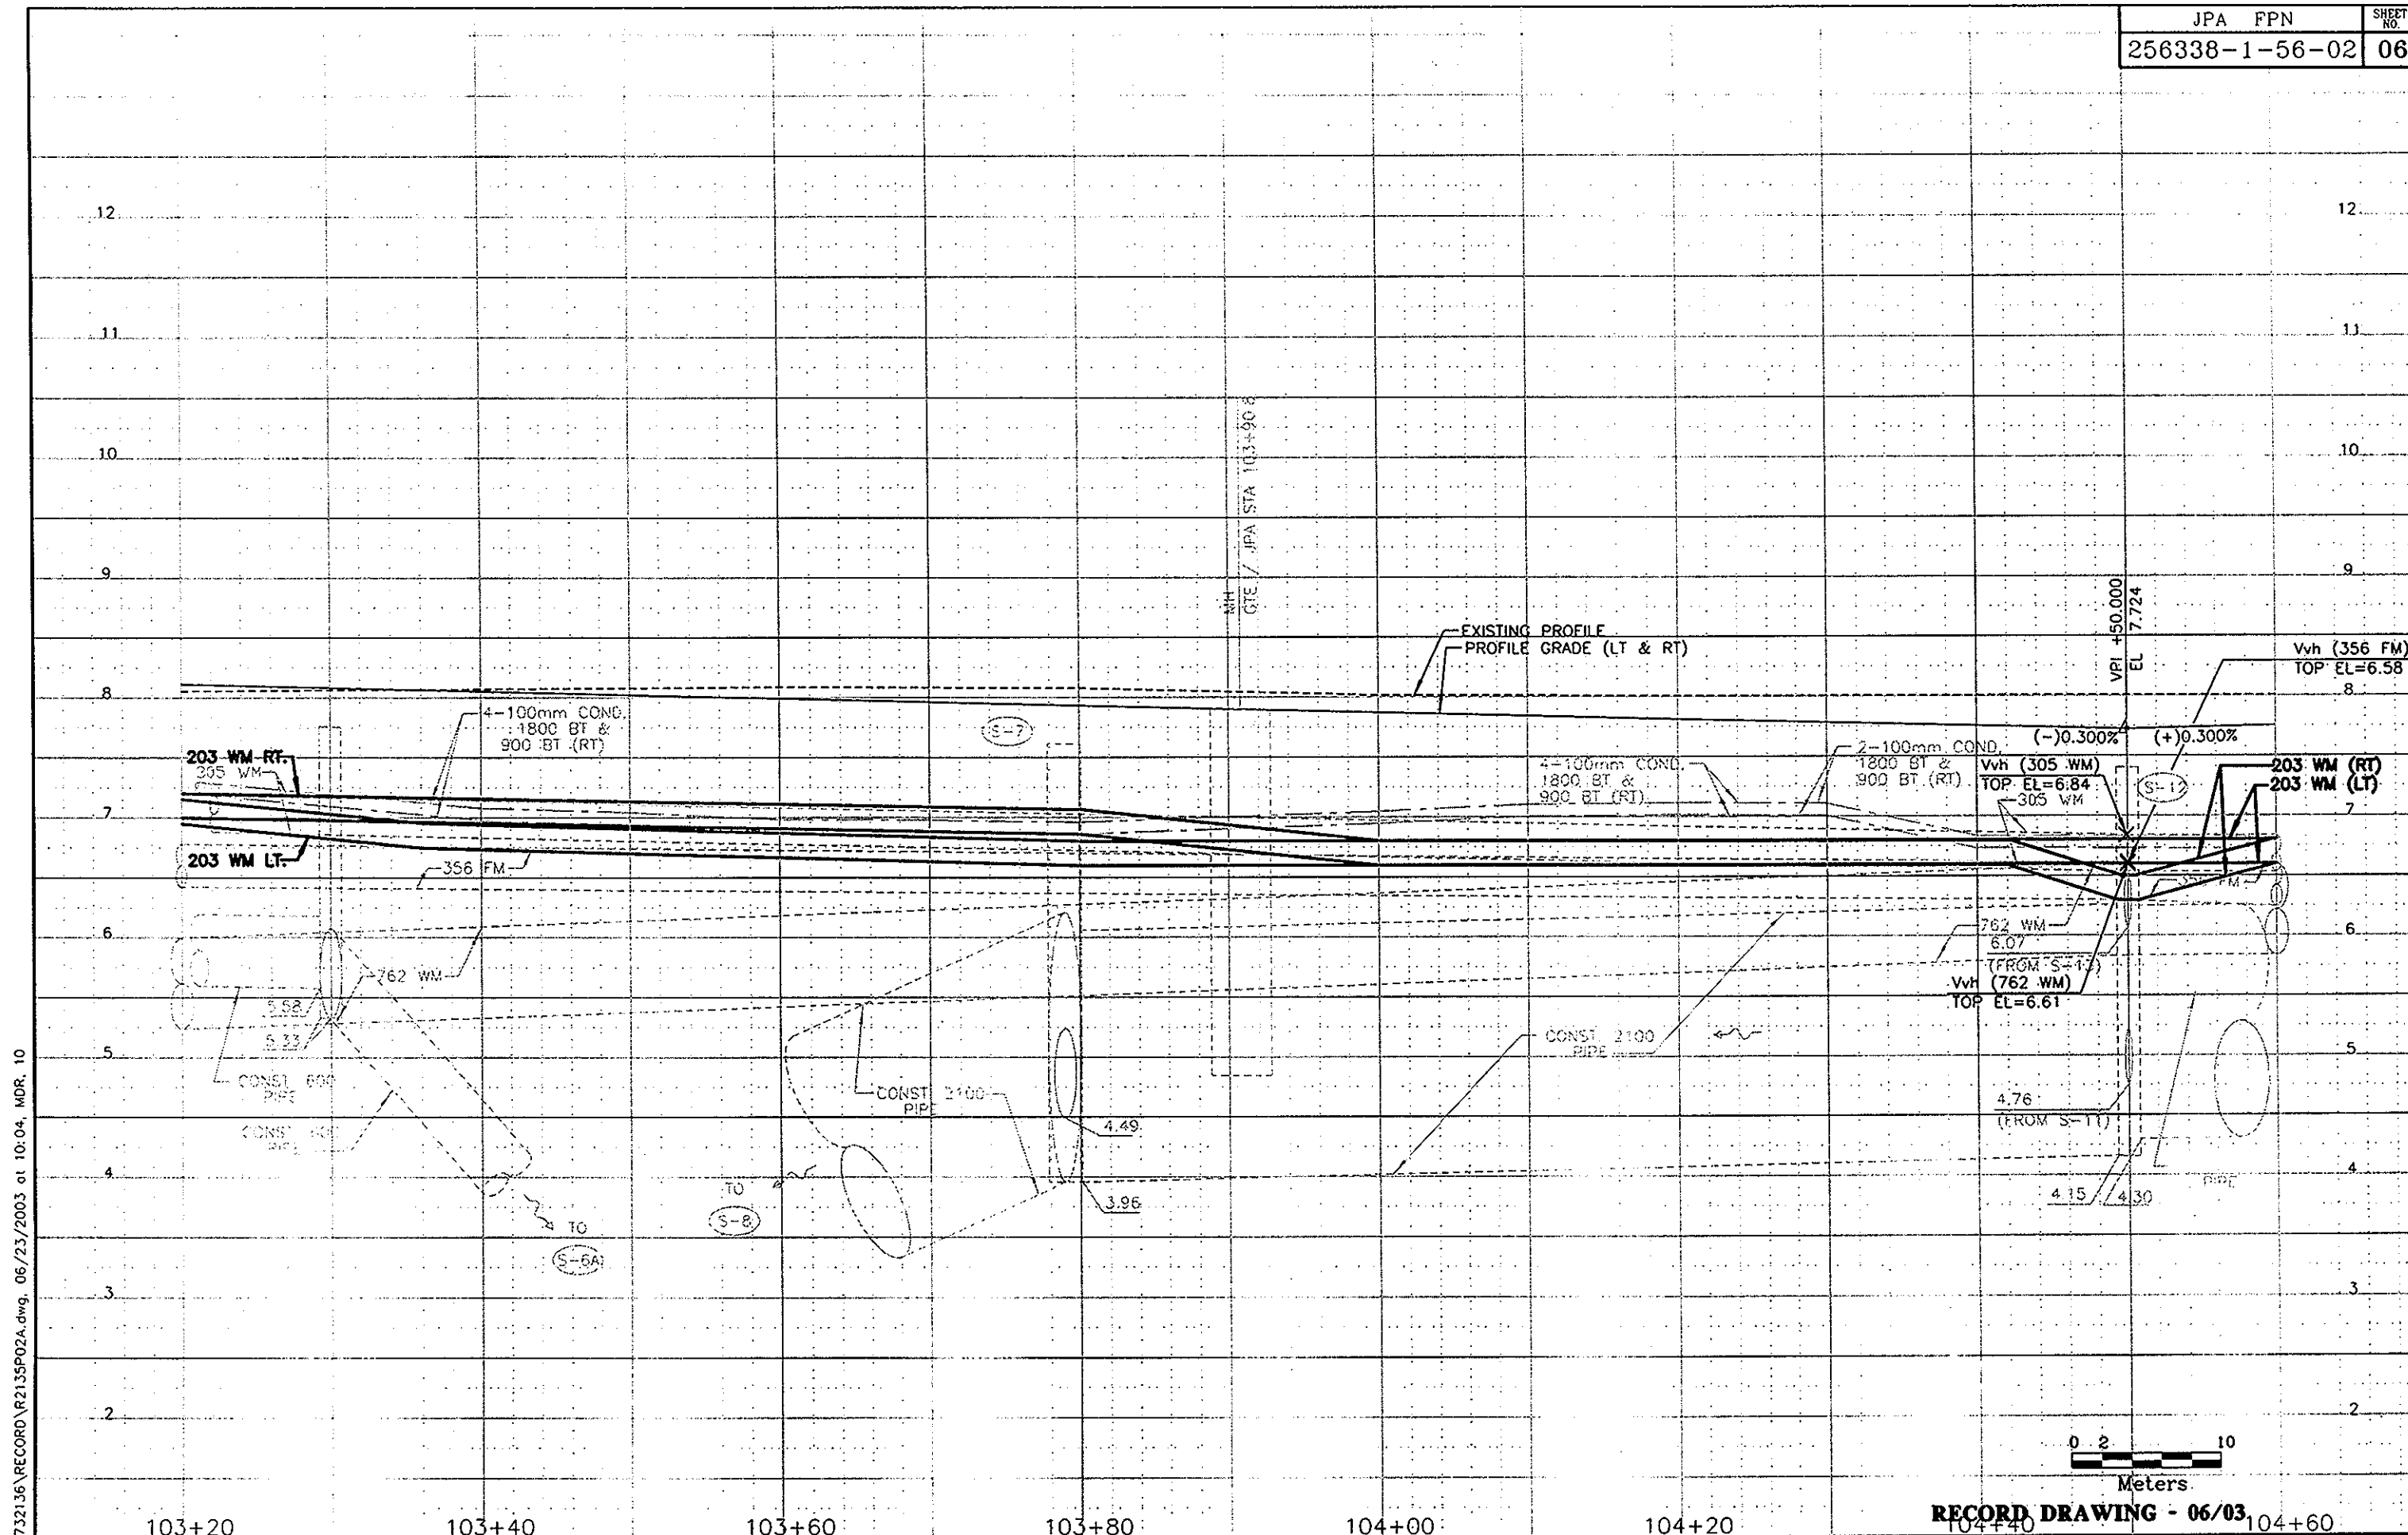

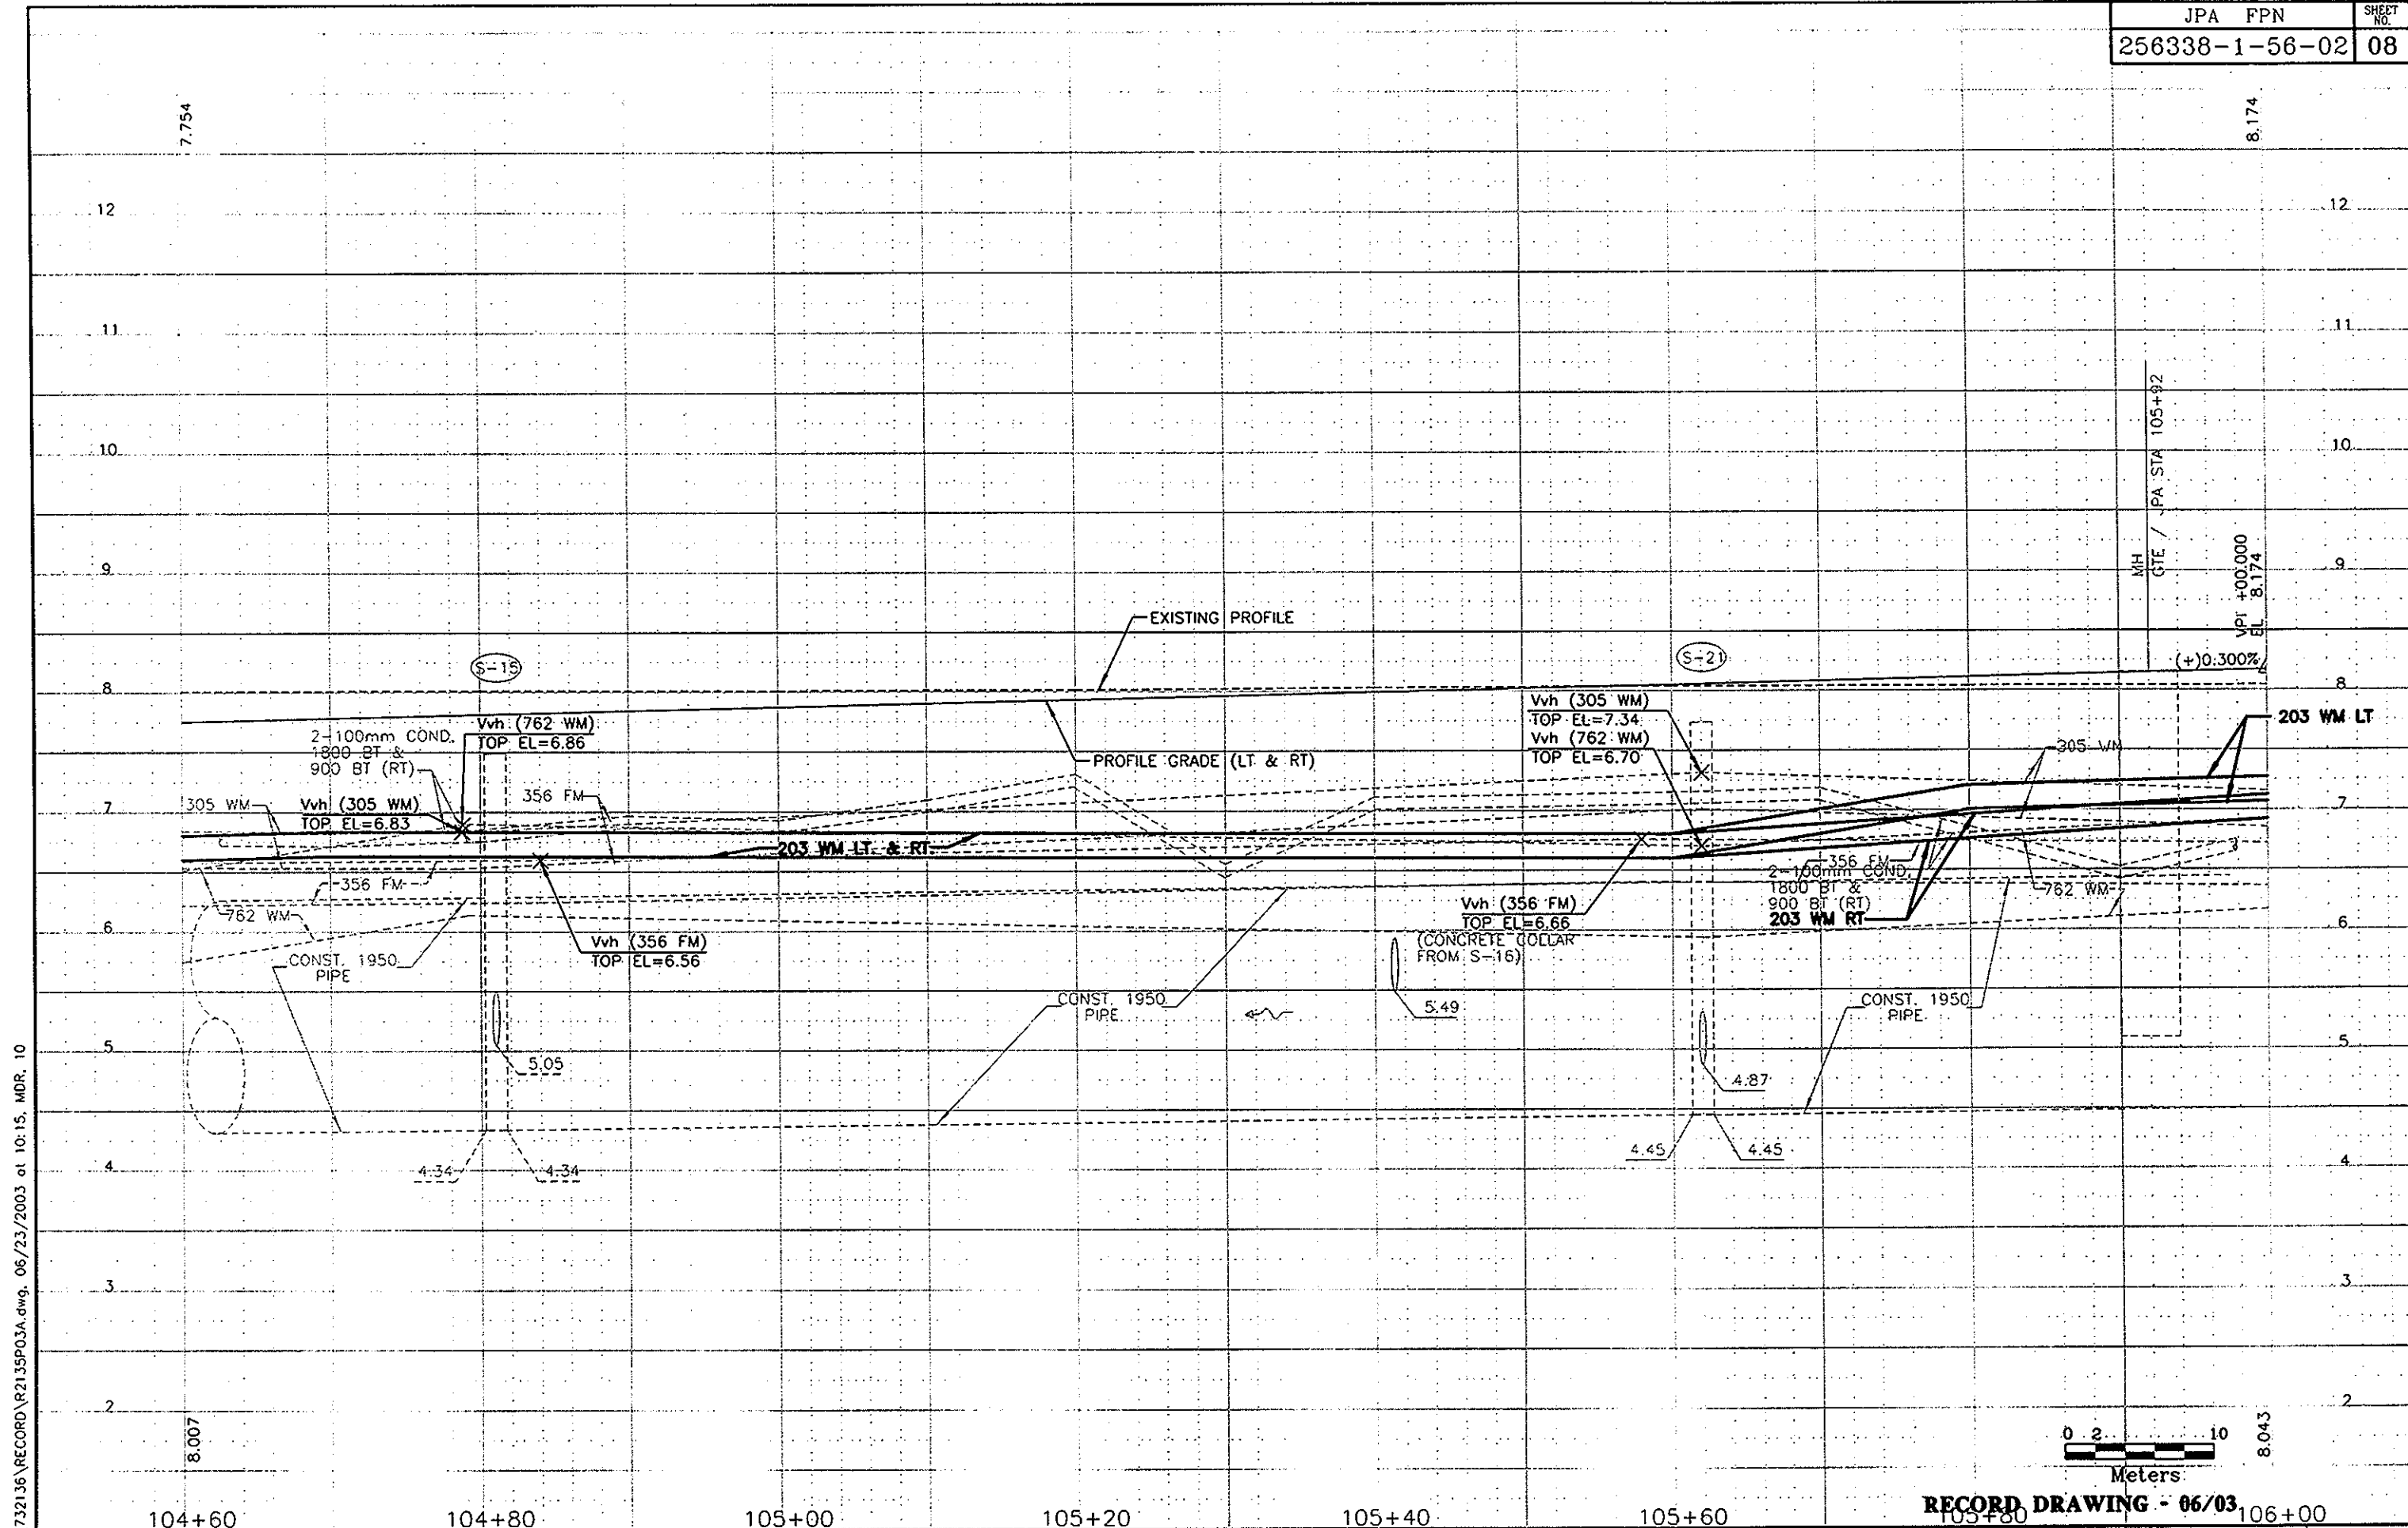


NO. REF. 2. C:\CD\72136\RECORD\82135903A.dwg, 06/23/2003 at 10:15, MDR, 10

REVISIONS				DESIGN				CHECK				APPROVED				PROJECT			
DATE	BY	DESCRIPTION	DATE	NAME	DATE	NAME	DATE	NAME	DATE	NAME	DATE	NAME	DATE	NAME	DATE	NAME	DATE	NAME	DATE
06/03	JSL	RECORD DRAWING (SEE NOTES ON TITLE SHEET)	2/98	J. BURBY	2/98	D. BURNHAM	2/98	F. DESANTO	11/00	J. LOWE	11/00	J. LOWE	11/00	J. LOWE	11/00	J. LOWE	11/00	J. LOWE	11/00
11/00	JSL	RELEASED FOR BIDDING/CONSTRUCTION																	

PASCO COUNTY UTILITIES CONSTRUCTION
7250 LITTLE ROAD
NEW PORT RICHEY, FLORIDA 34654

STATE ROAD NO. 64 - US 19 TO MADISON
WATER & FORCE MAIN UTILITY ADJUSTMENTS
PROFILE SHEET - STA 104+60 TO STA 106+00

SHEET NO. P-3A

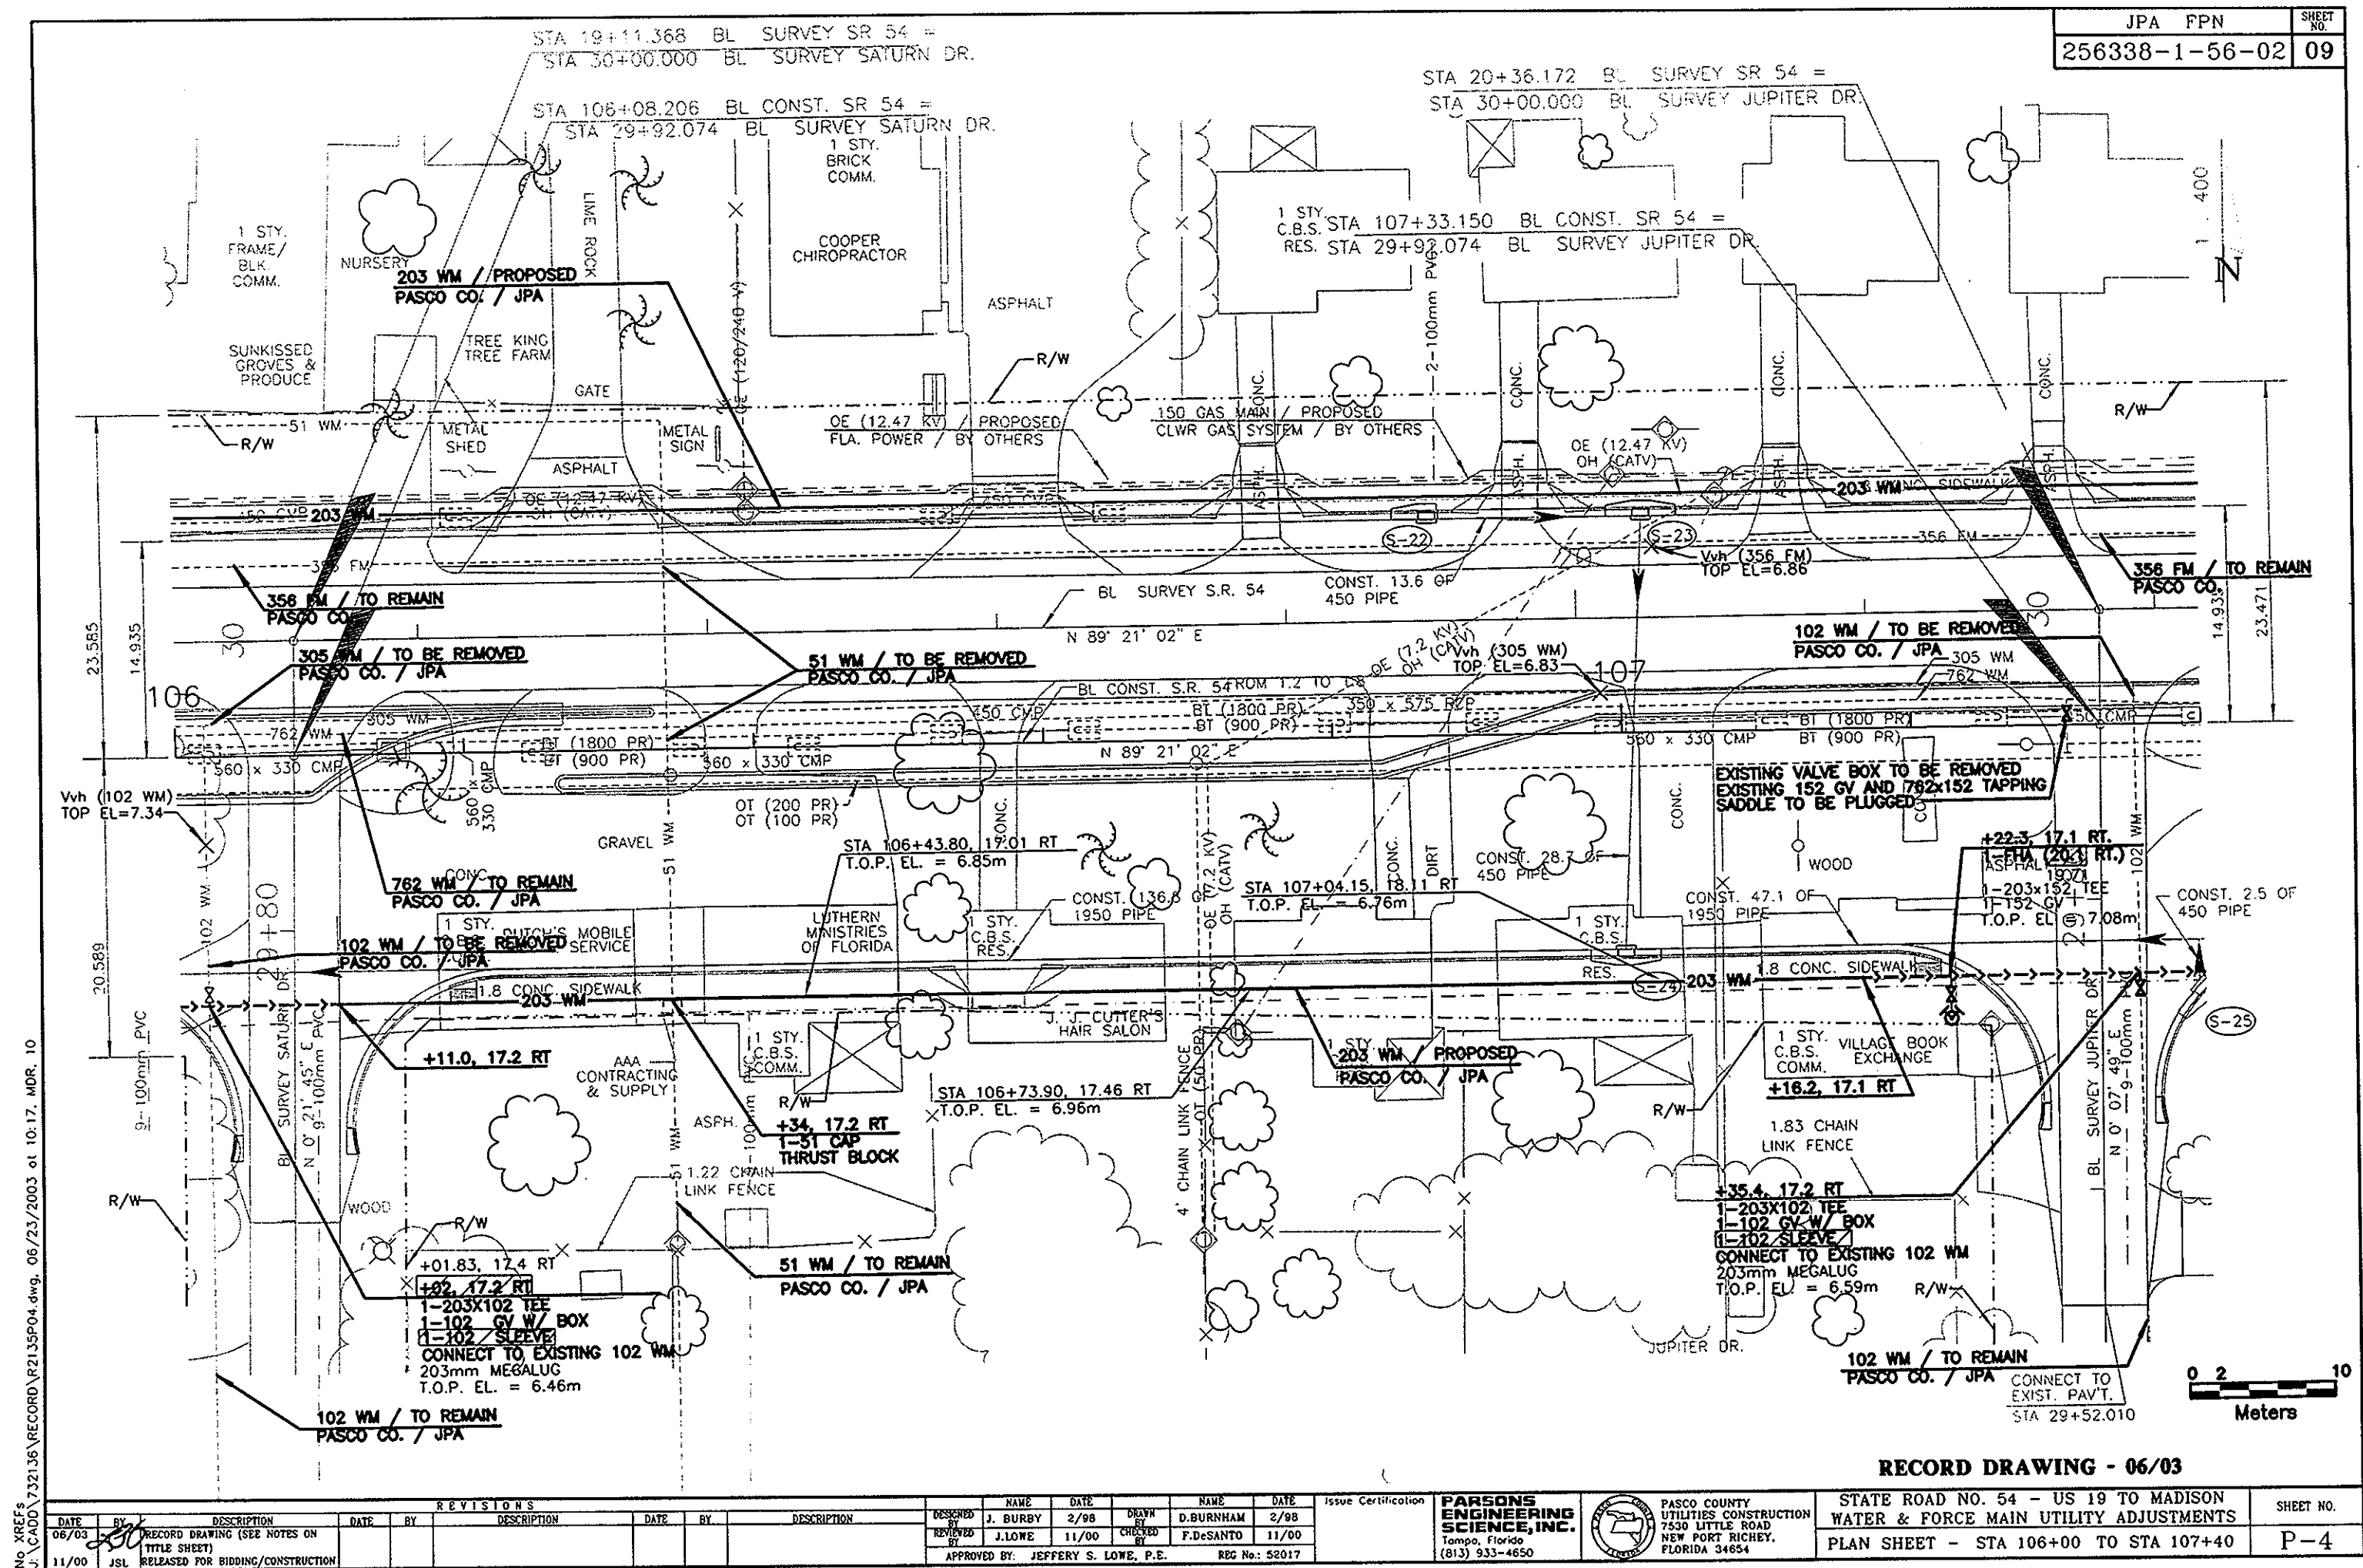

JPA FPN
256338-1-56-02
SHEET NO. 09


RECORD DRAWING - 06/03

REVISIONS				REVISIONS				REVISIONS			
DATE	BY	DESCRIPTION	DATE	BY	DESCRIPTION	DATE	BY	DESCRIPTION	DATE	BY	DESCRIPTION
06/03	JSL	RECORD DRAWING (SEE NOTES ON TITLE SHEET)									
11/00	JSL	RELEASED FOR BIDDING/CONSTRUCTION									

DESIGNED BY J. BURBY 2/98	DRAWN BY D. BURNHAM 2/98	CHECKED BY J. LOWE 11/00	APPROVED BY JEFFERY S. LOWE, P.E. REG No: 52017
---------------------------------	--------------------------------	--------------------------------	---


PARSONS ENGINEERING SCIENCE, INC. 7530 LITTLE ROAD NEW PORT RICHEY, FLORIDA 34654 (813) 933-4650	PASCO COUNTY UTILITIES CONSTRUCTION 7530 LITTLE ROAD NEW PORT RICHEY, FLORIDA 34654
---	---

STATE ROAD NO. 54 - US 19 TO MADISON WATER & FORCE MAIN UTILITY ADJUSTMENTS PLAN SHEET - STA 106+00 TO STA 107+40	SHEET NO. P-4
---	------------------

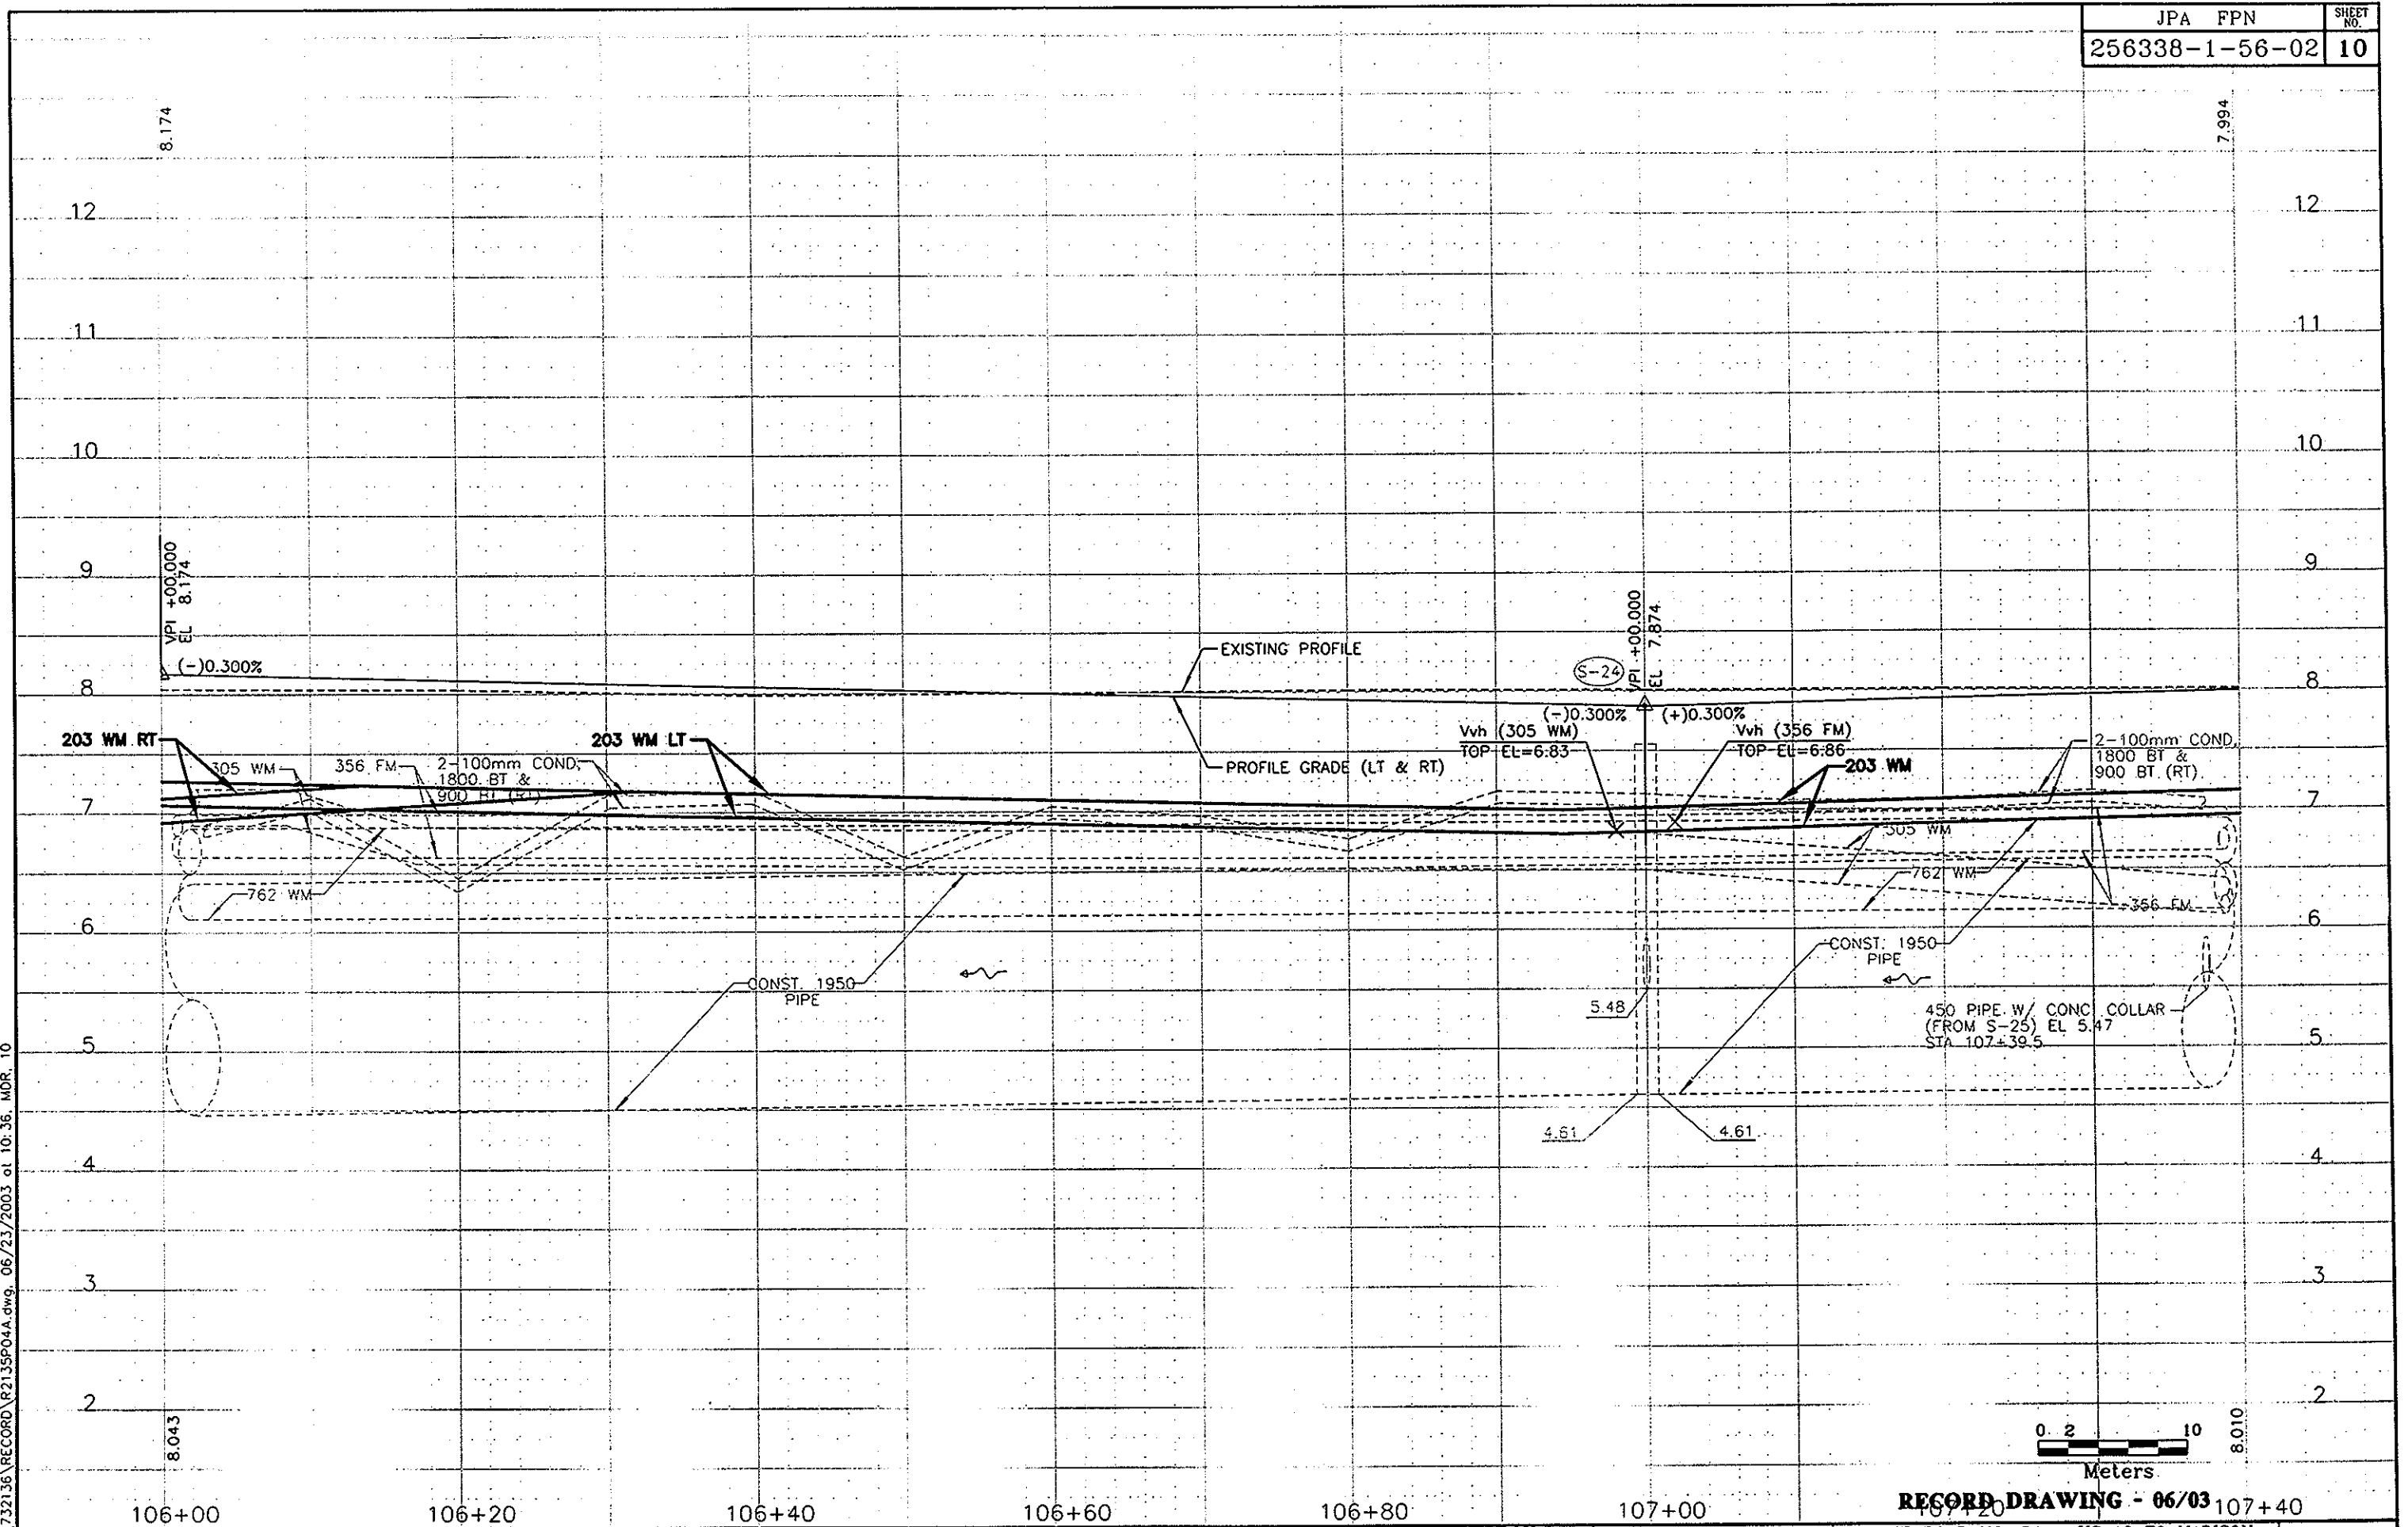

NO. VREFS
J:\CADD\732136\RECORD\215P04A.dwg, 06/23/2003, 01:10:35, MDR, 10

DATE: 06/03 BY: JSL DESCRIPTION: RECORD DRAWING (SEE NOTES ON TITLE SHEET) RELEASED FOR BIDDING/CONSTRUCTION				DATE: 11/00 BY: JSL DESCRIPTION: REVISED FOR BIDDING/CONSTRUCTION				DATE: 11/00 BY: JSL DESCRIPTION: REVISED FOR BIDDING/CONSTRUCTION			
DESIGNED BY: J. BURBY DATE: 2/98				CHECKED BY: D. BURNHAM DATE: 2/98				APPROVED BY: JEFFERY S. LOWE, P.E. REG. NO.: 52017			
REVIEWED BY: J. LOWE DATE: 11/00				CHECKED BY: F. DeSANTO DATE: 11/00				PARSONS ENGINEERING SCIENCE, INC. TAMPA, FLORIDA (813) 933-4550			
PASCO COUNTY UTILITIES CONSTRUCTION 7530 LITTLE ROAD NEW PORT RICHEY, FLORIDA 34654				STATE ROAD NO. 54 - US 19 TO MADISON WATER & FORCE MAIN UTILITY ADJUSTMENTS				PROFILE SHEET - STA 106+00 TO STA 107+40			
SHEET NO.				P-4A				Issue Certification			

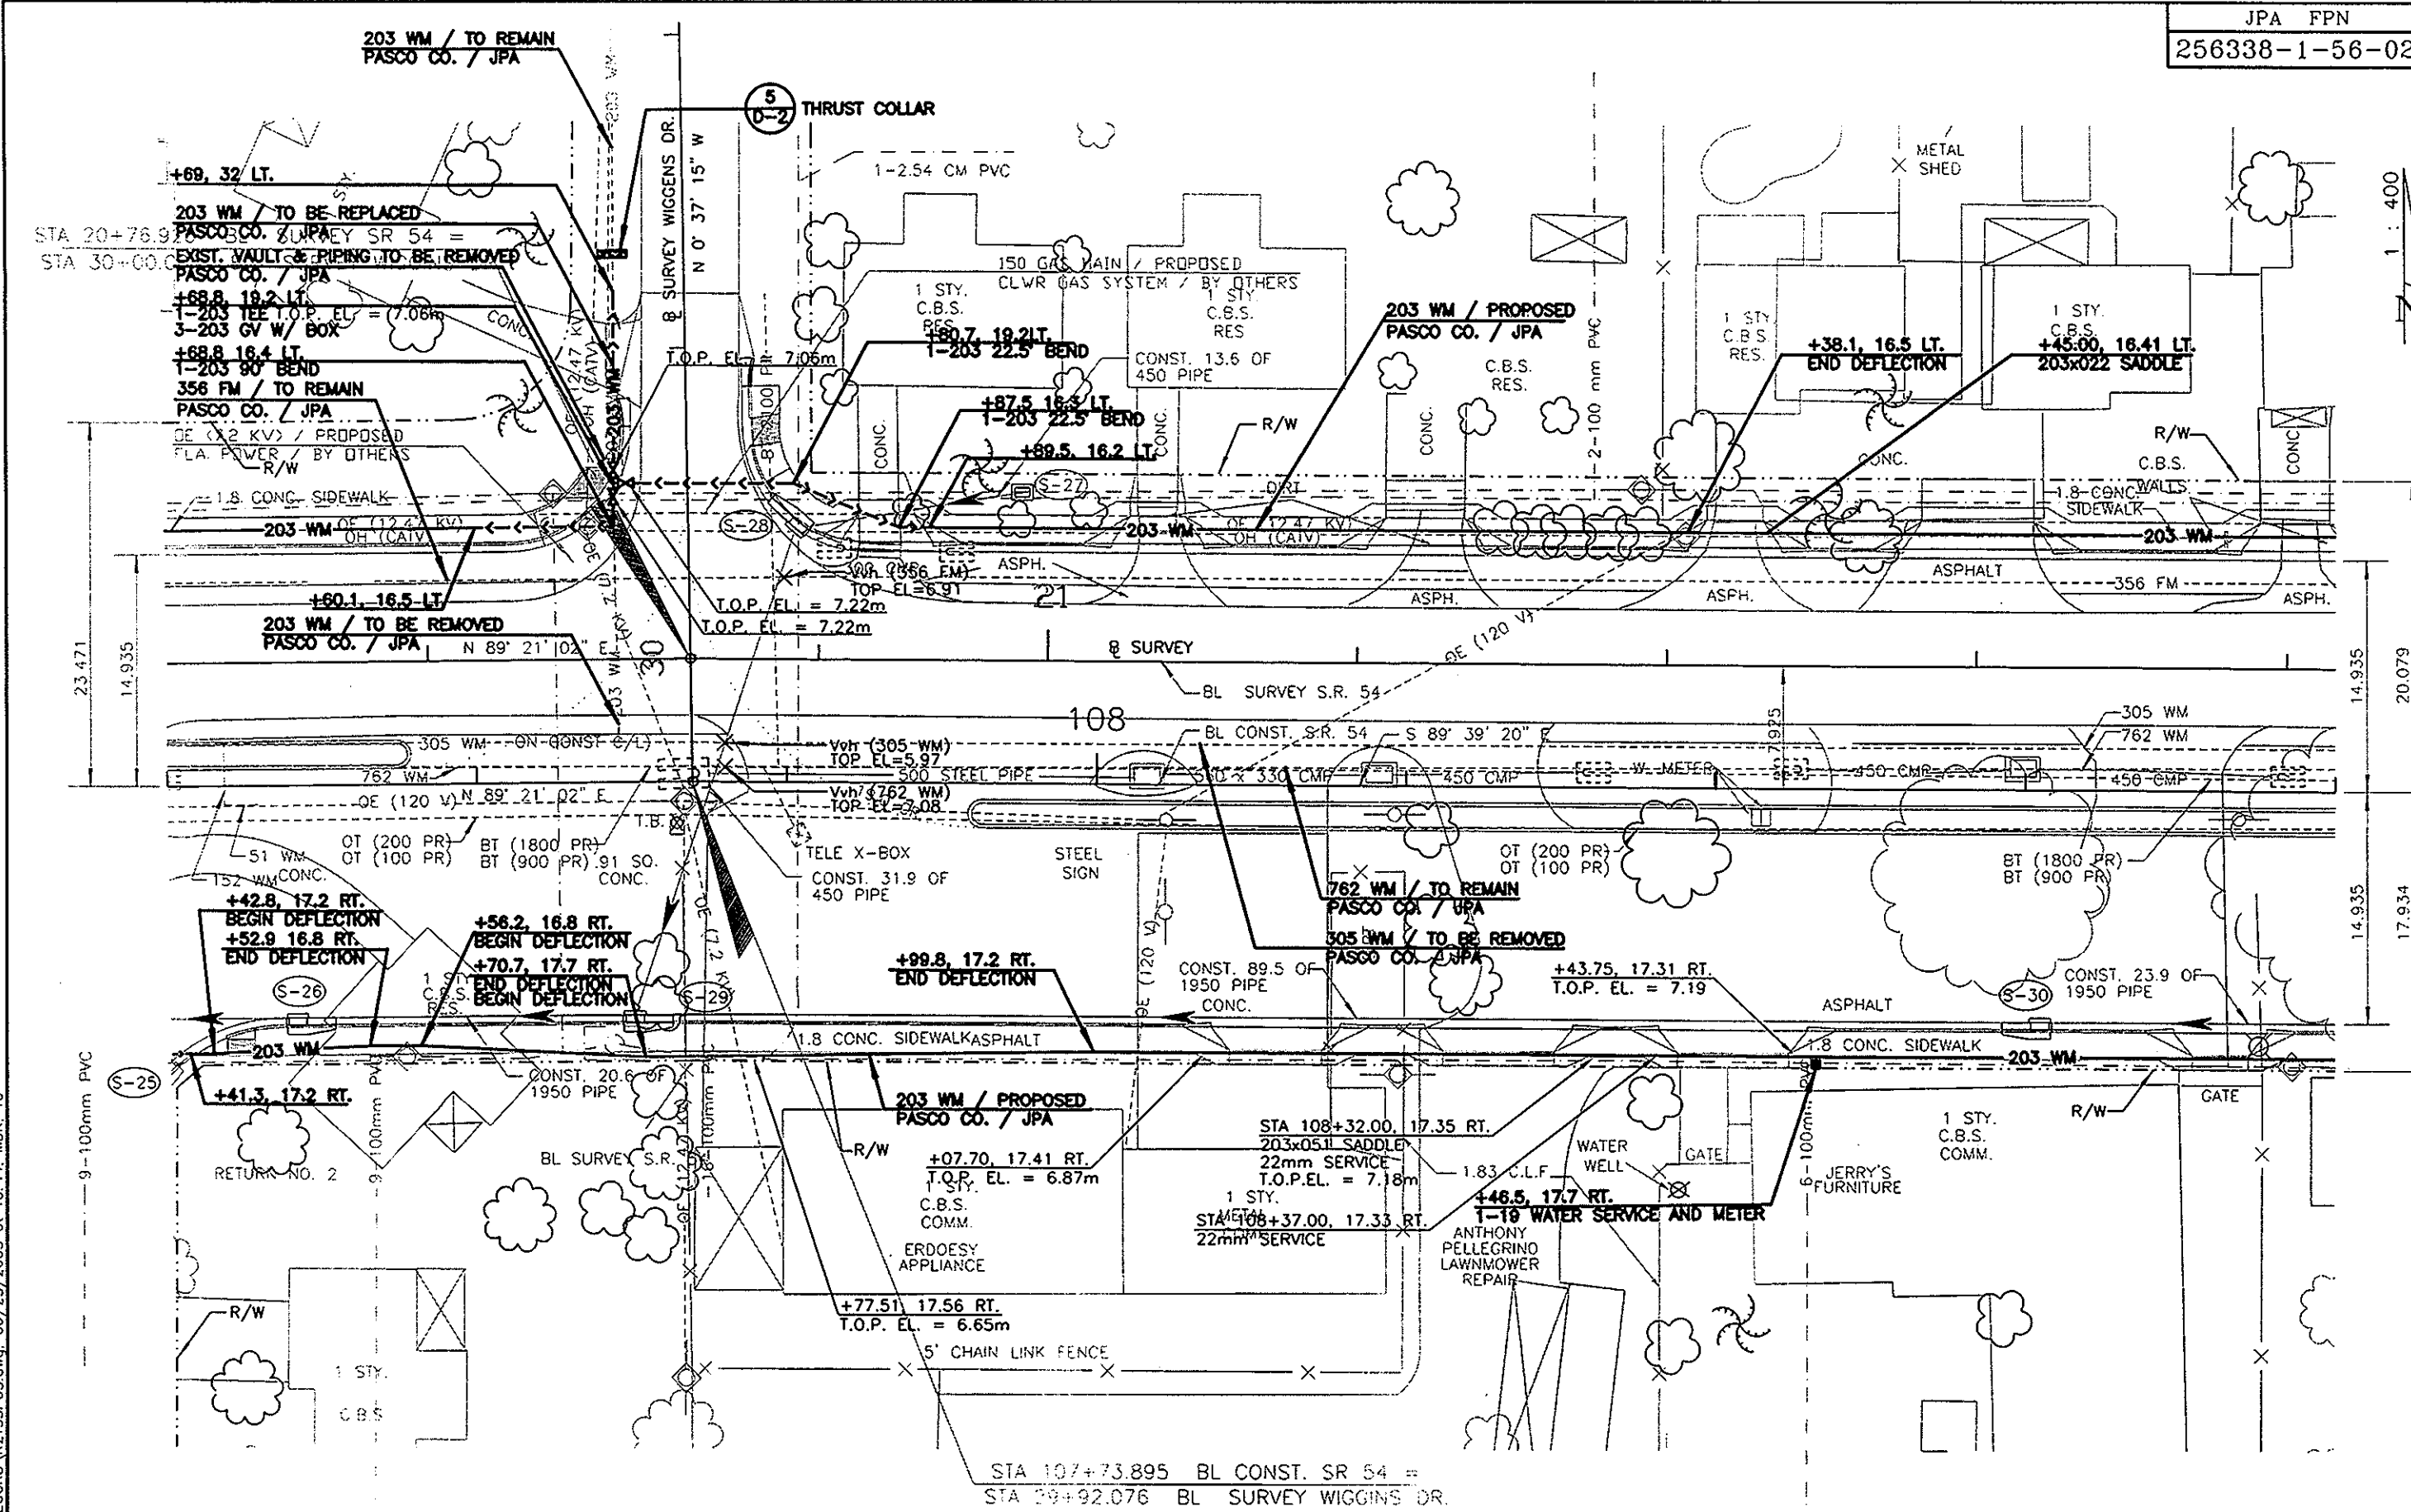

RECORD DRAWING - 06/03

NO. XFEES

BY: J. CADY

REVISIONS						NAME		DATE		Issue Certification	
DATE	BY	DESCRIPTION	DATE	BY	DESCRIPTION	DATE	BY	DESCRIPTION			
06/03	JSL	RECORD DRAWING (SEE NOTES ON TITLE SHEET)				DESIGNED	J. BURBY	2/98	DRAWN	D. BURNHAM	2/98
						REVISED	J. LOWE	11/00	CHECKED	P. DESANTO	11/00
11/00	JSL	RELEASED FOR BIDDING/CONSTRUCTION				APPROVED BY: JEFFERY S. LOWE, P.E.		REG NO:		52017	

SHEET NO.

PARSONS ENGINEERING & SCIENCE, INC.

7530 LITTLE ROCK

TEMPE, ARIZONA

(602) 933-4650

PASCO COUNTY UTILITIES CONSTRUCTION

7530 LITTLE ROCK

TEMPE, ARIZONA

(602) 933-4650


STATE ROAD NO. 54 - US 19 TO MADISON

WATER & FORCE MAIN UTILITY ADJUSTMENTS


PLAN SHEET - STA 107+40 TO STA 108+80

SHEET NO.

P-5

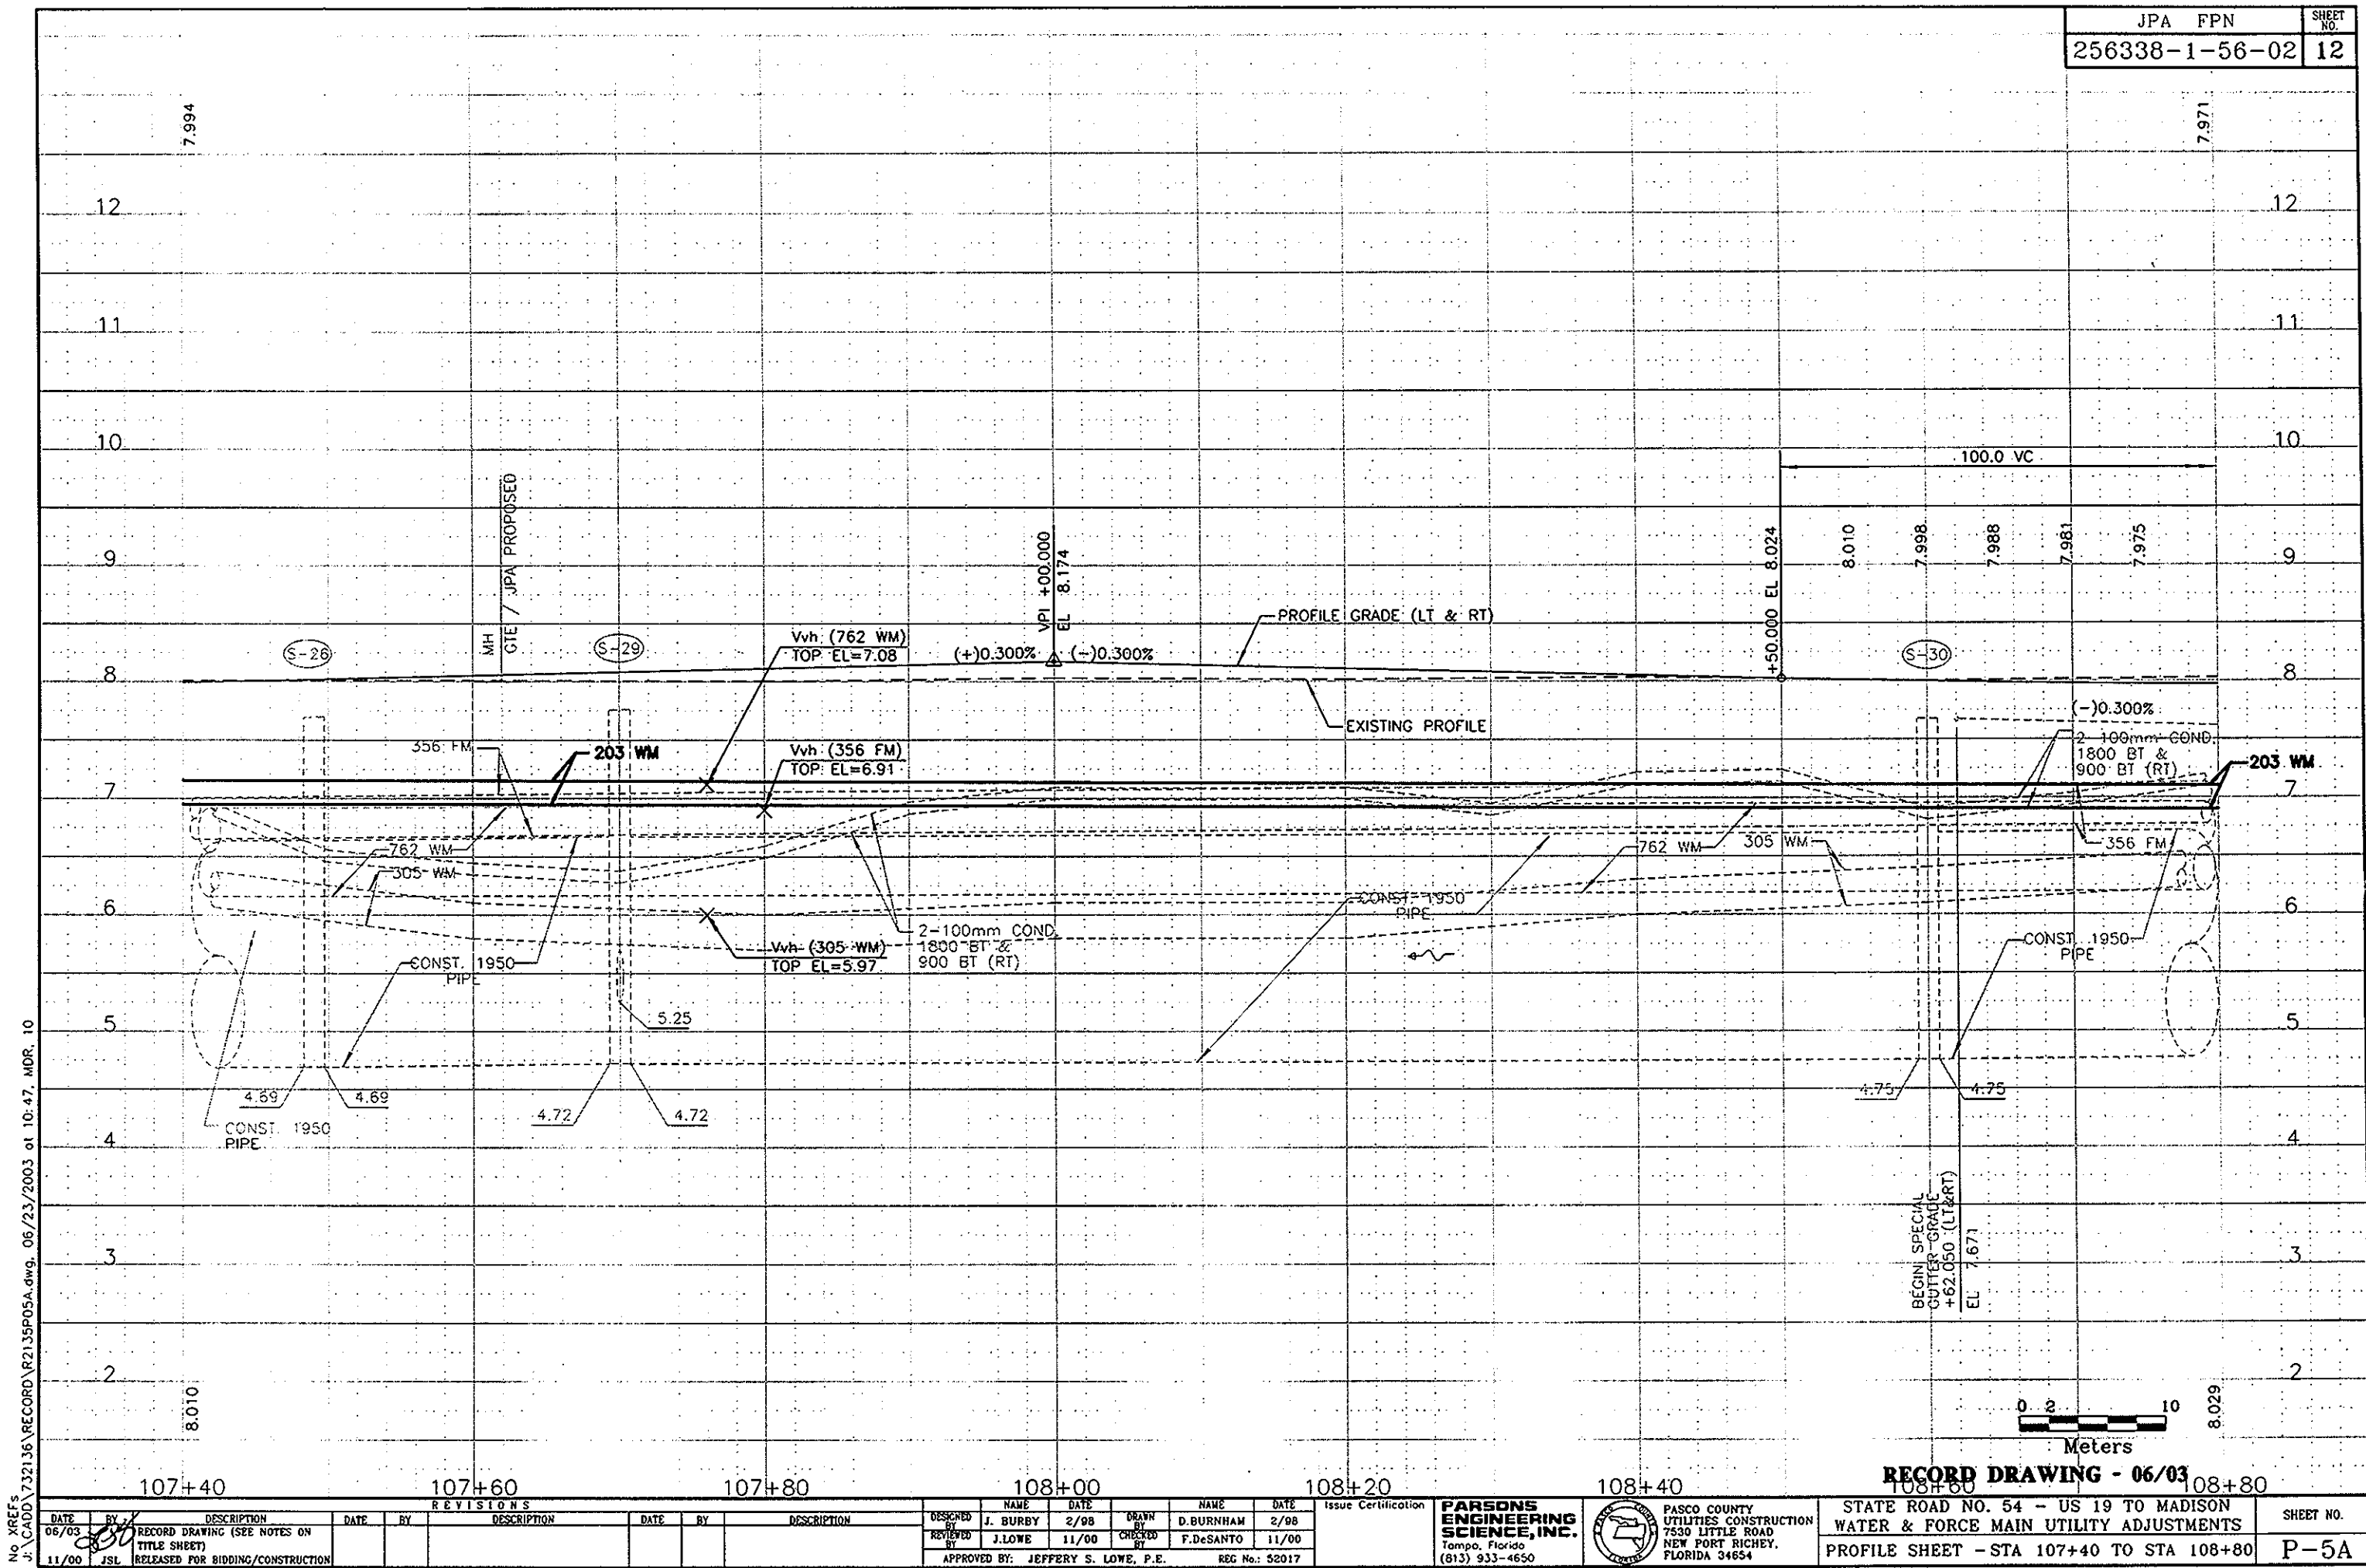

STA 22+45.554 BL SURVEY SR 54 =
STA 30+00.000 BL SURVEY PECAN DR

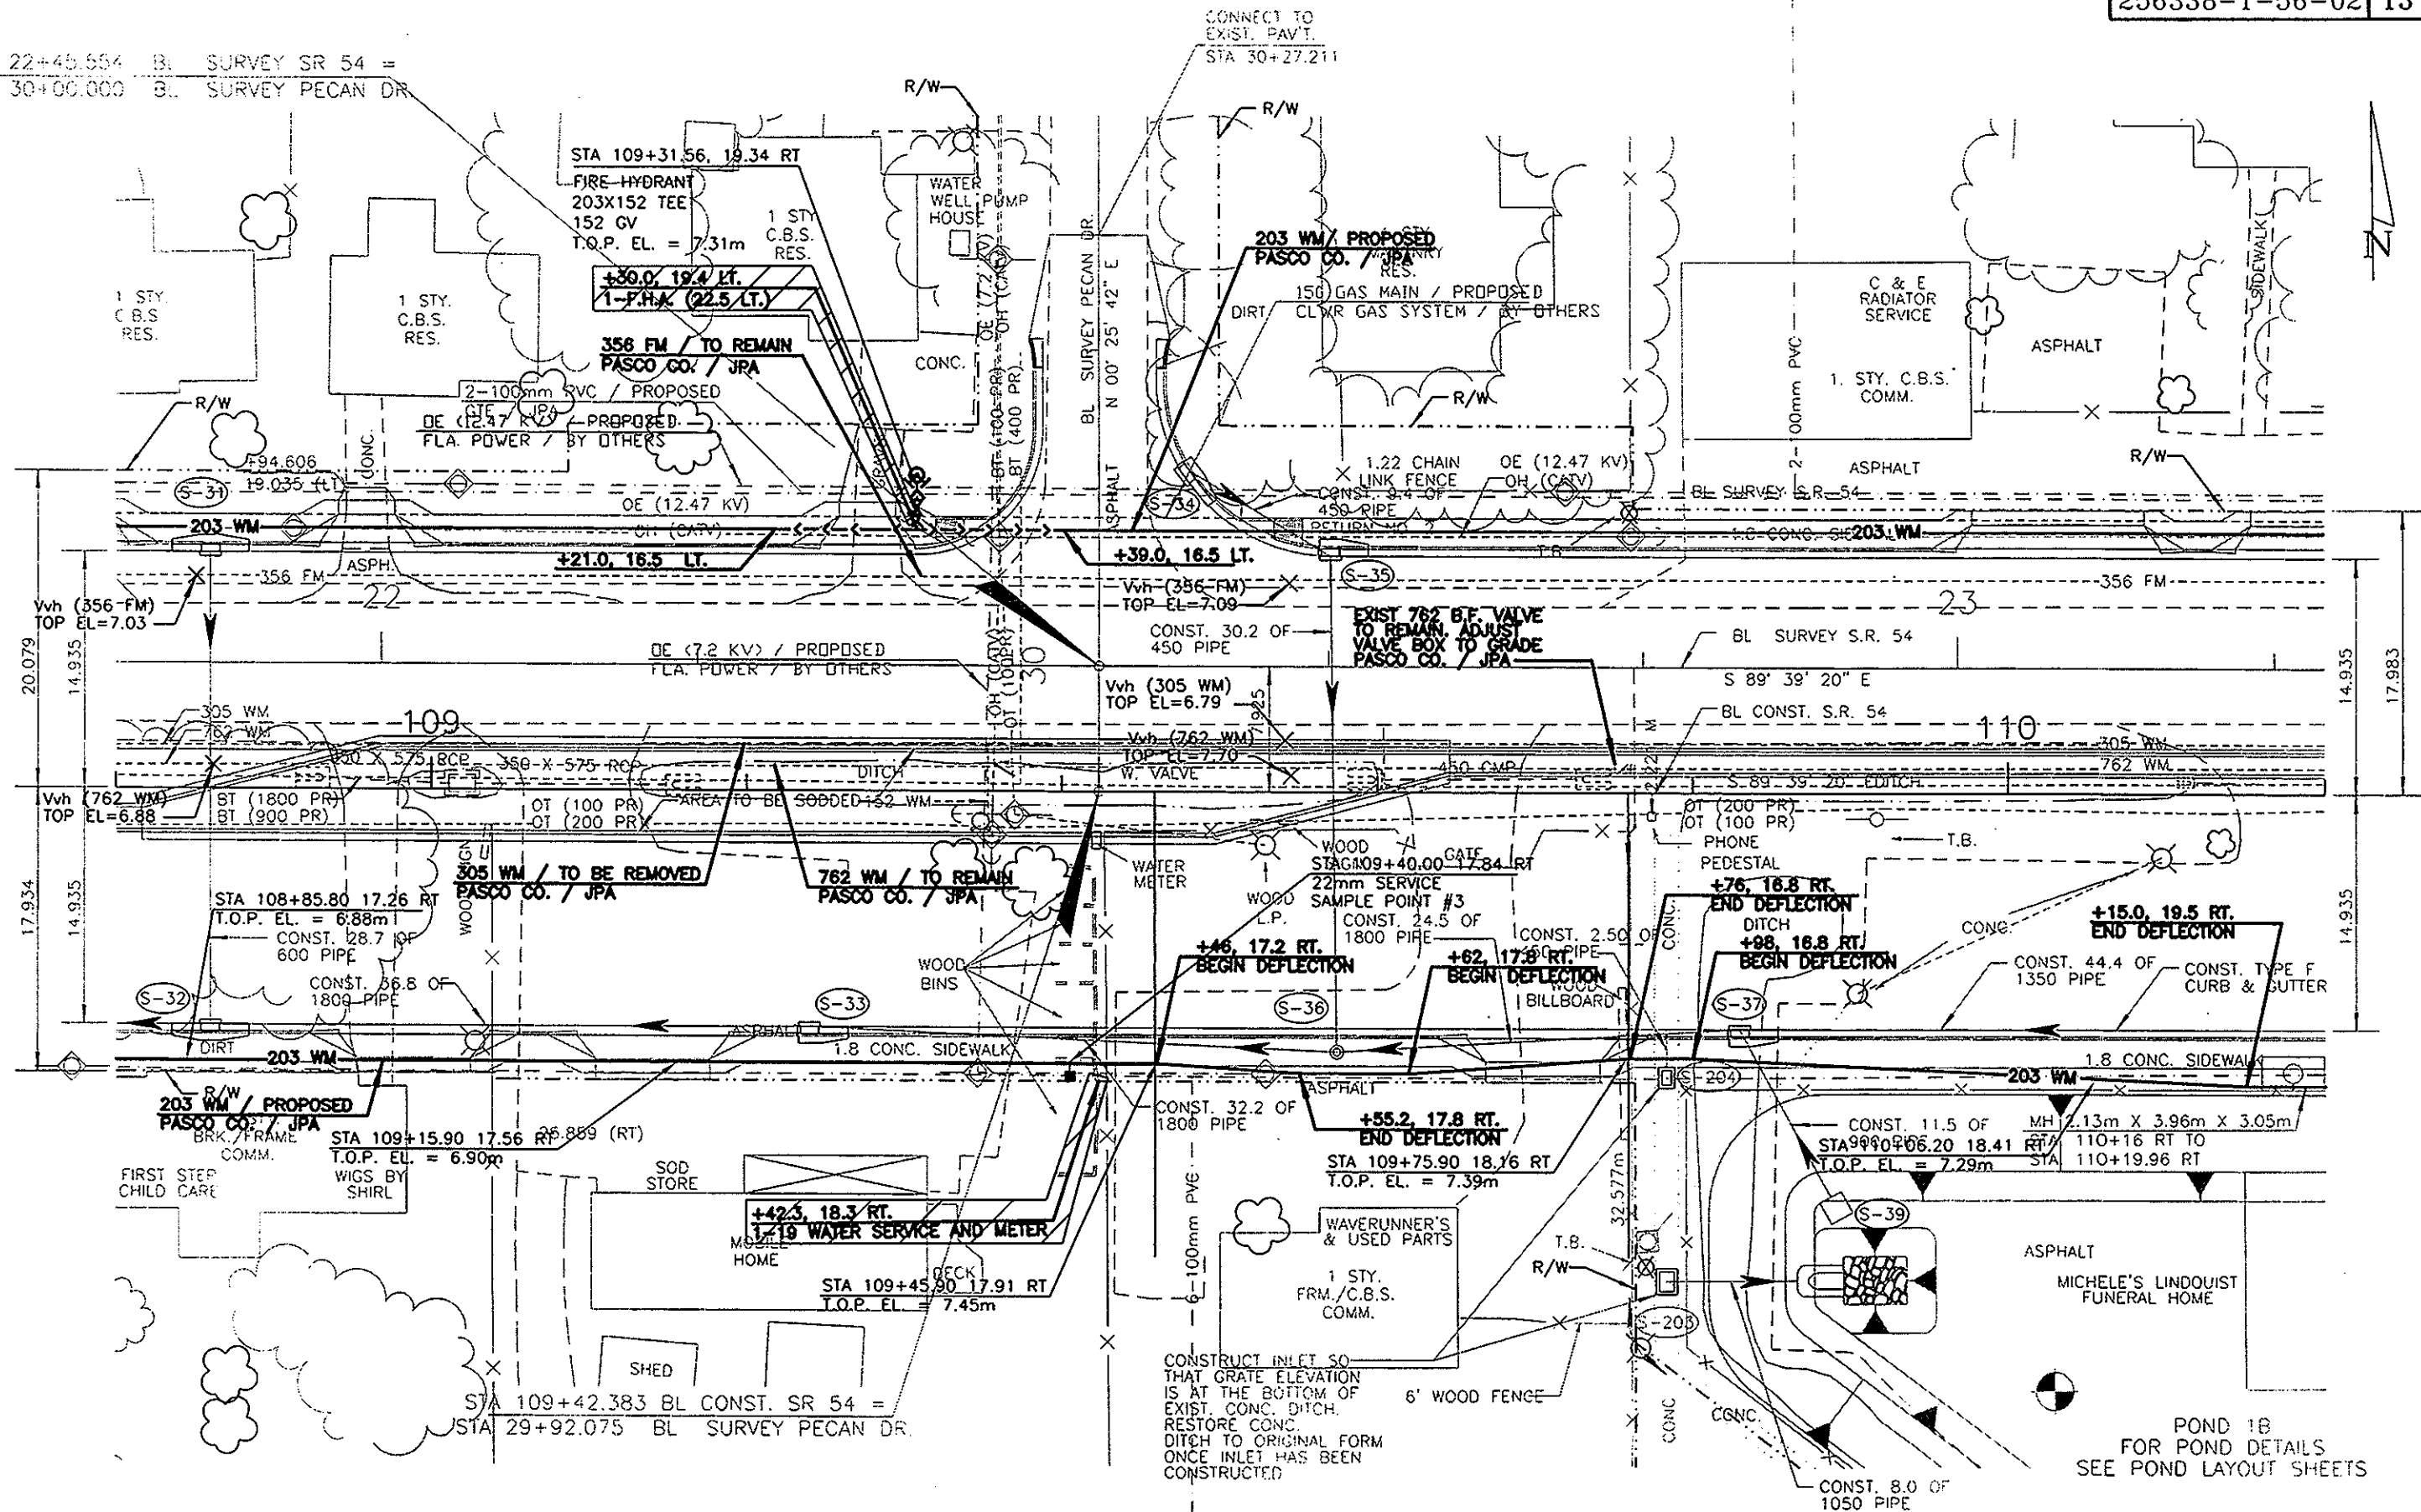

RECORD DRAWING - 06/03

NO. 11/00 JSE RELEASED FOR BIDDING/CONSTRUCTION

DATE	BY	DESCRIPTION	DATE	BY	DESCRIPTION
06/03	JSE	RECORD DRAWING (SEE NOTES ON TITLE SHEET)			
11/00	JSE	RELEASED FOR BIDDING/CONSTRUCTION			

NAME	DATE	NAME	DATE
J. BURBY	2/98	D. BURHAM	2/98
J. LOWE	11/00	F. DESANTO	11/00

APPROVED BY JEFFERY S. LOWE, P.E.
REC No. 52017


PARSONS
ENGINEERING
SCIENCE, INC.
Tampa, Florida
(813) 933-4650




PASCO COUNTY
UTILITIES CONSTRUCTION
7530 LITTLE ROAD
NEW PORT RICHEY,
FLORIDA 34654

STATE ROAD NO. 54 - US 19 TO MADISON
WATER & FORCE MAIN UTILITY ADJUSTMENTS
PLAN SHEET - STA 108+80 TO STA 110+20

SHEET NO.
P-6

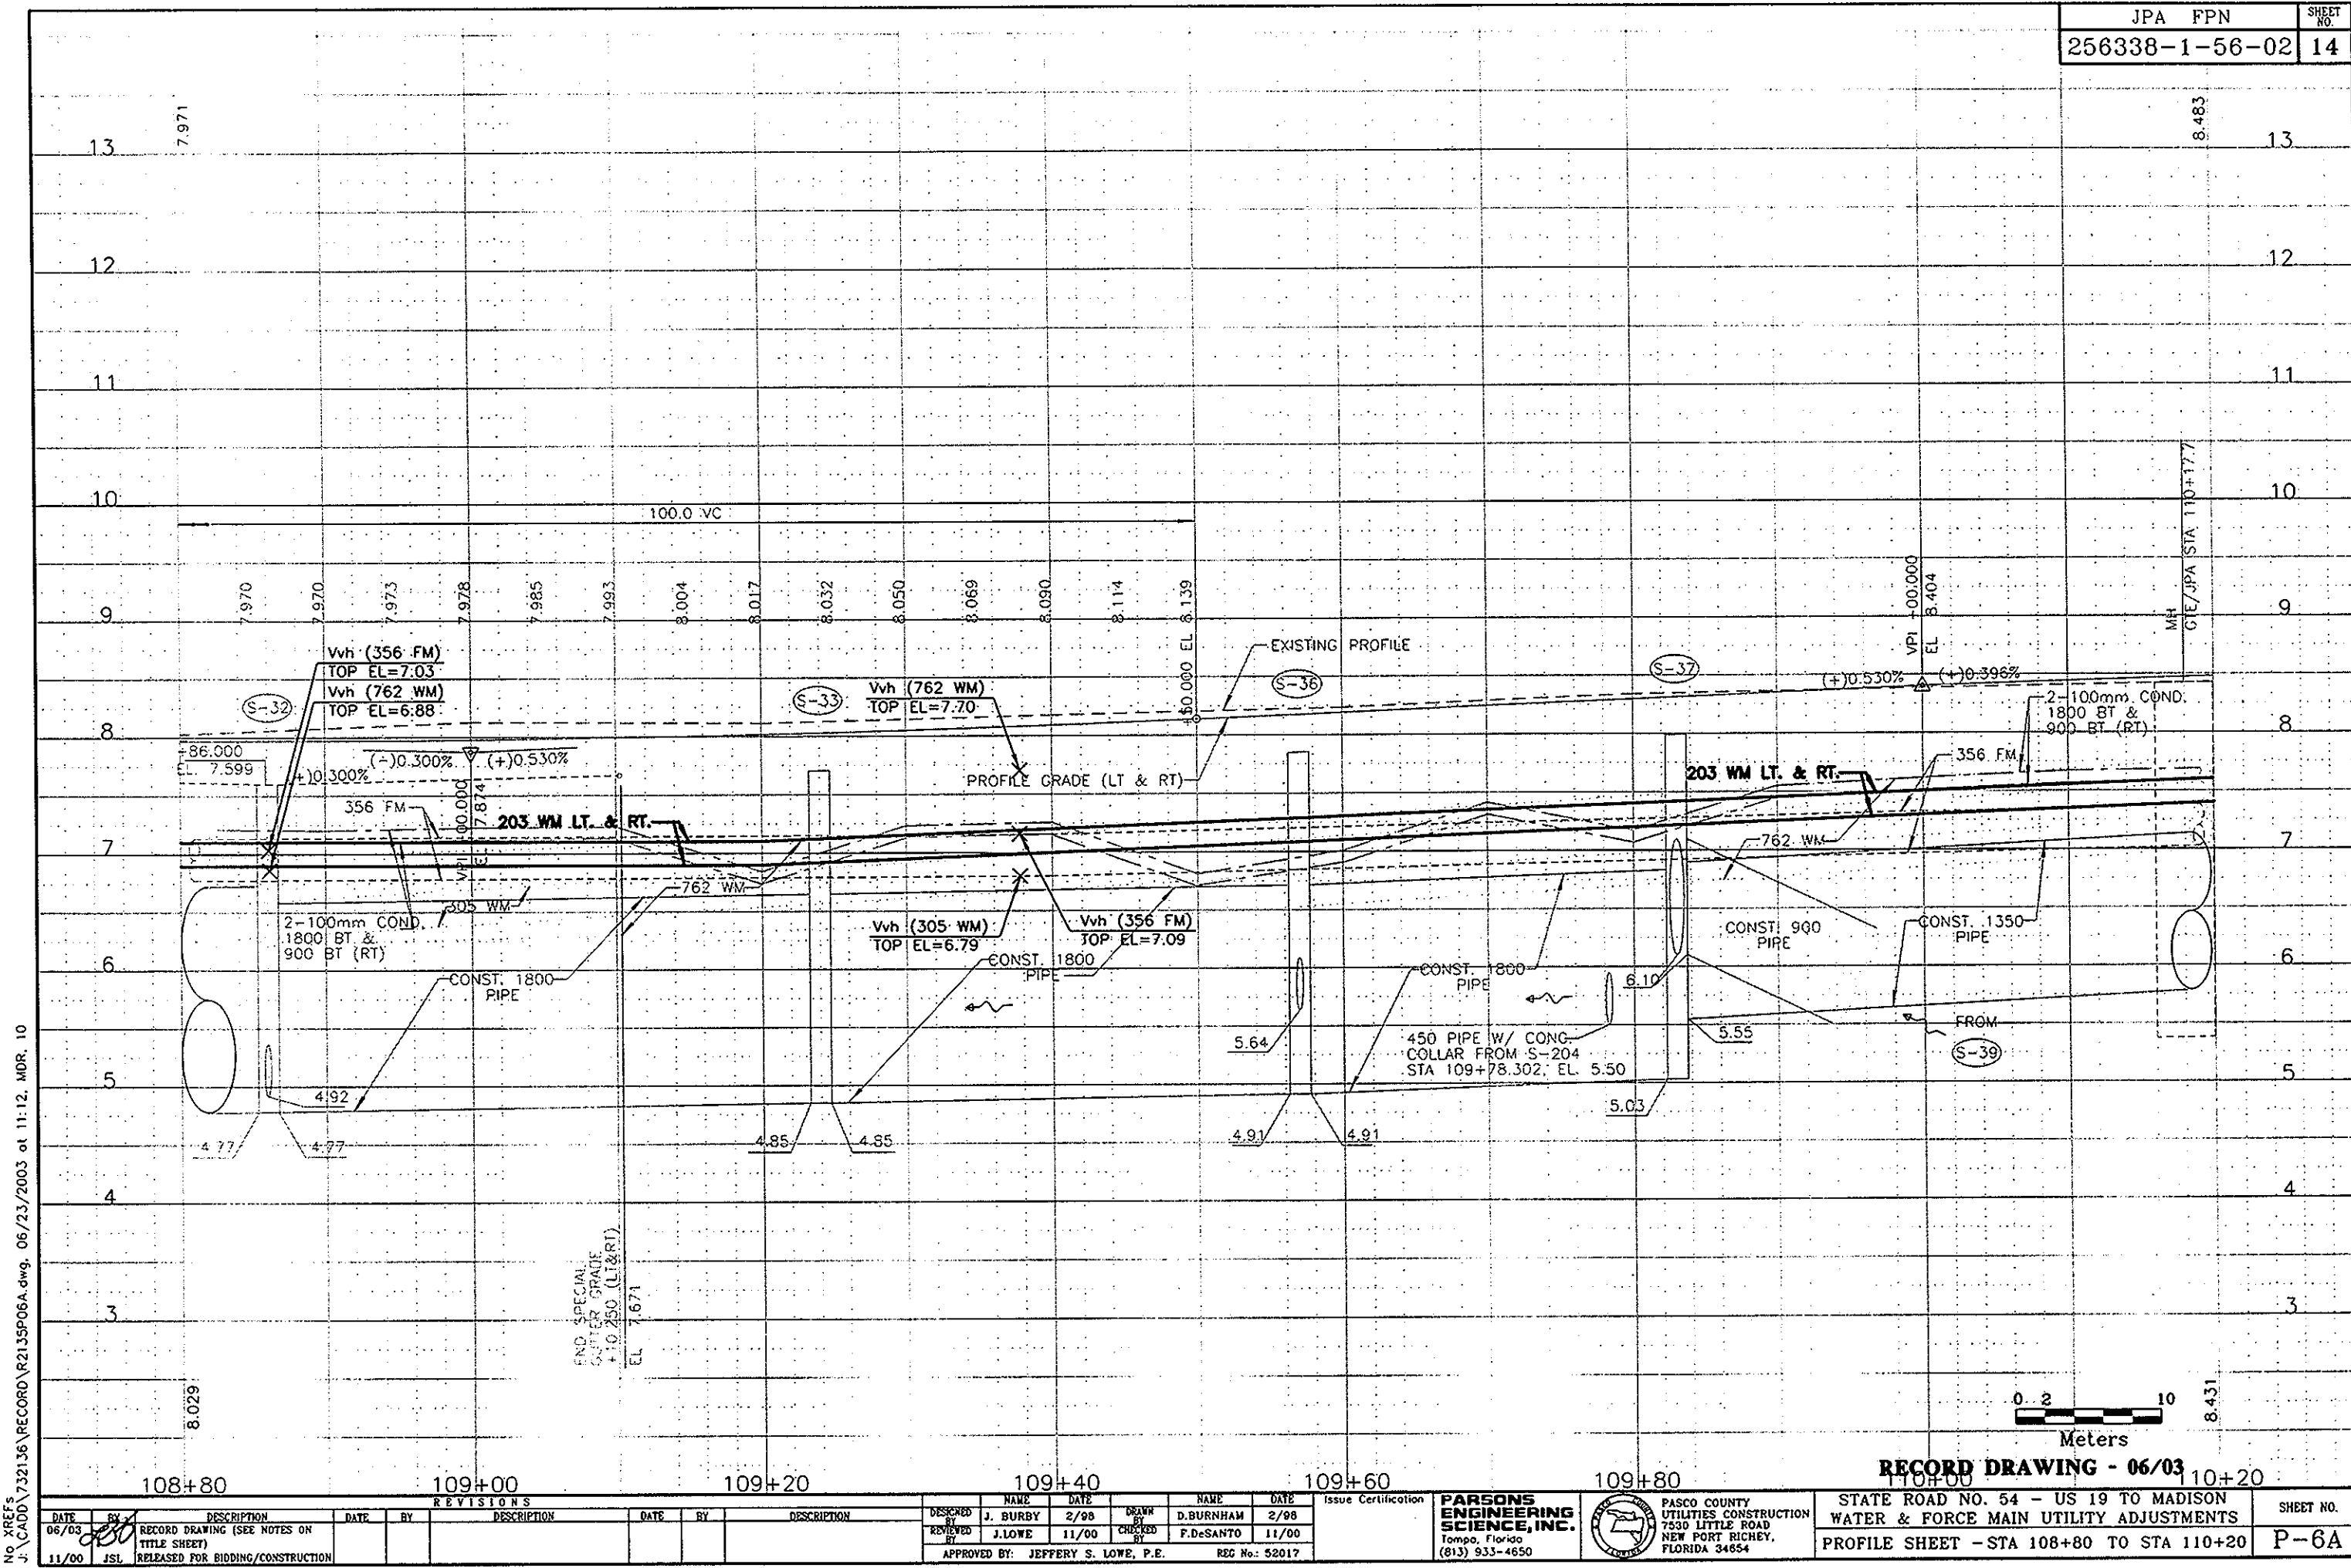

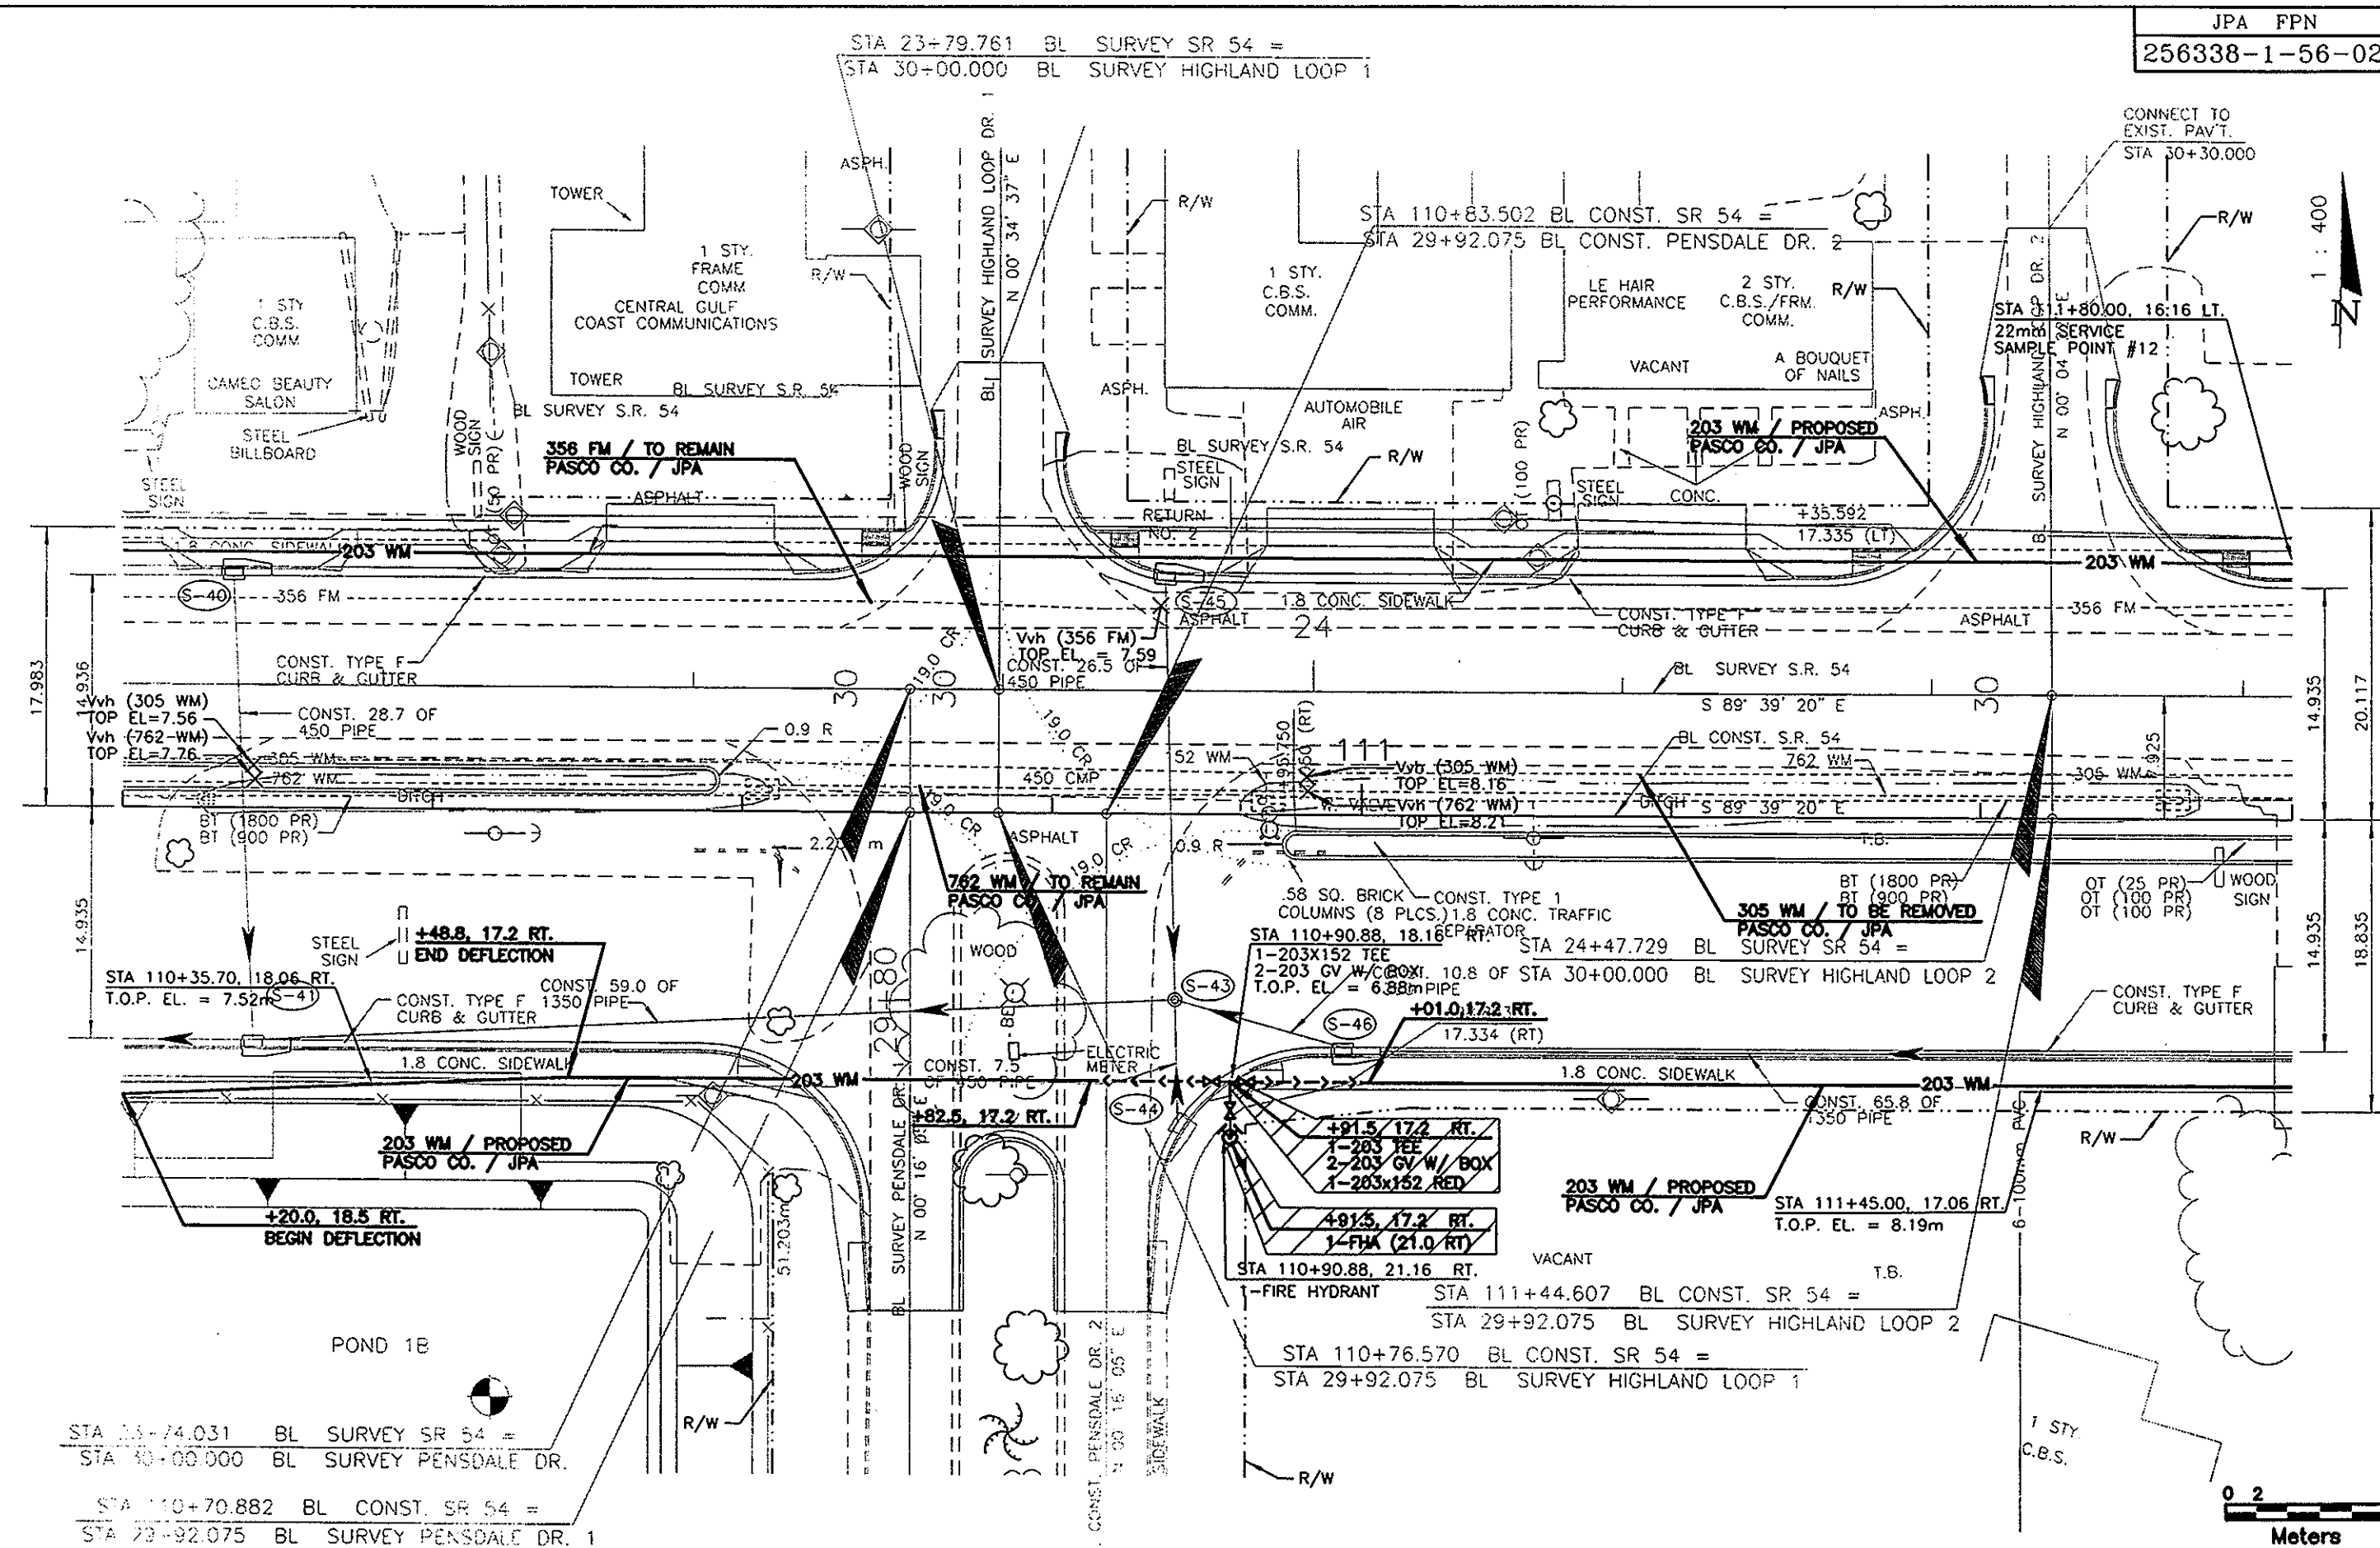

RECORD DRAWING - 06/03

REVISIONS										Issue Certification		PARSONS ENGINEERING SCIENCE, INC.		PASCO COUNTY UTILITIES CONSTRUCTION		STATE ROAD NO. 54 - US 19 TO MADISON WATER & FORCE MAIN UTILITY ADJUSTMENTS		SHEET NO.	
DATE	BY	DESCRIPTION	DATE	BY	DESCRIPTION	DATE	BY	DESCRIPTION	DATE	BY	DESCRIPTION	NAME	DATE	NAME	DATE	NAME	DATE	NAME	DATE
05/03	JL	RECORD DRAWING (SEE NOTES ON TITLE SHEET)										J. BURBY	2/88	DRAWN	D. BURNHAM	2/88			
11/00	JSL	RELEASED FOR BIDDING/CONSTRUCTION										J. LOWE	11/00	CHECKED	F. DeSANTO	11/00			
APPROVED BY: JEFFERY S. LOWE, P.E.										RSG NO: 52017									

8.483

9.180

13

13

12

12

11

11

10

10

9

9

8

8

7

7

6

6

5

5

4

4

3

3

8.431

9.098



RECORD DRAWING - 06/03

110+20 110+40 110+60 110+80 111+00 111+20 111+40 111+60

NO. 18655
J:\CADD\732136\RECORD\213SP07A.dwg, 06/23/2003 at 11:17, MDR, 10

DATE BY DESCRIPTION
06/03 JSL RELEASED FOR BIDDING/CONSTRUCTION

DATE	BY	DESCRIPTION	DATE	BY	DESCRIPTION	DATE	BY	DESCRIPTION
06/03	JSL	RELEASED FOR BIDDING/CONSTRUCTION						

DATE	BY	DESCRIPTION	DATE	BY	DESCRIPTION	DATE	BY	DESCRIPTION
06/03	J. BURBY	DESIGNED	2/98	D. BURNHAM	2/98			
11/00	J. LOWE	REVIEWED	11/00	F. DeSANTO	11/00			
11/00	JSL	APPROVED BY: JEFFERY S. LOWE, P.E.						


PARSONS
ENGINEERING
SCIENCE, INC.
Tampa, Florida
(813) 933-4650



PASCO COUNTY
UTILITIES CONSTRUCTION
7530 LITTLE ROAD
NEW PORT RICHEY,
FLORIDA 34654

STATE ROAD NO. 54 - US 19 TO MADISON
WATER & FORCE MAIN UTILITY ADJUSTMENTS
PROFILE SHEET - STA 110+20 TO STA 111+60

SHEET NO.
P-7A

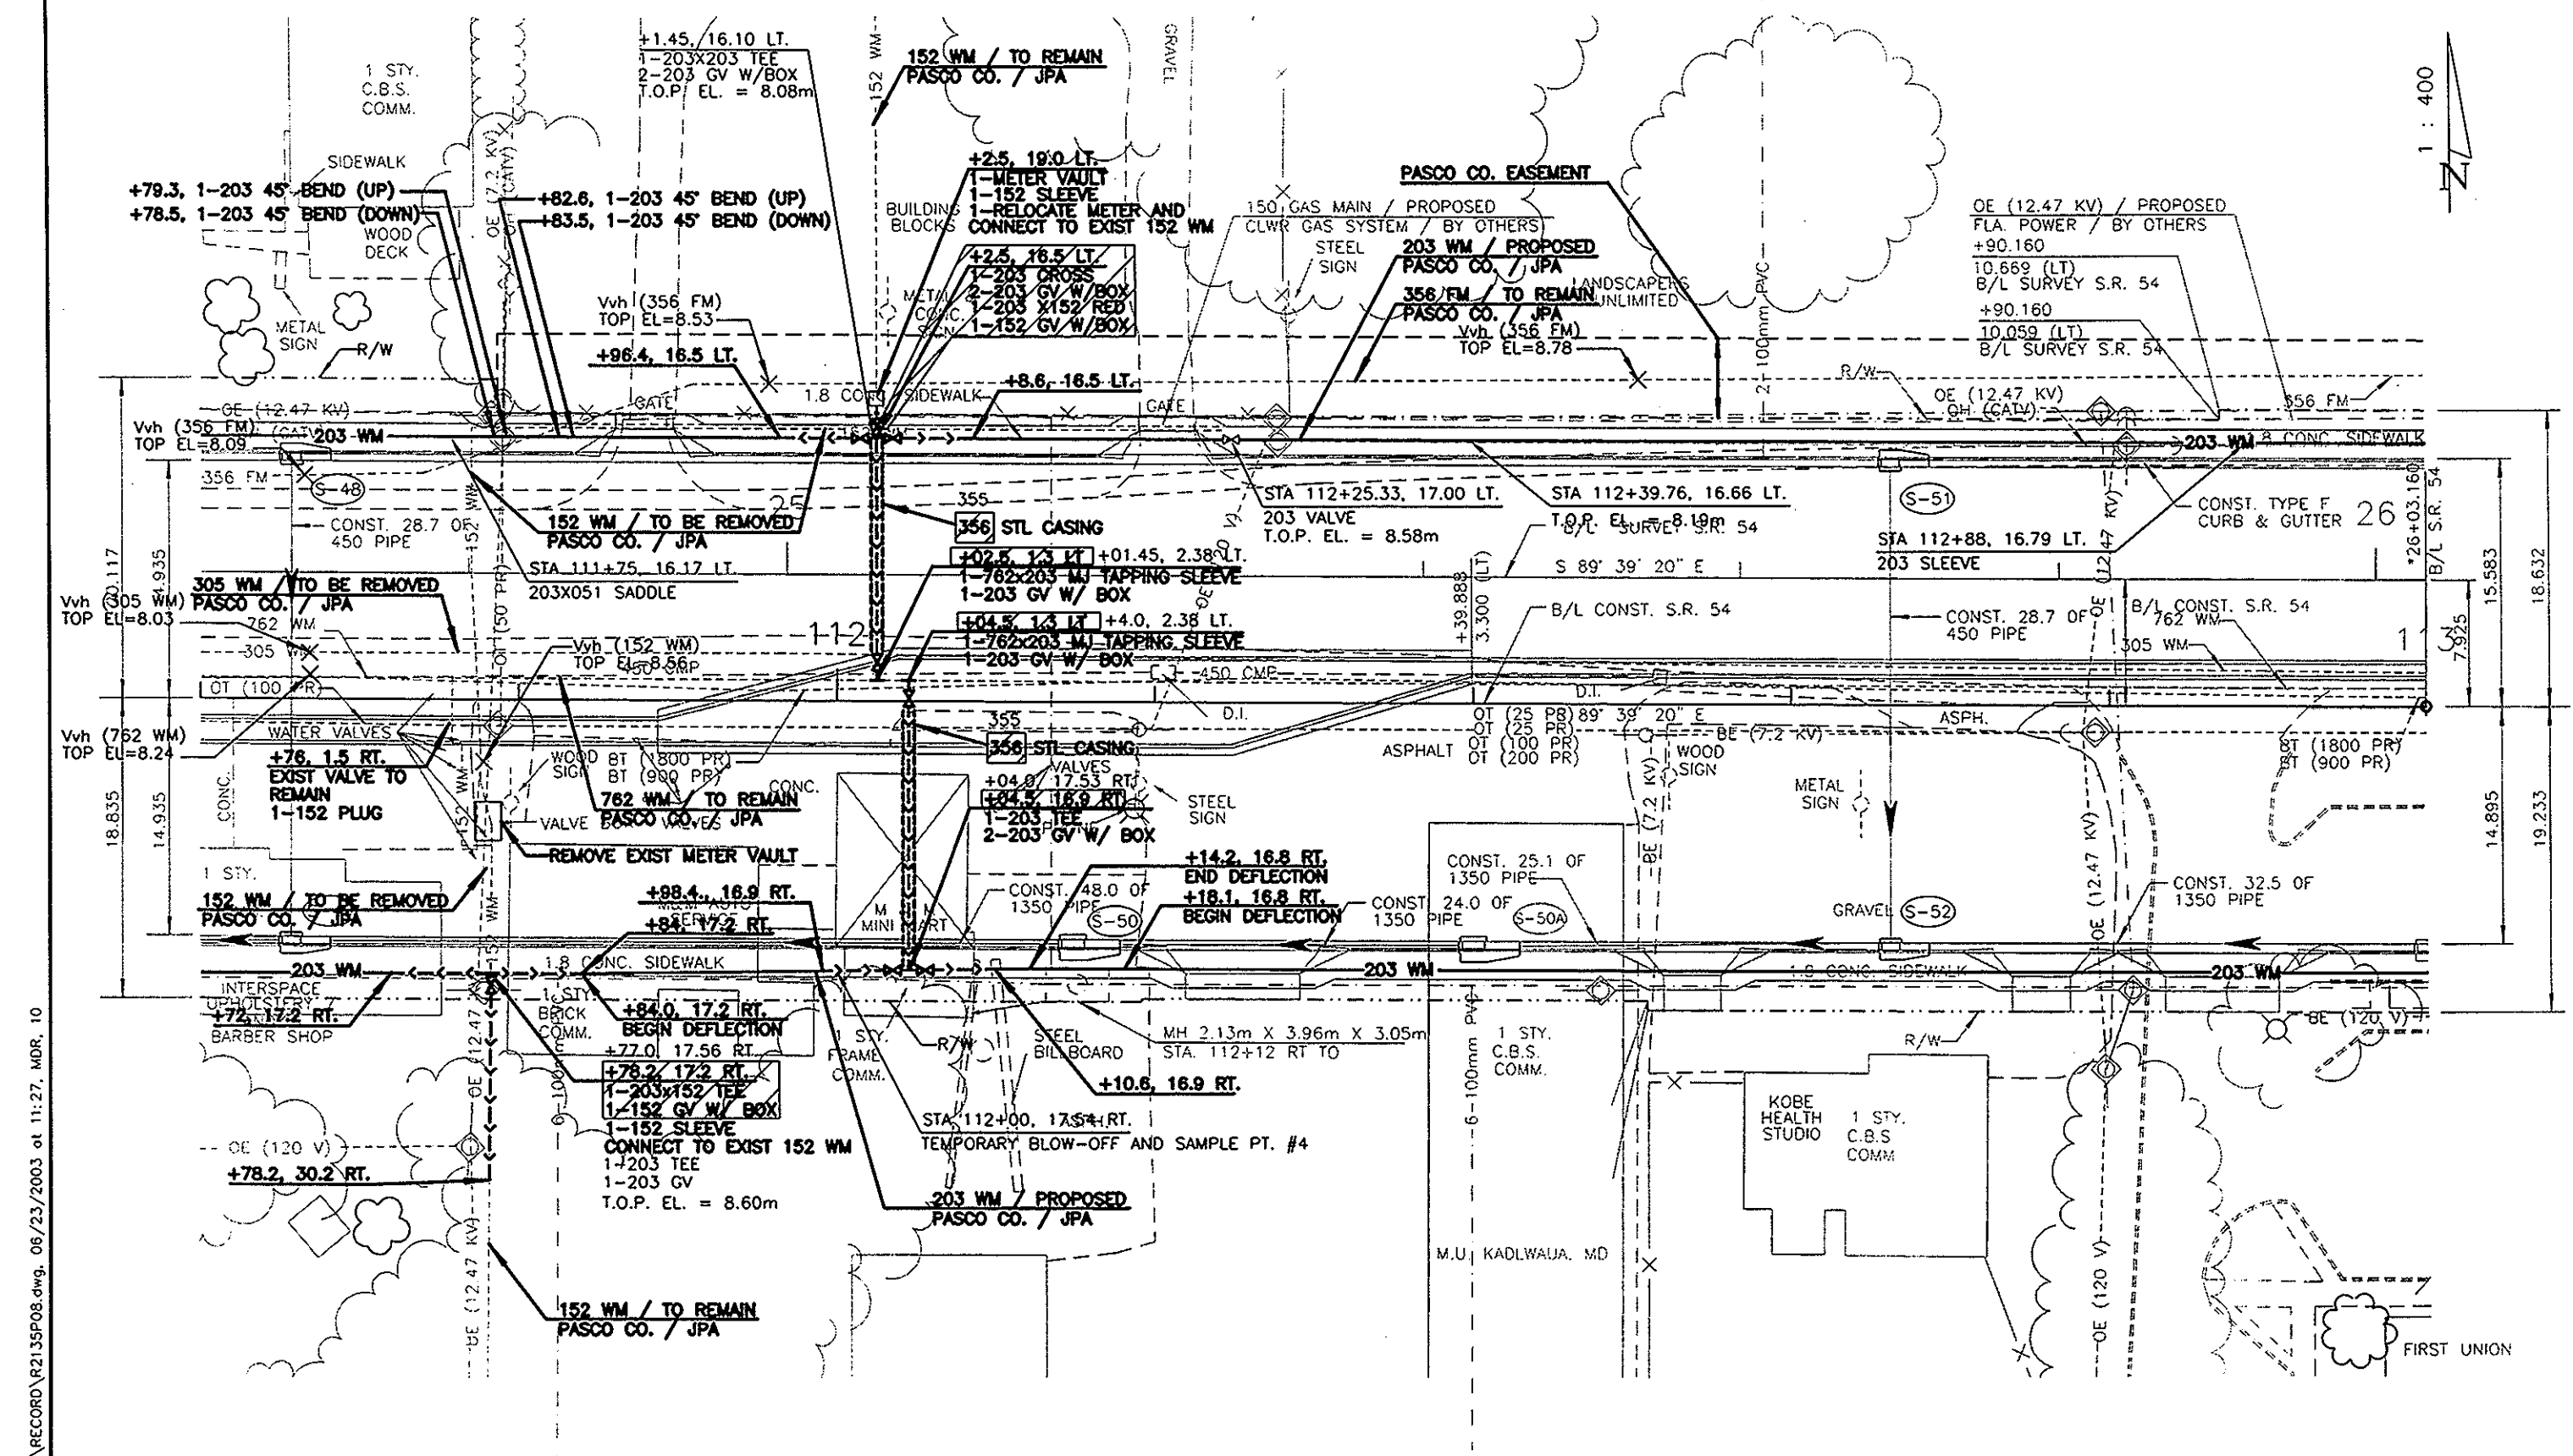



RECORD DRAWING - 06/03

REVISIONS				REVISIONS				REVISIONS			
DATE	BY	DESCRIPTION	DATE	BY	DESCRIPTION	DATE	BY	DESCRIPTION	DATE	BY	DESCRIPTION
06/03	JSE	RECORD DRAWING (SEE NOTES ON TITLE SHEET)	11/00	JSE	RELEASED FOR BIDDING/CONSTRUCTION						
11/00	JSE	RELEASED FOR BIDDING/CONSTRUCTION									

DESIGNED	J. BURBY	2/98	CHECKED	D. BURNHAM	2/98
REVIEWED	J. LOWE	11/00	CHECKED	F. DESANTO	11/00
APPROVED BY: JEFFERY S. LOWE, P.E. REG No.: 52017					

Issue Certification	PASCO COUNTY UTILITIES CONSTRUCTION	STATE ROAD NO. 54 - US 19 TO MADISON	SHEET NO.
PARSONS ENGINEERING SCIENCE, INC.	7530 LITTLE ROAD	WATER & FORCE MAIN UTILITY ADJUSTMENTS	P-8
(813) 933-4650	Tampa, Florida	PLAN SHEET - STA 111+60 TO STA 113+00	

 

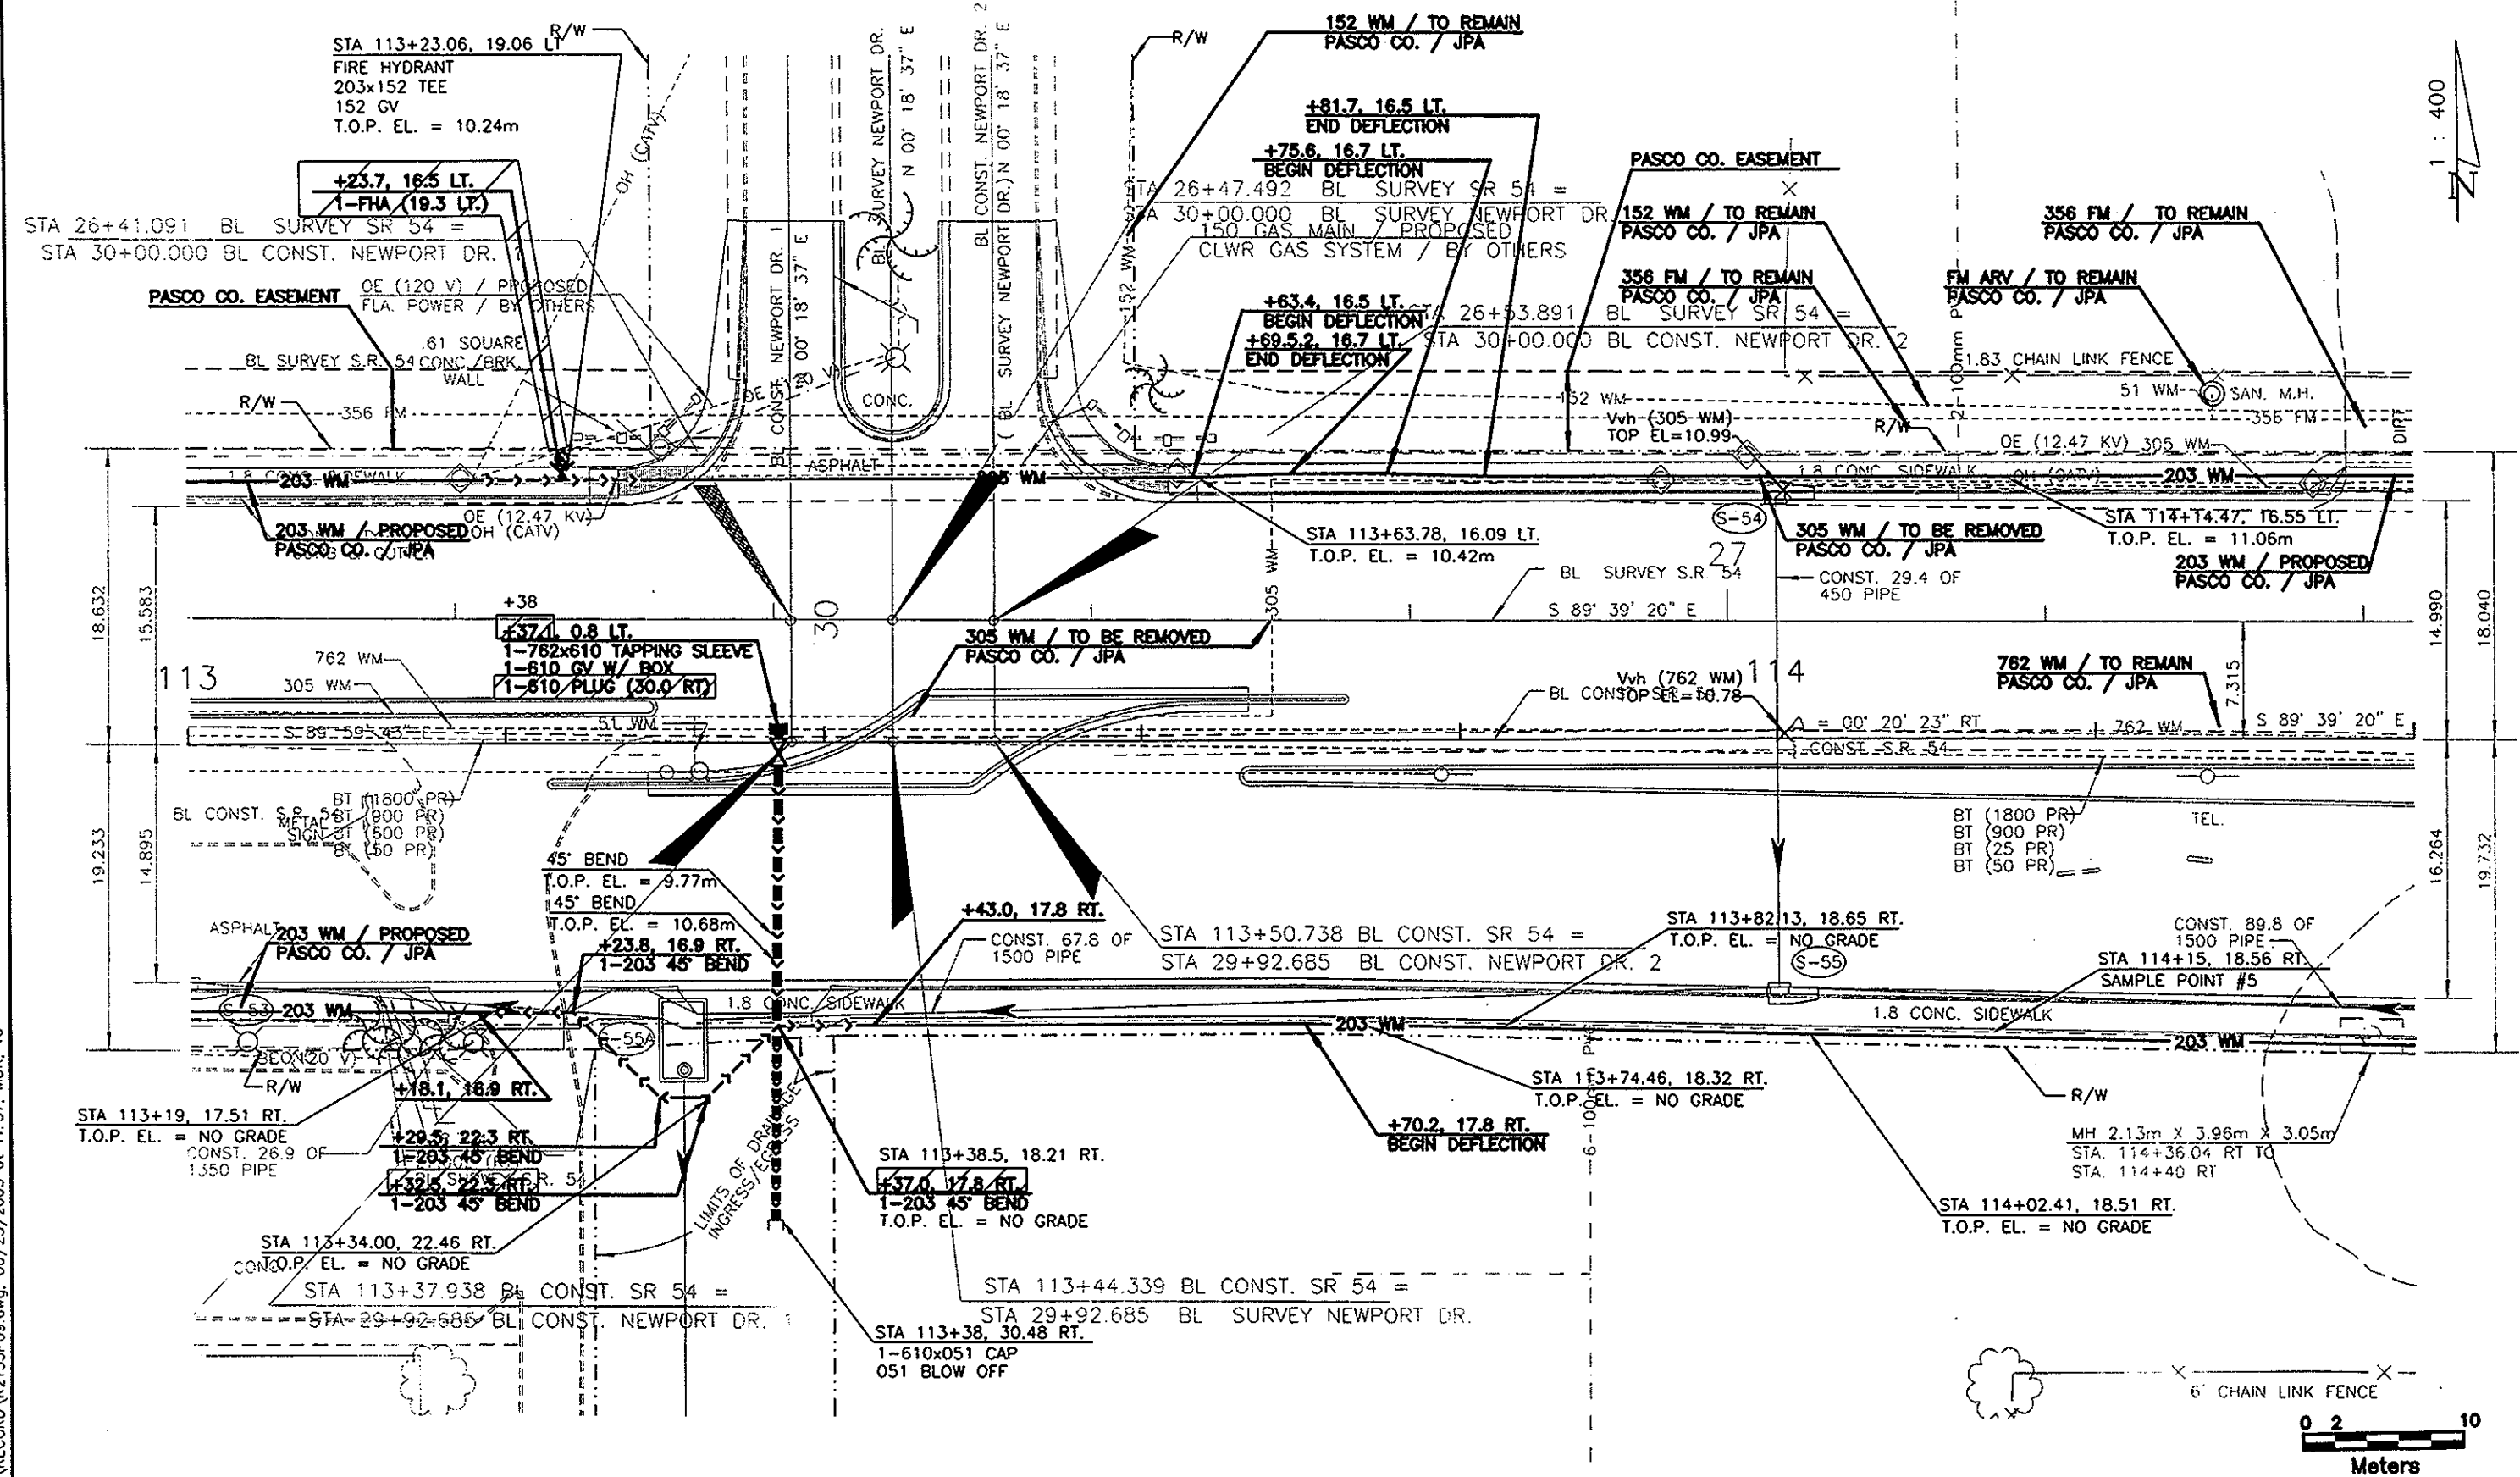

RECORD DRAWING - 06/03

NO. XREF: 06/03 06/03 11/00 JSL RELEASED FOR BIDDING/CONSTRUCTION

DATE	BY	DESCRIPTION	DATE	BY	DESCRIPTION	DATE	BY	DESCRIPTION
06/03	JSL	RECORD DRAWING (SEE NOTES ON TITLE SHEET)						
11/00	JSL	RELEASED FOR BIDDING/CONSTRUCTION						

DATE	NAME	DATE	NAME	DATE	NAME
06/03	J. DUREY	2/08	D. BURNHAM	2/08	
11/00	J. LOWE	11/00	F. DeSANTO	11/00	

APPROVED BY: JEFFERY S. LOWE, P.E. REG No: 52017

PARSONS ENGINEERING, INC.
7530 LITTLE ROAD
NEWPORT RICHEY,
FLORIDA 34654



PASCO COUNTY
UTILITIES CONSTRUCTION
7530 LITTLE ROAD
NEWPORT RICHEY,
FLORIDA 34654

STATE ROAD NO. 54 - US 19 TO MADISON
WATER & FORCE MAIN UTILITY ADJUSTMENTS
PLAN SHEET - STA 113+00 TO STA 114+40

SHEET NO.
P-9

