


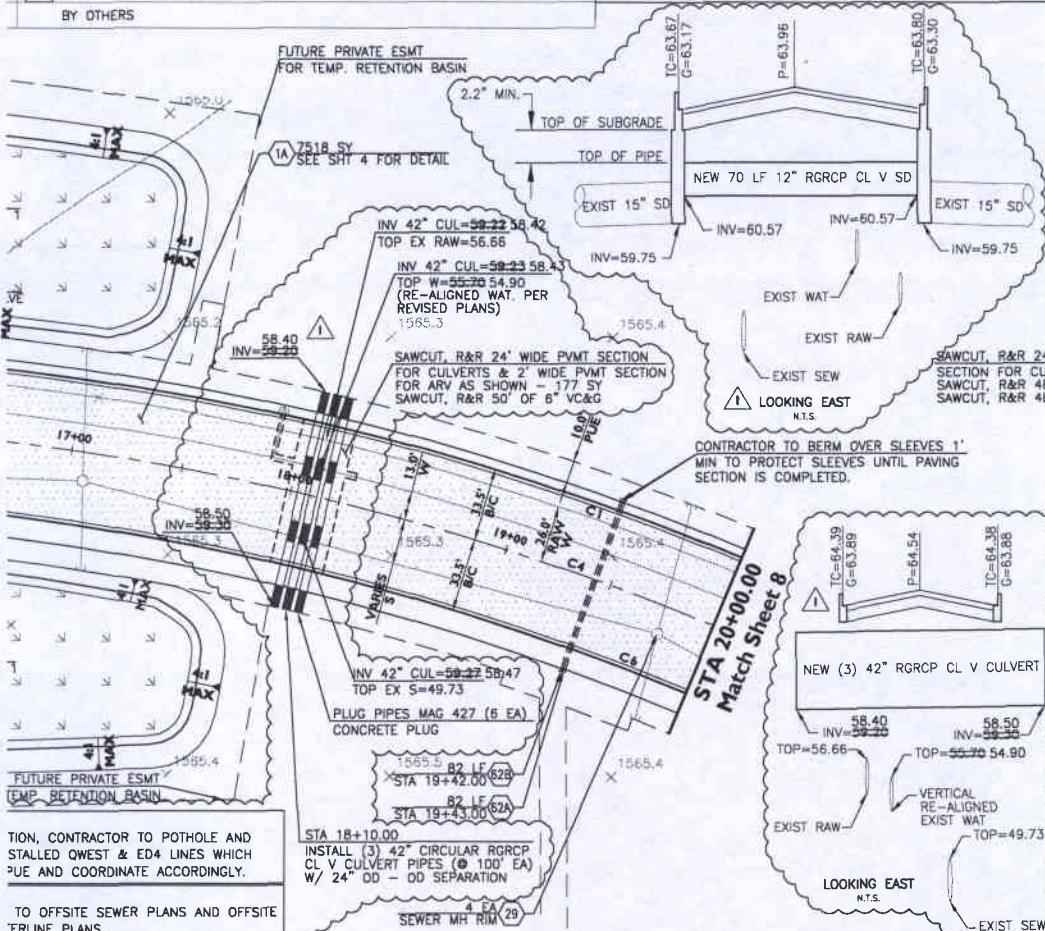
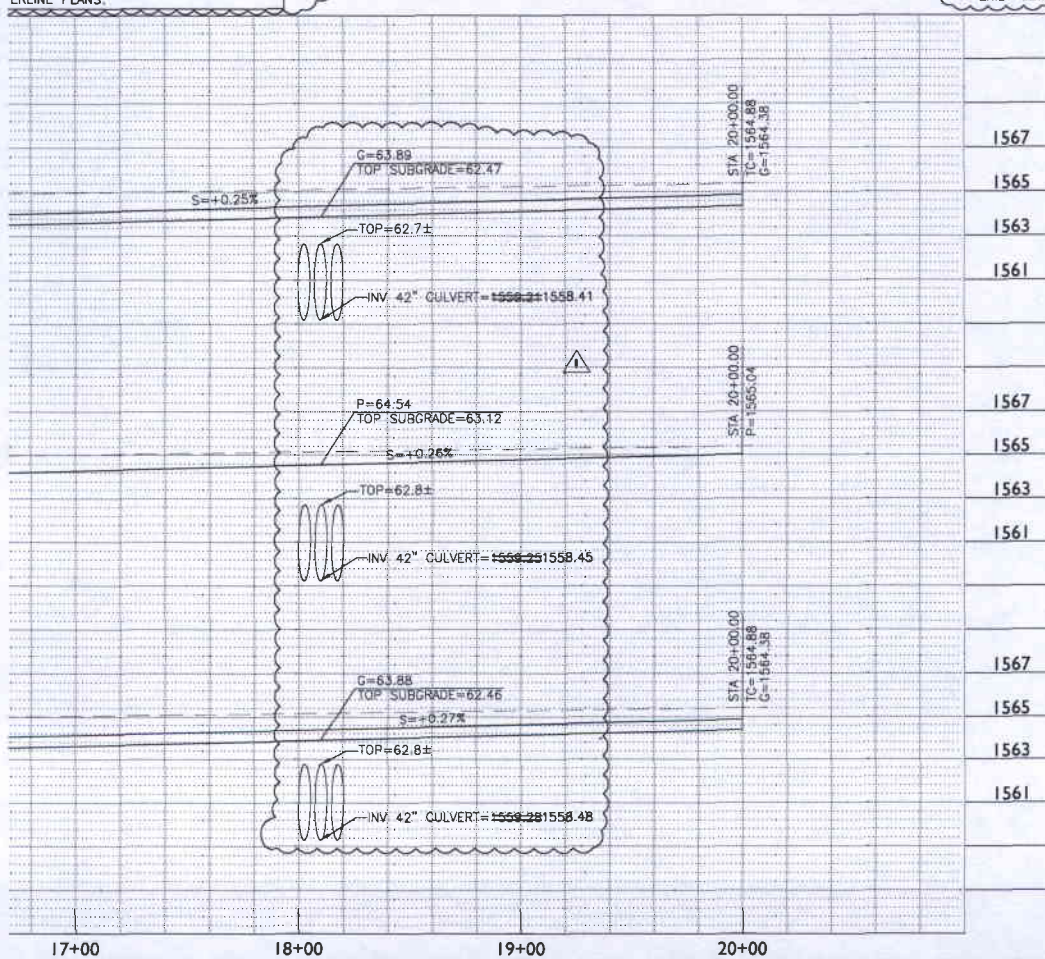


70A	15" RGRCP CL III STORM DRAIN	67 LF	NOTE:
76	CATCH BASIN MAG 534 (SINGLE)	2 EA	CONTRACTOR TO GRADE BOTH SIDES OF DATE ST. AS SHOWN ON CROSS SECTION DETAILS ON SHEETS 4 & 5 AND 5 RETENTION BASINS WHERE SHOWN. CONTRACTOR TO BUILD BERMS ALONG DATE ST. AS DIRECTED BY FARMER SO IRRIGATION CAN CONTINUE FOR FARMING ADJACENT FIELDS.
5	REMOVE EXIST CURB AND GUTTER	116 LF	
6	EXIST UTILITIES TO BE REMOVED, RELOCATED, OR BROUGHT TO GRADE BY OTHERS	NPI	

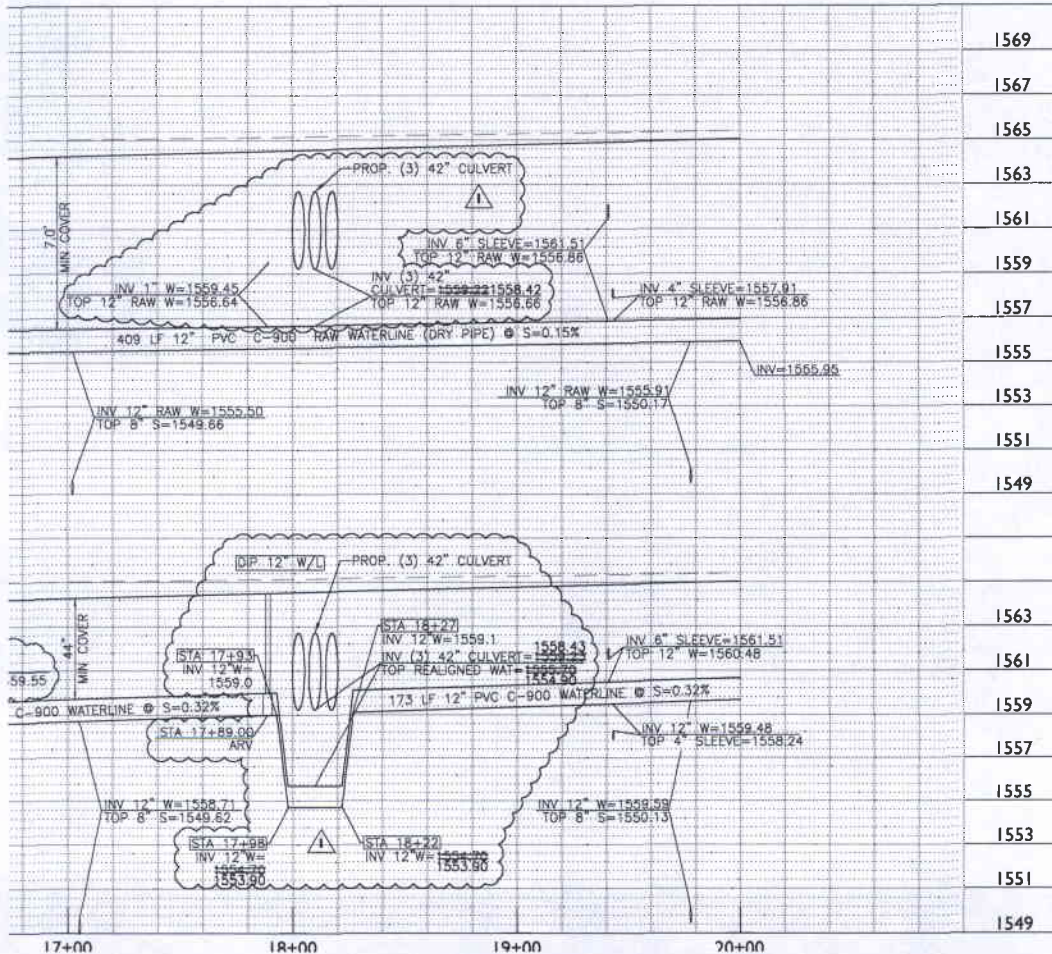

FIELD CHANGE TO OFFSITE ROADWAY PLANS FOR NATIONAL GYPSUM CO. (DATE STREET)
 SHEET 7 OF 15 DELTA REVISION #1 DATED 11-20-08
 NEW ELEVATION SHOWN HERE PREVAILS OVER ELEVATION WHICH IS CROSSED OUT
 THESE CHANGES SHOULD BE REFLECTED IN THE AS-BUILT PLANS

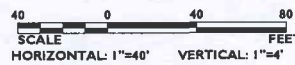

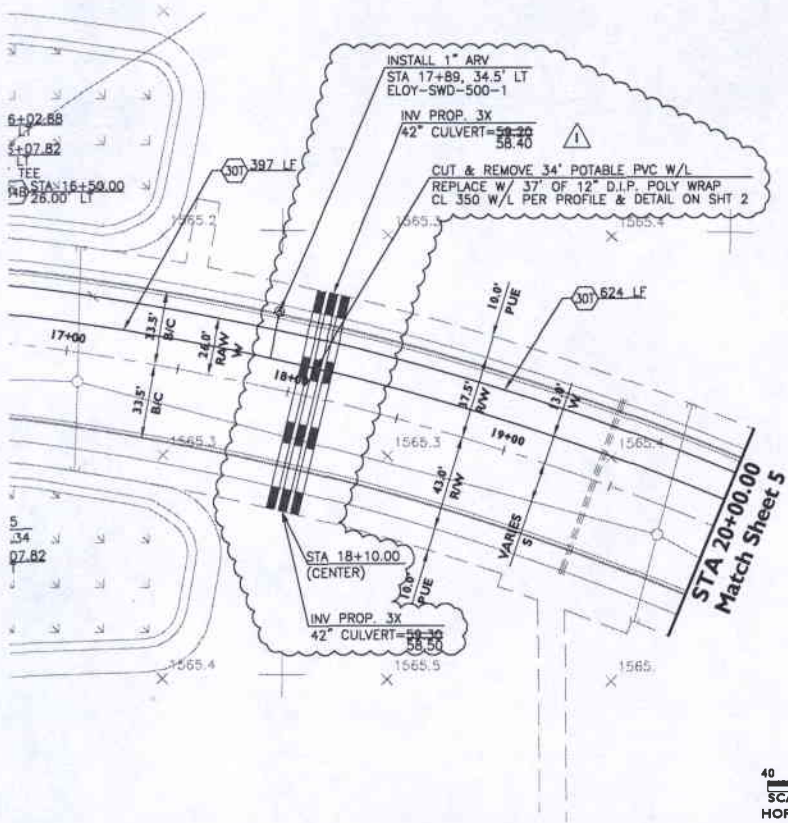

FIELD CHANGE TO OFFSITE POTABLE & RAW WATERLINE PLANS FOR NATIONAL GYPSUM CO.
 SHEET 4 OF 15 DELTA REVISION #1 DATED 11-20-08
 NEW ELEVATIONS SHOWN HERE PREVAIL OVER ELEVATIONS WHICH IS CROSSED OUT
 THESE CHANGES SHOULD BE REFLECTED IN THE AS-BUILT PLANS
 (DATE STREET)