


KEY PLAN



North

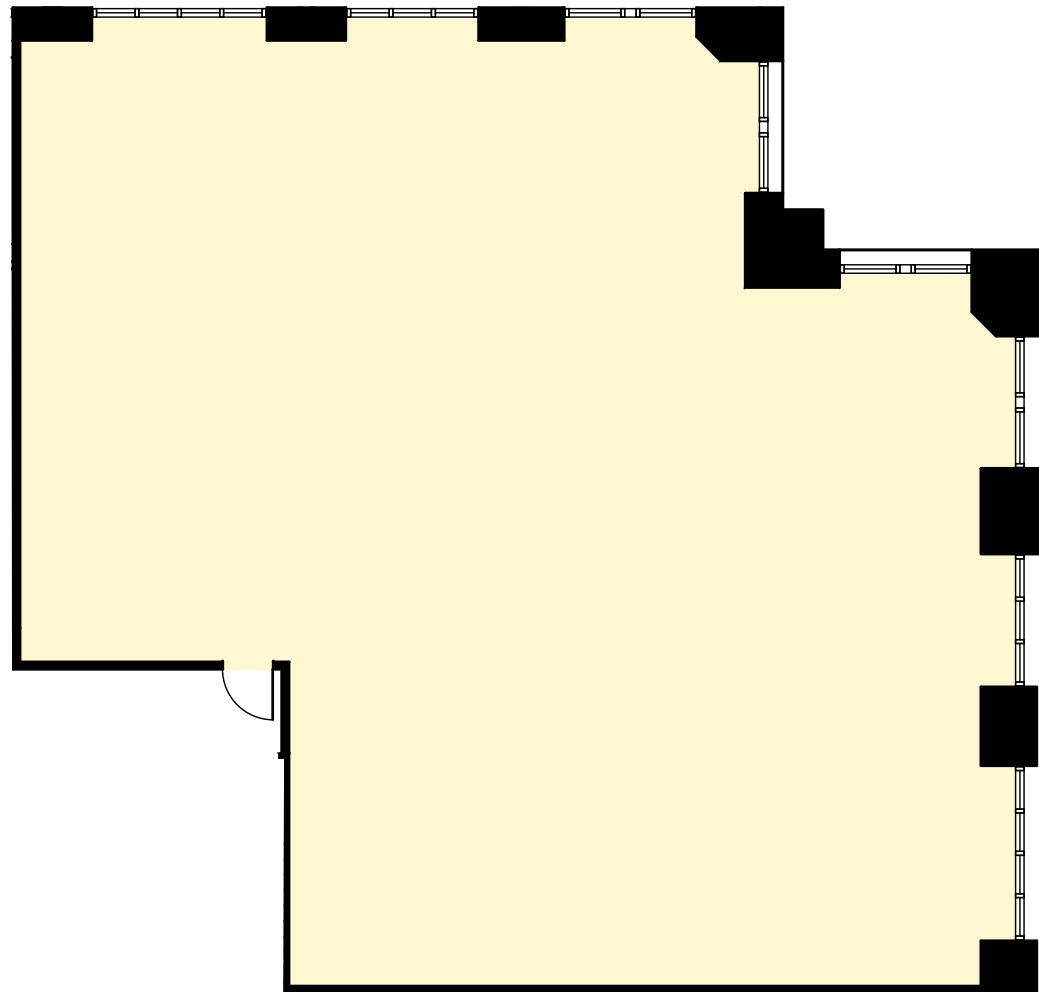

**NELSON** 191 Peachtree • Suite 1010 • 3,534 RSF

**As-Built**