
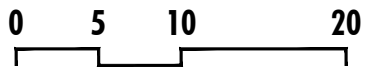


KEY PLAN

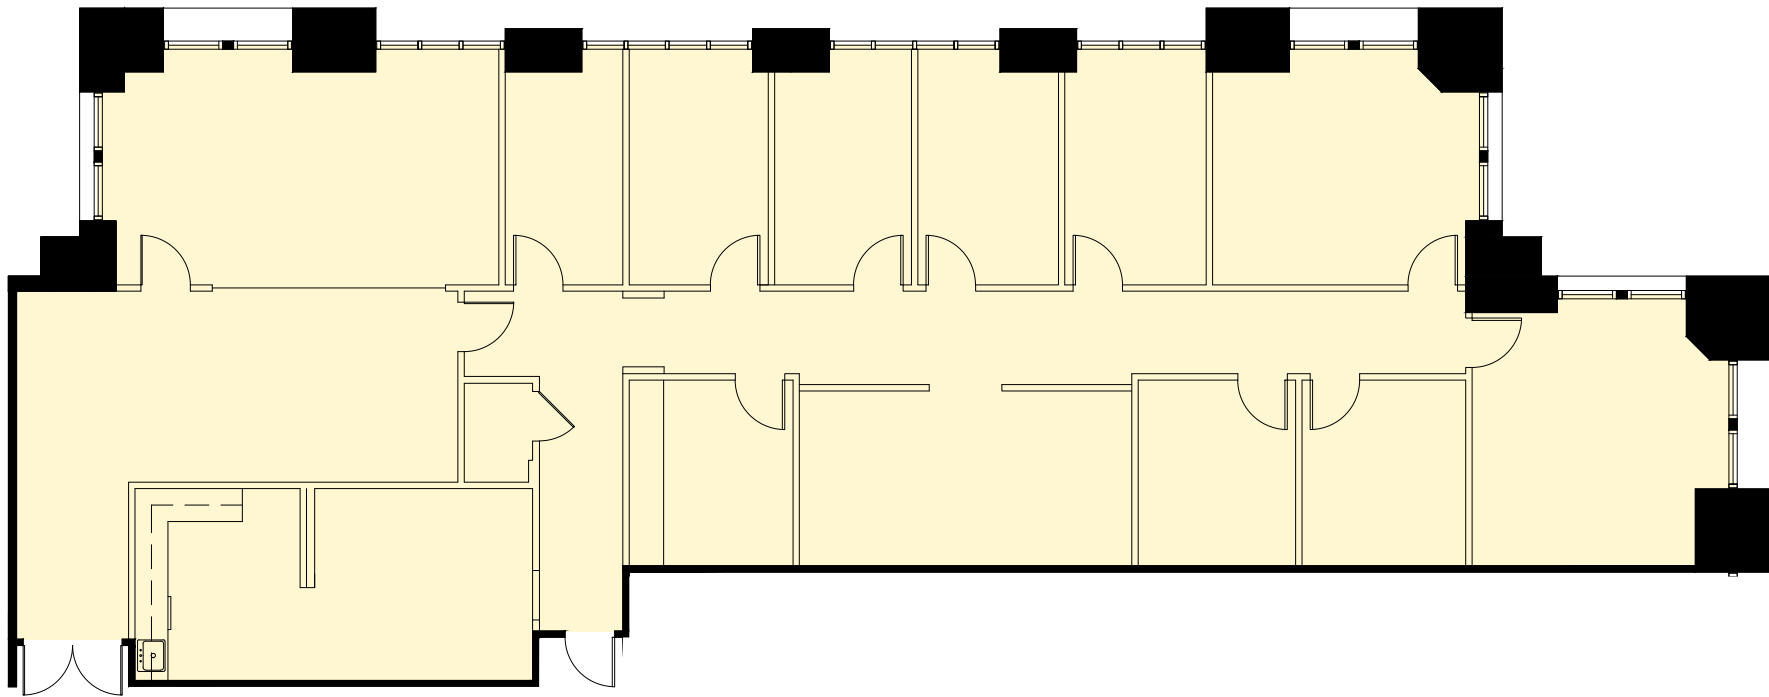

NELSON 191 Peachtree • Suite 3825 • 3,853 RSF

As-Built