


KEY PLAN



North

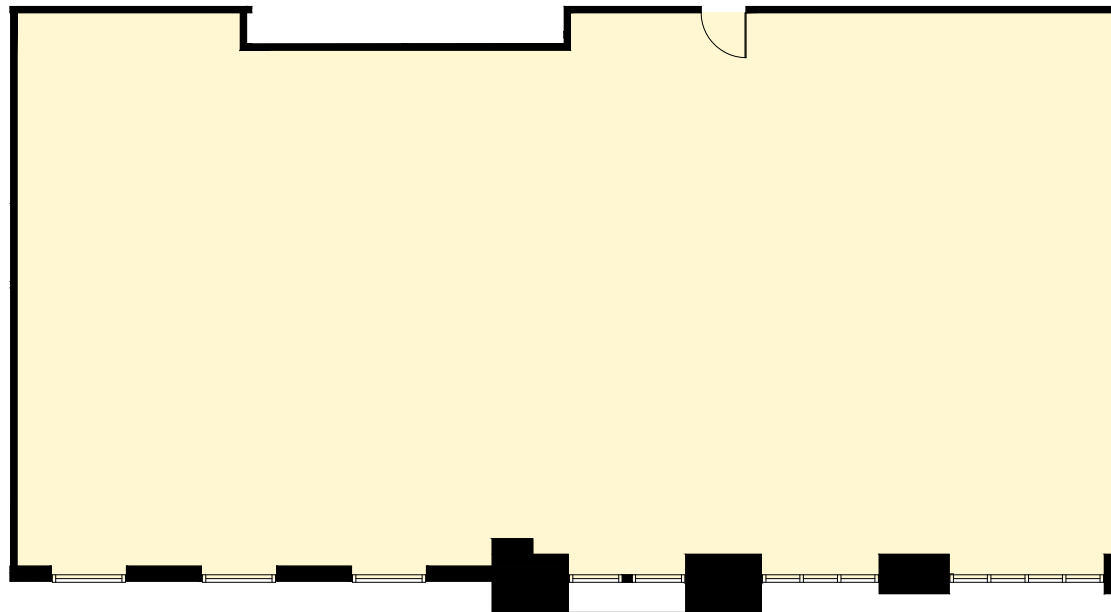

CUSHMAN &
WAKEFIELD

NELSON 191 Peachtree • Suite 725 • 3,302 RSF

As-Built