


KEY PLAN

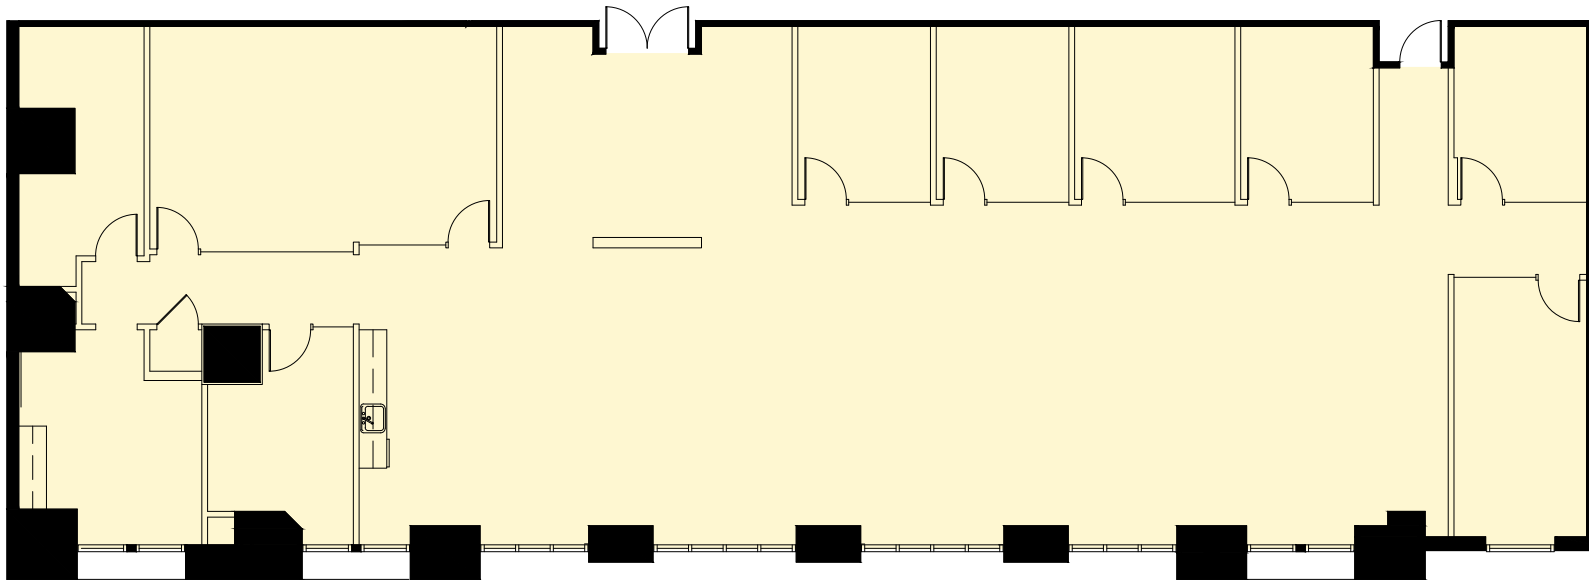

NELSON 191 Peachtree • Suite 750 • 5,059 RSF

As-Built