



AA26003596

CLIENT

VIVO GROUP

PROJECT

MR. GREEN'S WAREHOUSE AS-BUILT

SHEET

GROUND FLOOR

CONSULTANT

REVISIONS


SEAL

DATE


DATE

SHEET NUMBER

A101

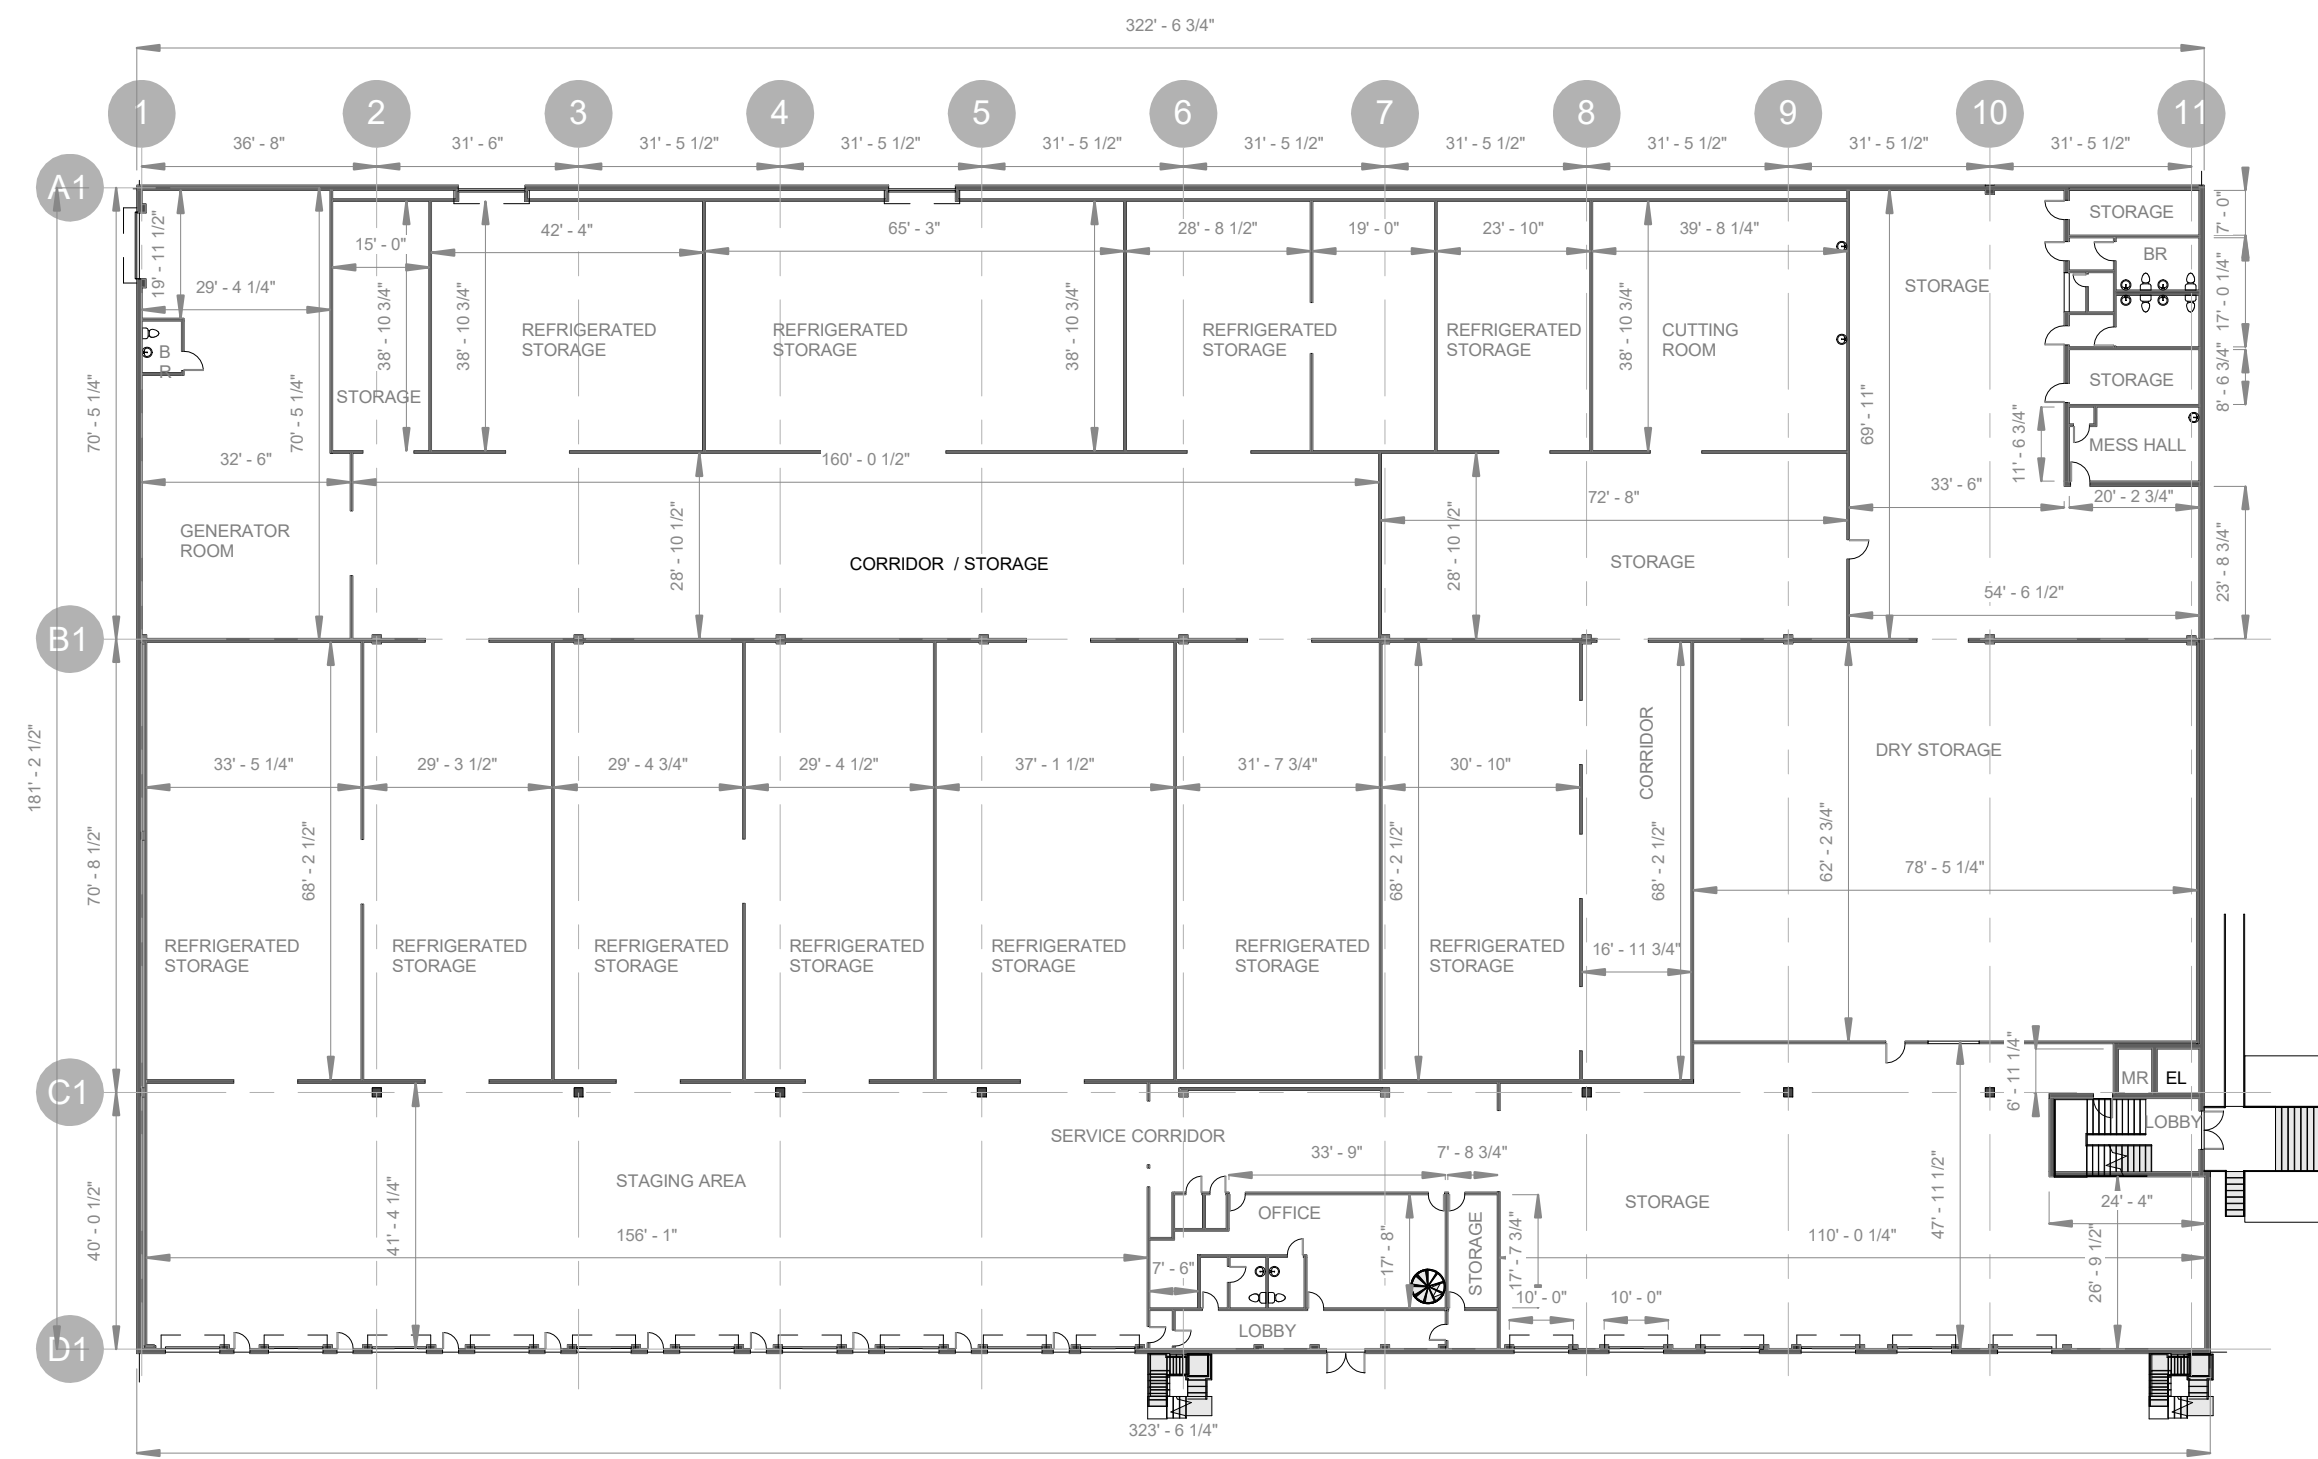


1 01 - GROUND FLOOR  
1" = 30'-0"

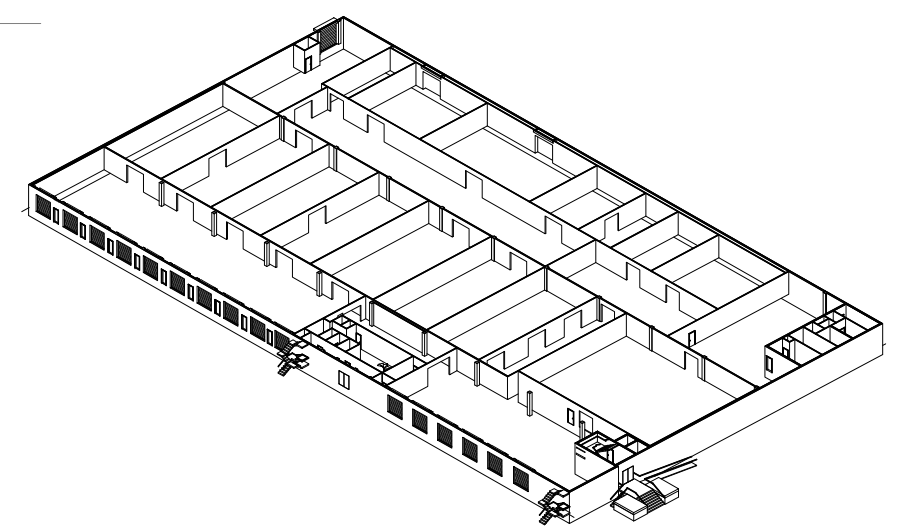


AREA - SORTED BY USE

Name	Area
OFFICE	6257.58 SF
WAREHOUSE	58317.91 SF
	64575.49 SF

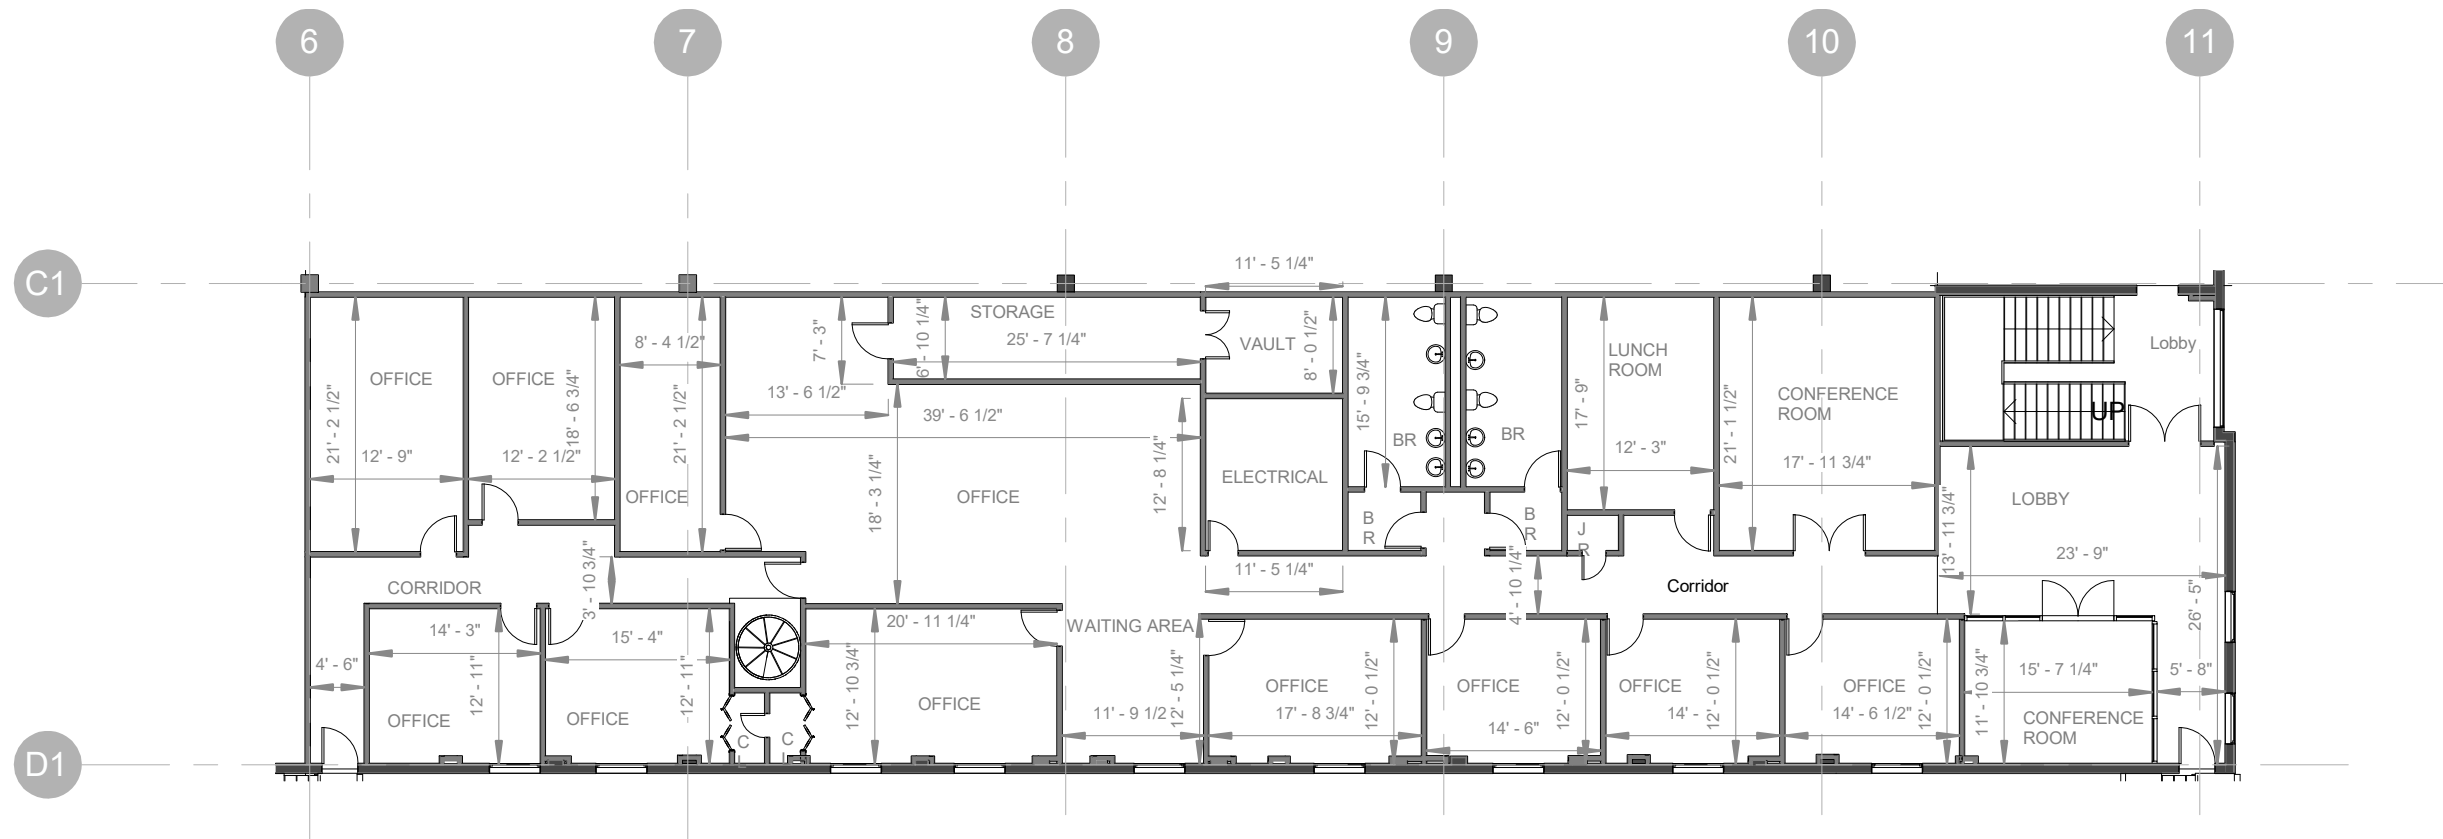

1 02 - 2ND FLOOR  
1/16" = 1'-0"

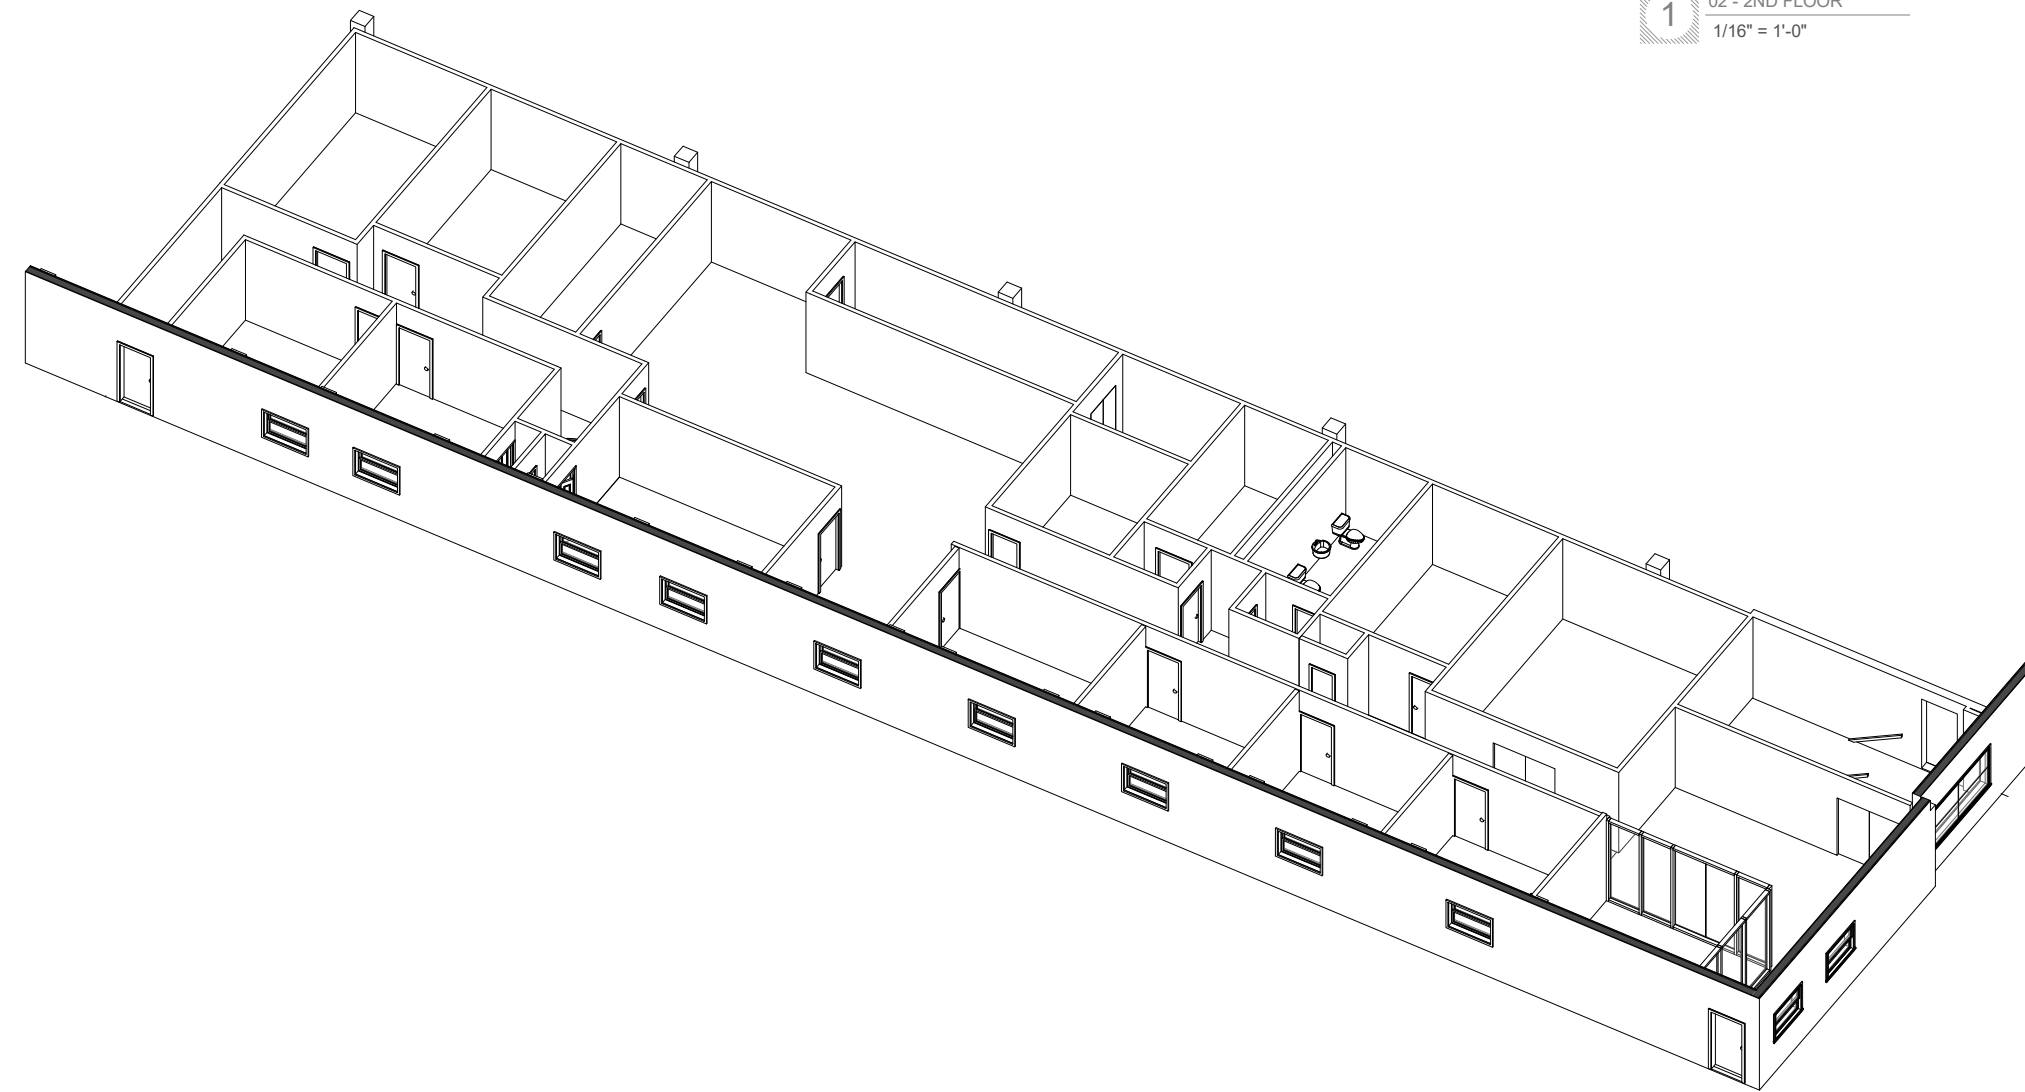

AA26003596

CLIENT

VIVO GROUP

PROJECT

MR. GREEN'S WAREHOUSE AS-BUILT

SHEET

2ND FLOOR

CONSULTANT

REVISIONS

SEAL



DATE

DATE

SHEET NUMBER

A102