



AA26003596

CLIENT

VIVO GROUP

PROJECT

MR. GREEN'S WAREHOUSE AS-BUILT

SHEET

SITE PLAN

CONSULTANT

REVISIONS


SEAL

DATE

DATE

SHEET NUMBER

A100

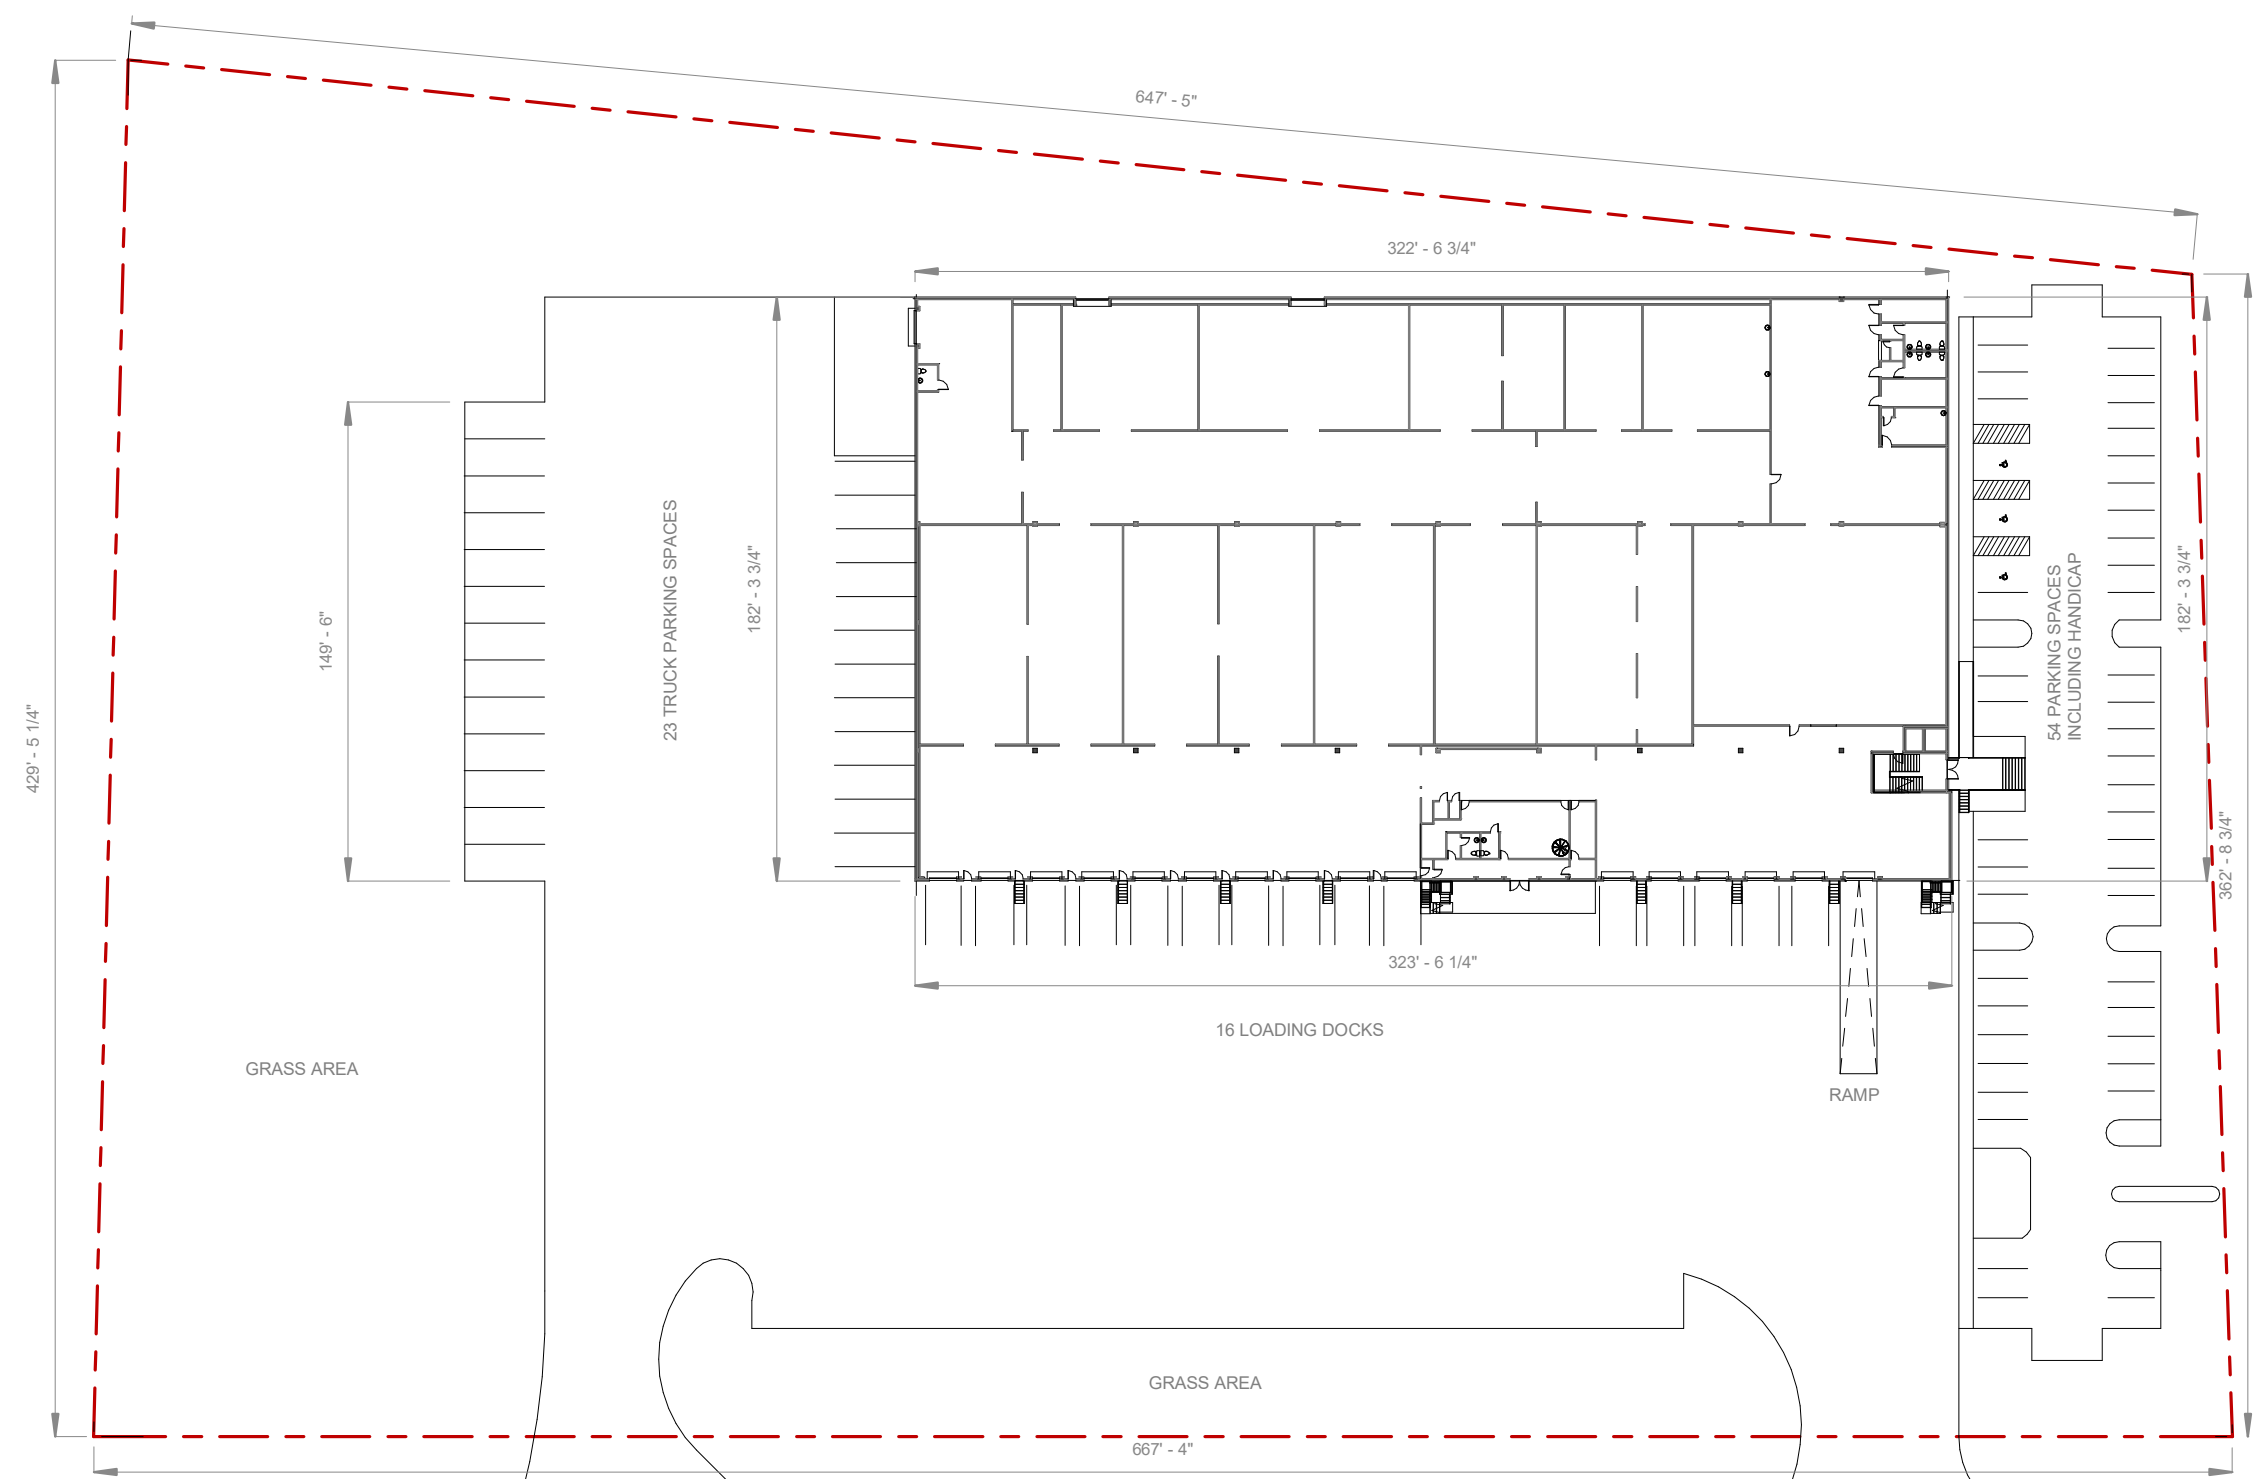

1 01 - SITE PLAN
1" = 60'-0"



AA26003596

CLIENT

VIVO GROUP

PROJECT

MR. GREEN'S WAREHOUSE AS-BUILT

SHEET

GROUND FLOOR

CONSULTANT

REVISIONS


SEAL

DATE


DATE

SHEET NUMBER

A101

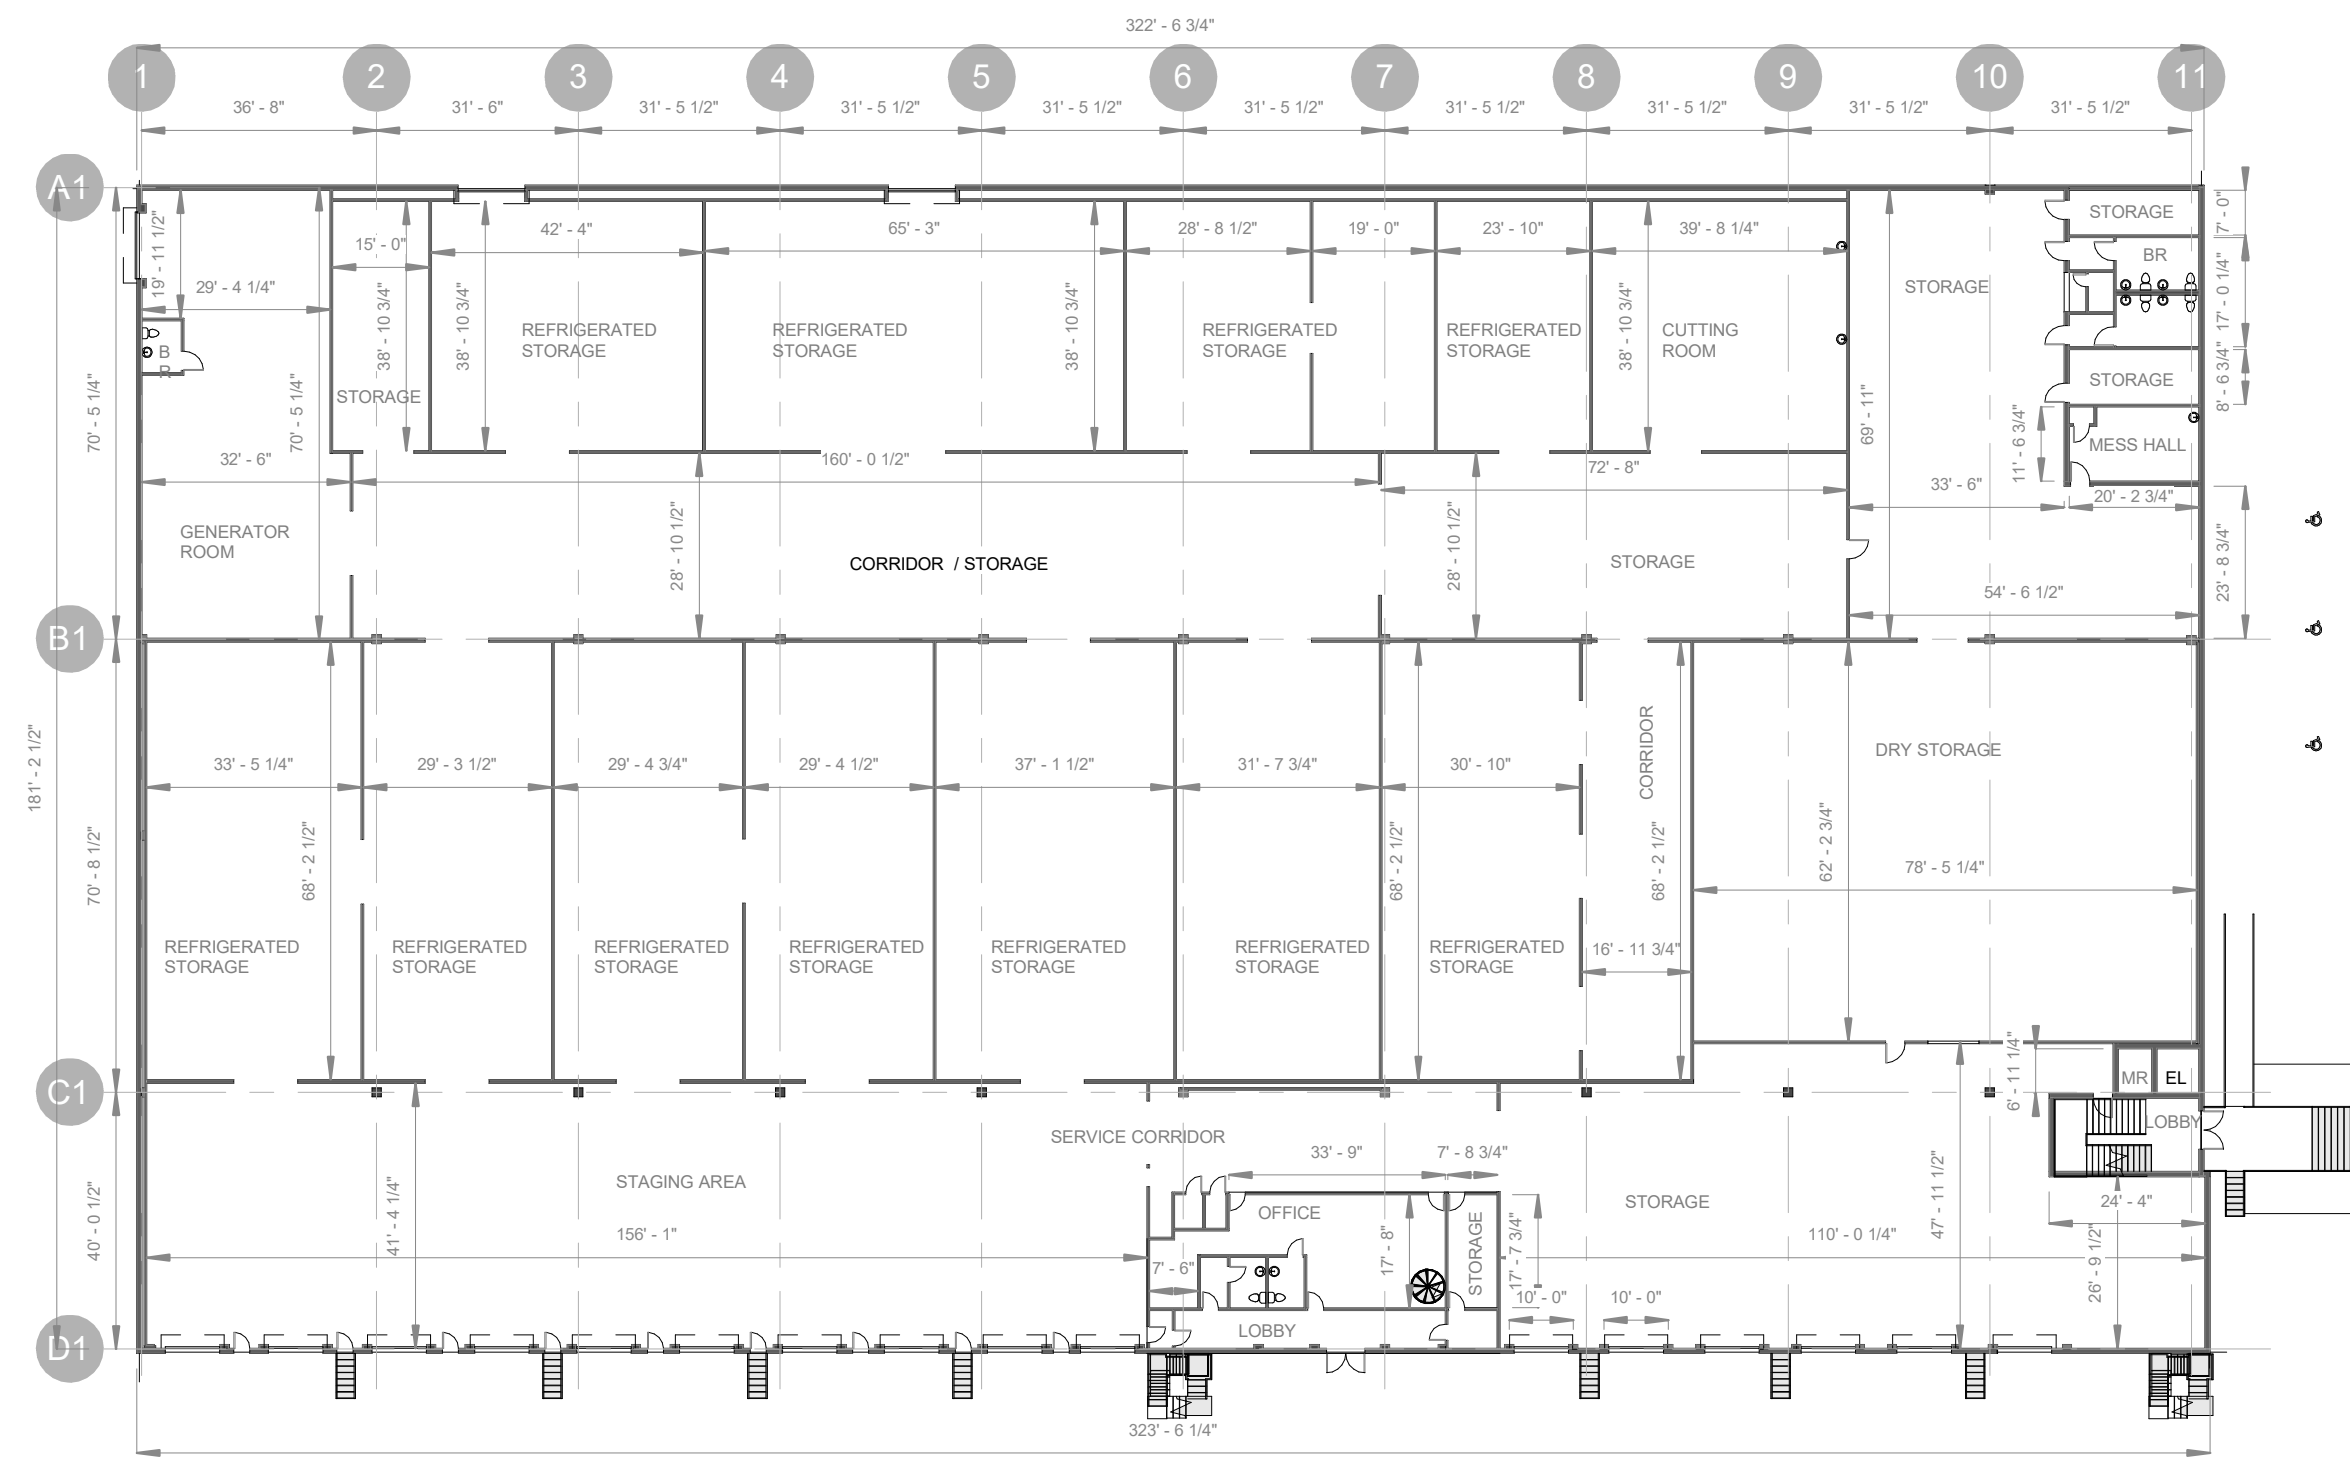

1 01 - GROUND FLOOR
1" = 30'-0"

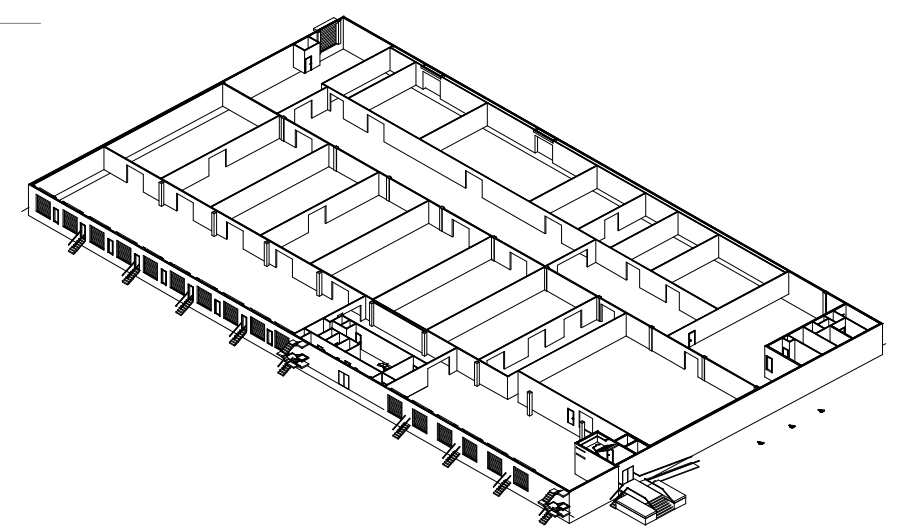

GROUND FLOOR AREA - SORTED BY USE

Name	Area
OFFICE	1288.14 SF
WAREHOUSE	57029.77 SF
	58317.91 SF



AA26003596

CLIENT

VIVO GROUP

PROJECT

MR. GREEN'S WAREHOUSE AS-BUILT

SHEET

2ND FLOOR

CONSULTANT

REVISIONS


SEAL

DATE

DATE

SHEET NUMBER

A102

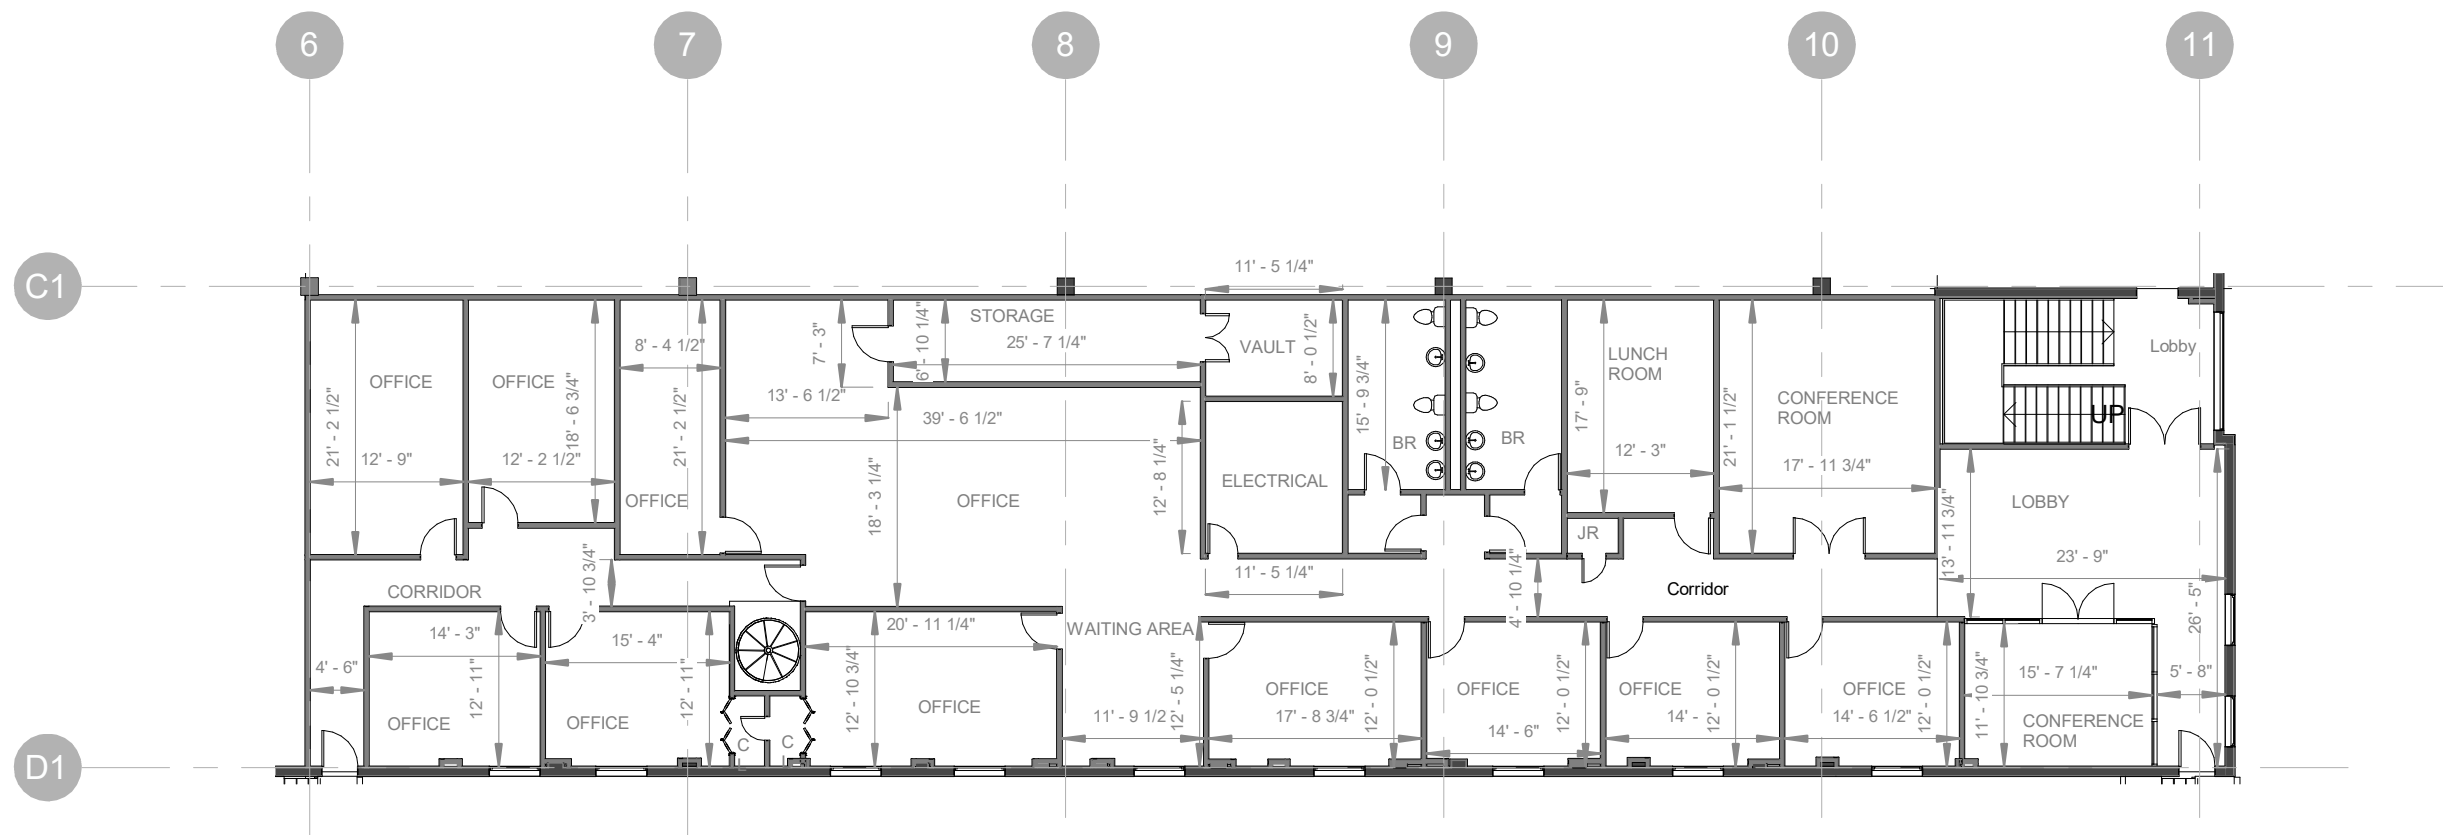

1 02 - 2ND FLOOR
1/16" = 1'-0"

LEVEL 02 AREA - SORTED BY USE

Name	Area
OFFICE	6257.58 SF
	6257.58 SF

