

Shelter Cove Development Site

71 Shelter Cove Lane Hilton Head Island, South Carolina 29928

Property Highlights

- Site is just over 3 acres located at the corner of Shelter Cove Lane and Highway 278 with amazing views of Broad Creek.
- Frontage on Highway 278 and interconnectivity to all the amenities including shops and restaurants located in Shelter Cove Towne Center and Shelter Cove Marina.
- Less than 1/2 mile on Shelter Cove Lane are the Plaza at Shelter Cove and Shelter Cove Towne Center offering Whole Foods, TJ Maxx, Hickory Tavern, World of Beer, Kroger and many more shops and restaurants.
- · Within 1.2 miles there is public beach access at Burkes Beach.
- · Access to bike paths to/from practically the entire island.
- Current owners have already invested approximately \$500,000 installing underground storm water retention and all utilities are to the site
- The site has great visibility and unique setting that would work well with retail, restaurant, hotel, medical or office development.


OFFERING SUMMARY			
Sale Price	\$4,450,000		
Lot Size	3.04 Acres		
Uses	Retail, Rest, Hotel, Medical, Office		
Zoning	Planned Development		
Utilities	On-Site		
Flood Zone	A7		
Storm Water	Sub Surface System in Place		

DEMOGRAPHICS				
Stats	Population	Avg. HH Income		
3 Miles	12,294	\$95,780		
5 Miles	29,717	\$98,592		
15 Miles	94,830	\$87,333		

For more information


1227 May River Road, Suite 100 Bluffton, SC 29910 843 837 4460 tel naicarolinacharter.com




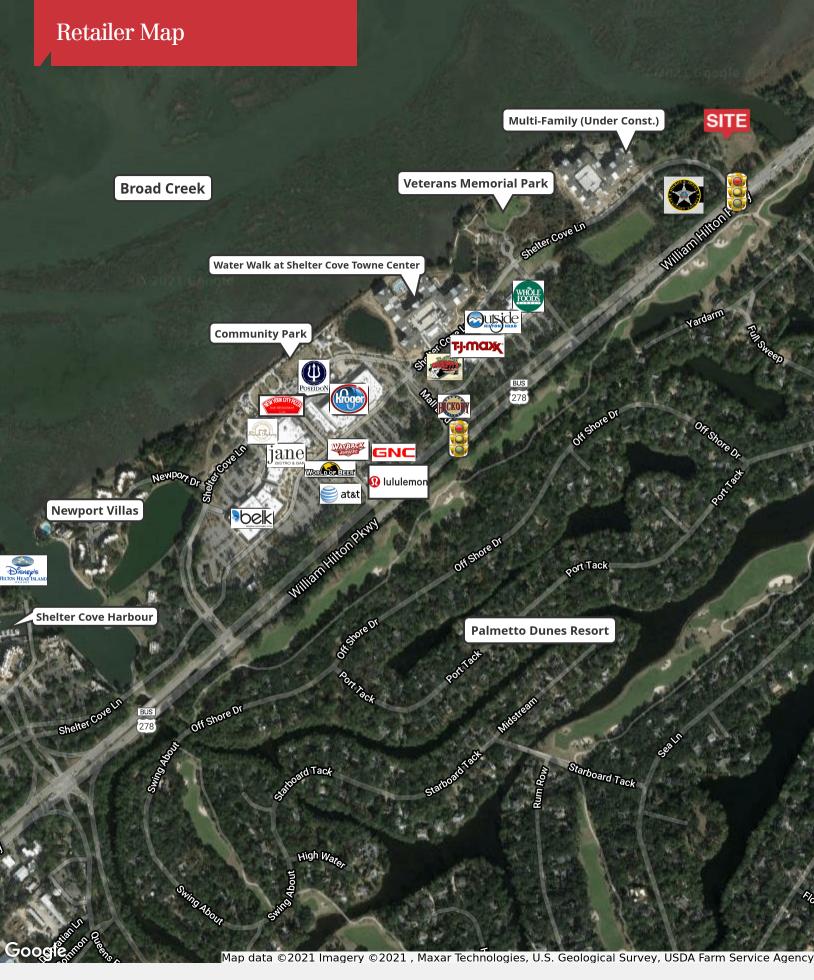




Baker Wilkins
0: 843 837 4460 x2
C: 843 247 2470
baker@naicarolinacharter.com

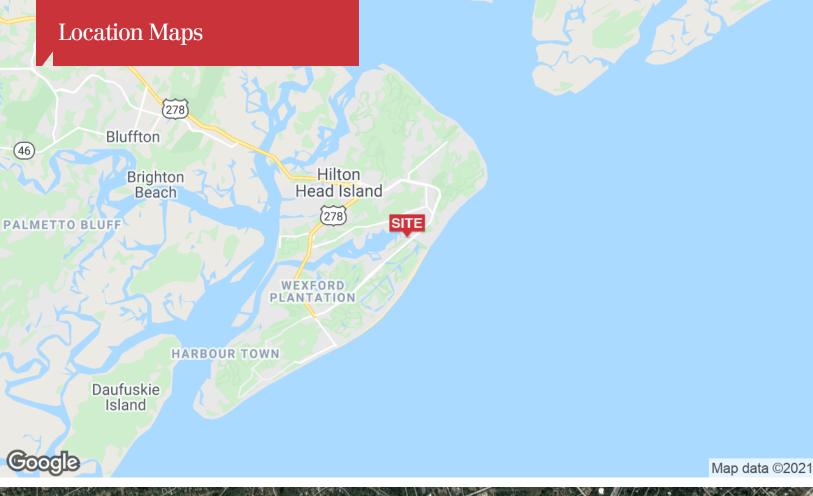

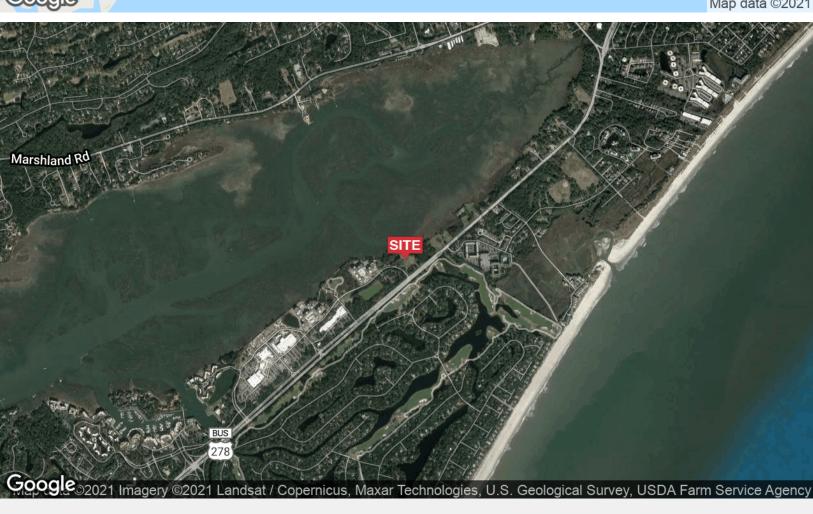





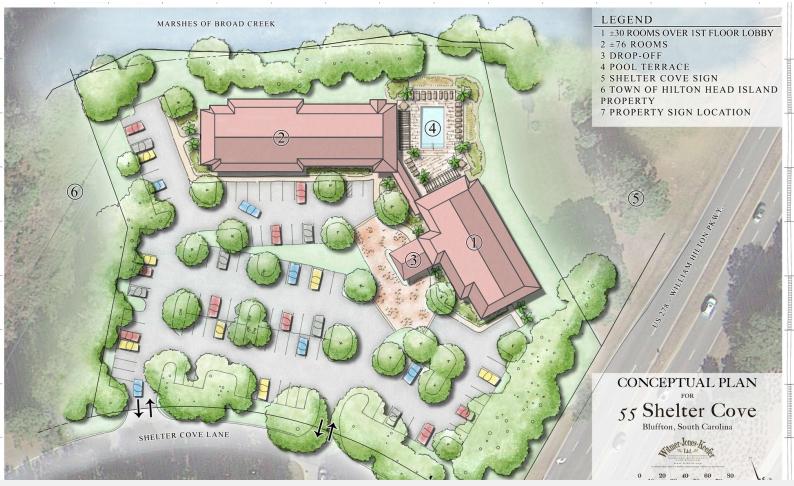



Baker Wilkins
O: 843 837 4460 x2
C: 843 247 2470
baker@naicarolinacharter.com









Baker Wilkins
O: 843 837 4460 x2
C: 843 247 2470
baker@naicarolinacharter.com

Utility Asbuilt Survey

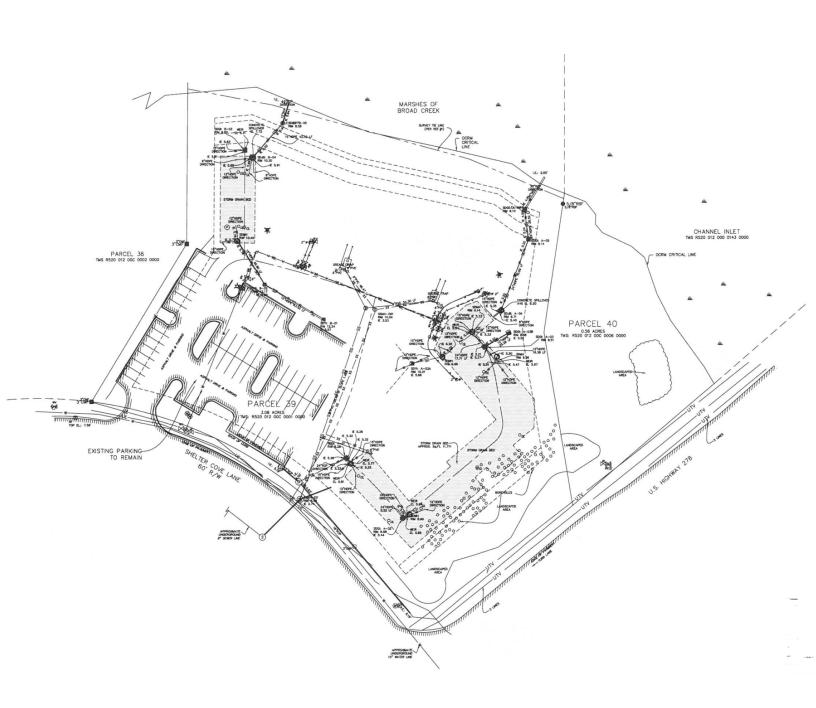




Survey Showing Sub-Surface Storm Water System

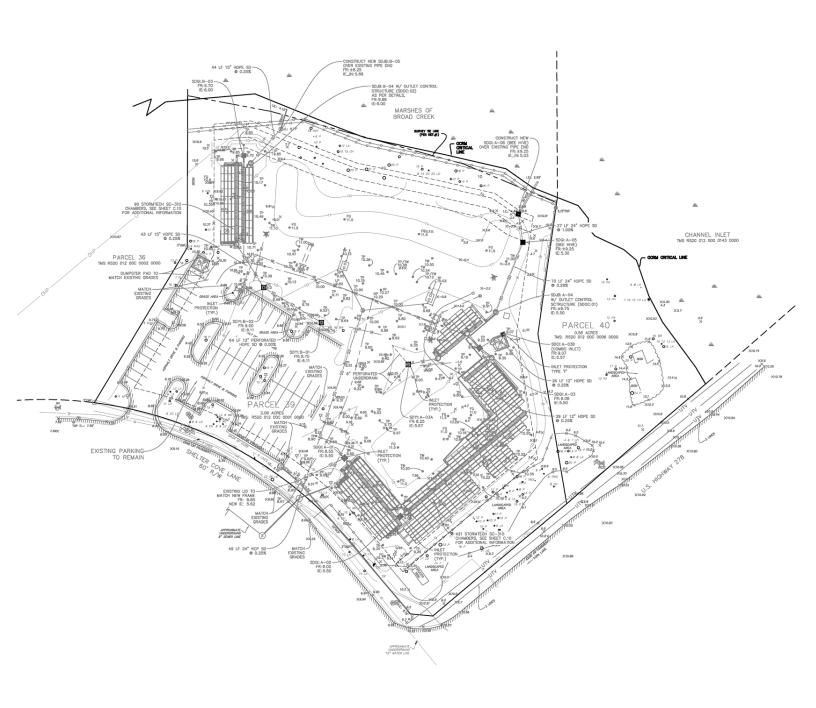



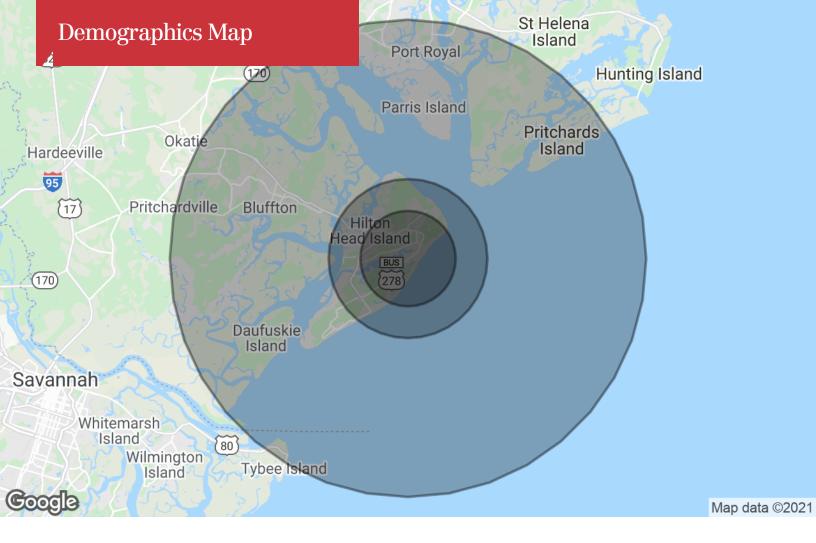

Population	3 Miles	5 Miles	15 Miles
TOTAL POPULATION	12,294	29,717	94,830
MEDIAN AGE	47.2	49.1	42.3
MEDIAN AGE (MALE)	46.6	48.5	41.7
MEDIAN AGE (FEMALE)	47.7	49.6	42.8
Households & Income	3 Miles	5 Miles	15 Miles
Households & Income TOTAL HOUSEHOLDS	3 Miles 5,261	5 Miles 13,362	15 Miles 38,620
TOTAL HOUSEHOLDS	5,261	13,362	38,620



^{*} Demographic data derived from 2010 US Census