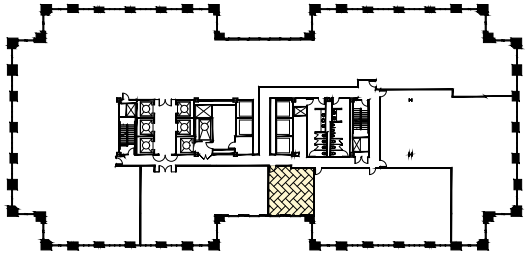

KEY PLAN

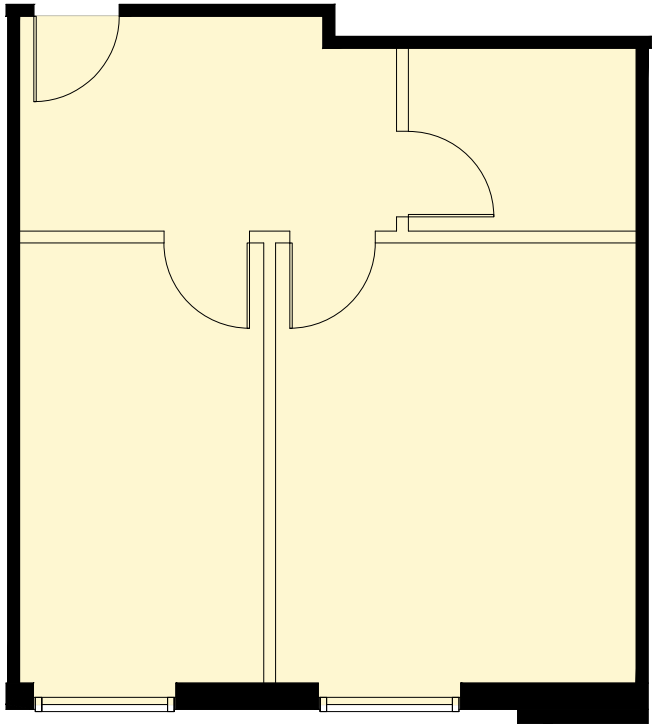

North

0 5 10 20

CUSHMAN & WAKEFIELD

NELSON

191 Peachtree • Suite 3960 • 615 RSF

As-Built

AB3960

12.04.2020