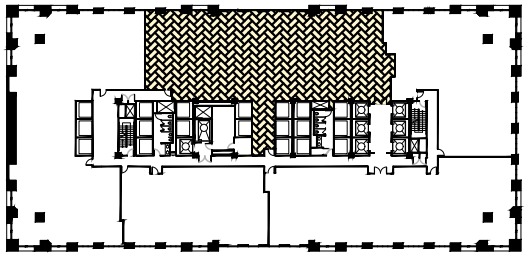

KEY PLAN

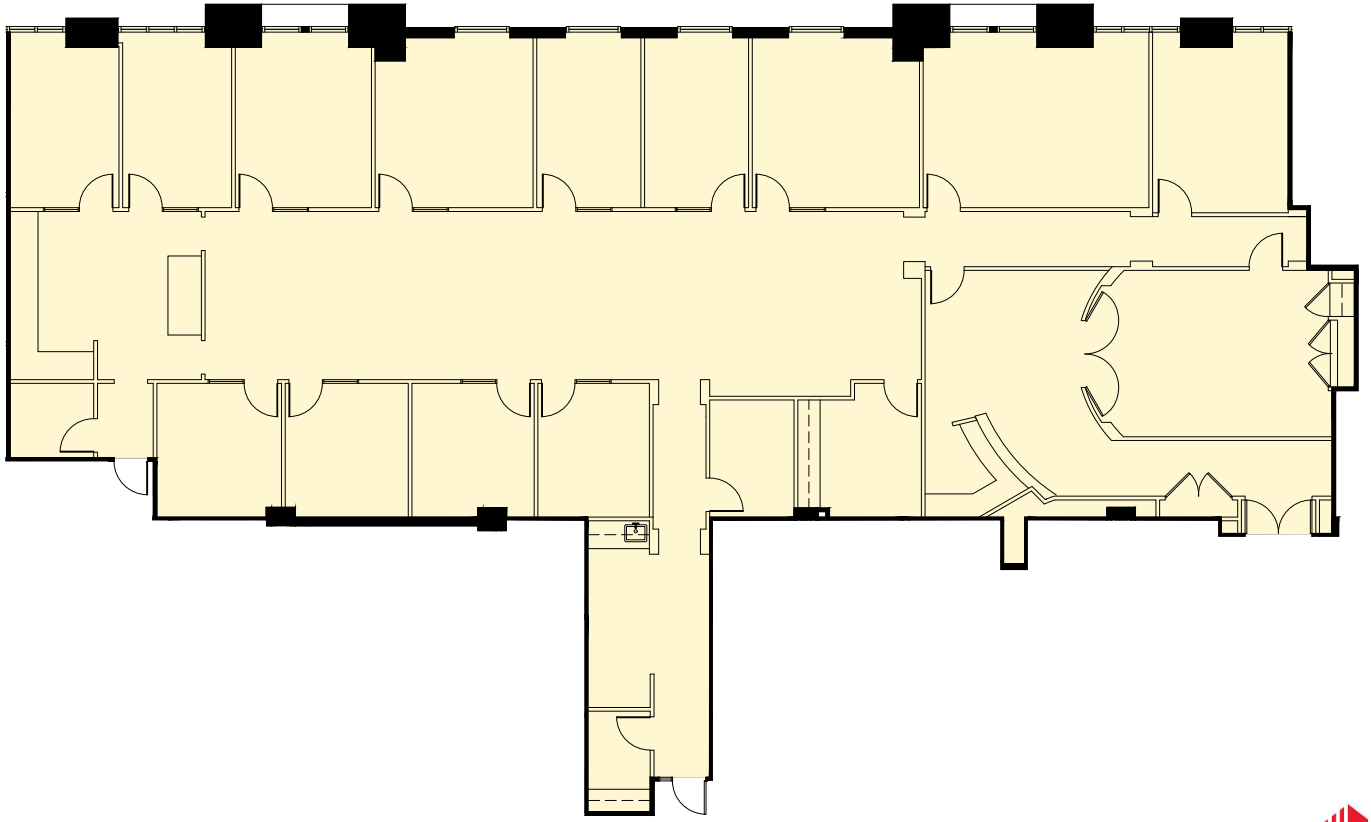

North

0 5 10 20

CUSHMAN & WAKEFIELD

NELSON

191 Peachtree • Suite 800 • 6,357 RSF

As-Built